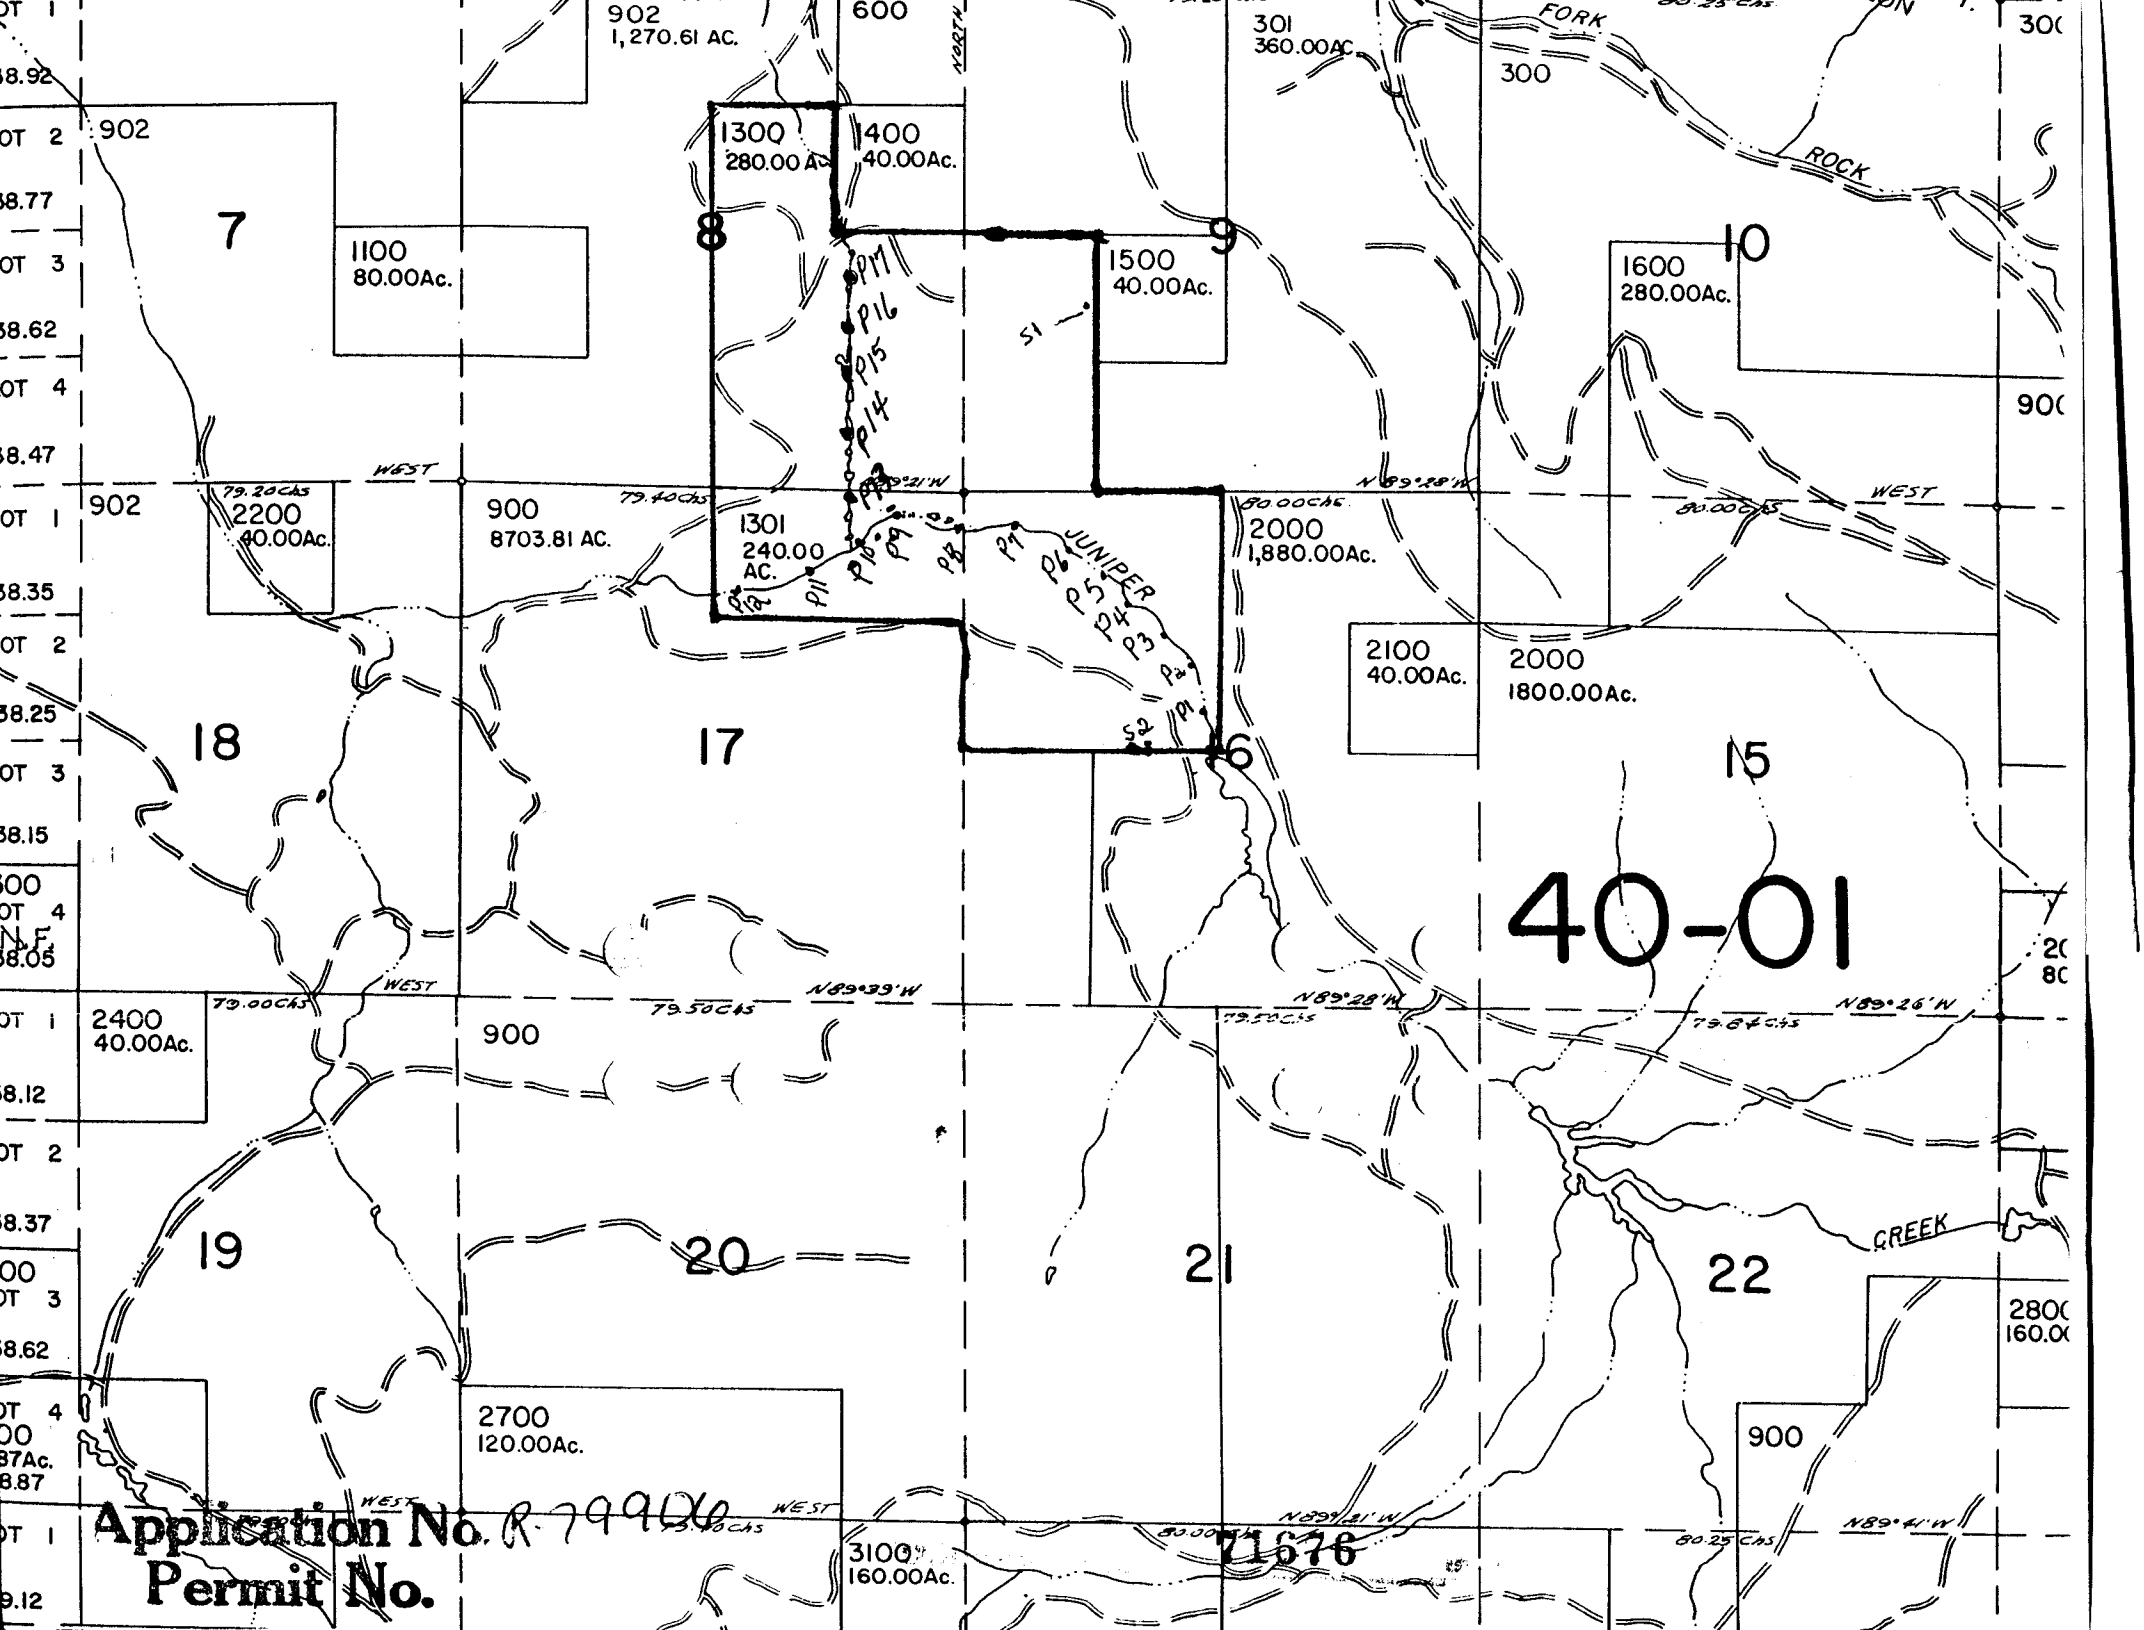

Application No. R-79900

Permit No. 71676