


UNITED STATES
DEPARTMENT OF THE INTERIOR
GEOLOGICAL SURVEY


OREGON-WALLOWA CO.
7.5 MINUTE SERIES (TOPOGRAPHIC)


71682

Application No. 79912
Permit No.

RECEIVED
JAN - 4 1995
WATER RESOURCES DEPT
LEWIS, OREGON

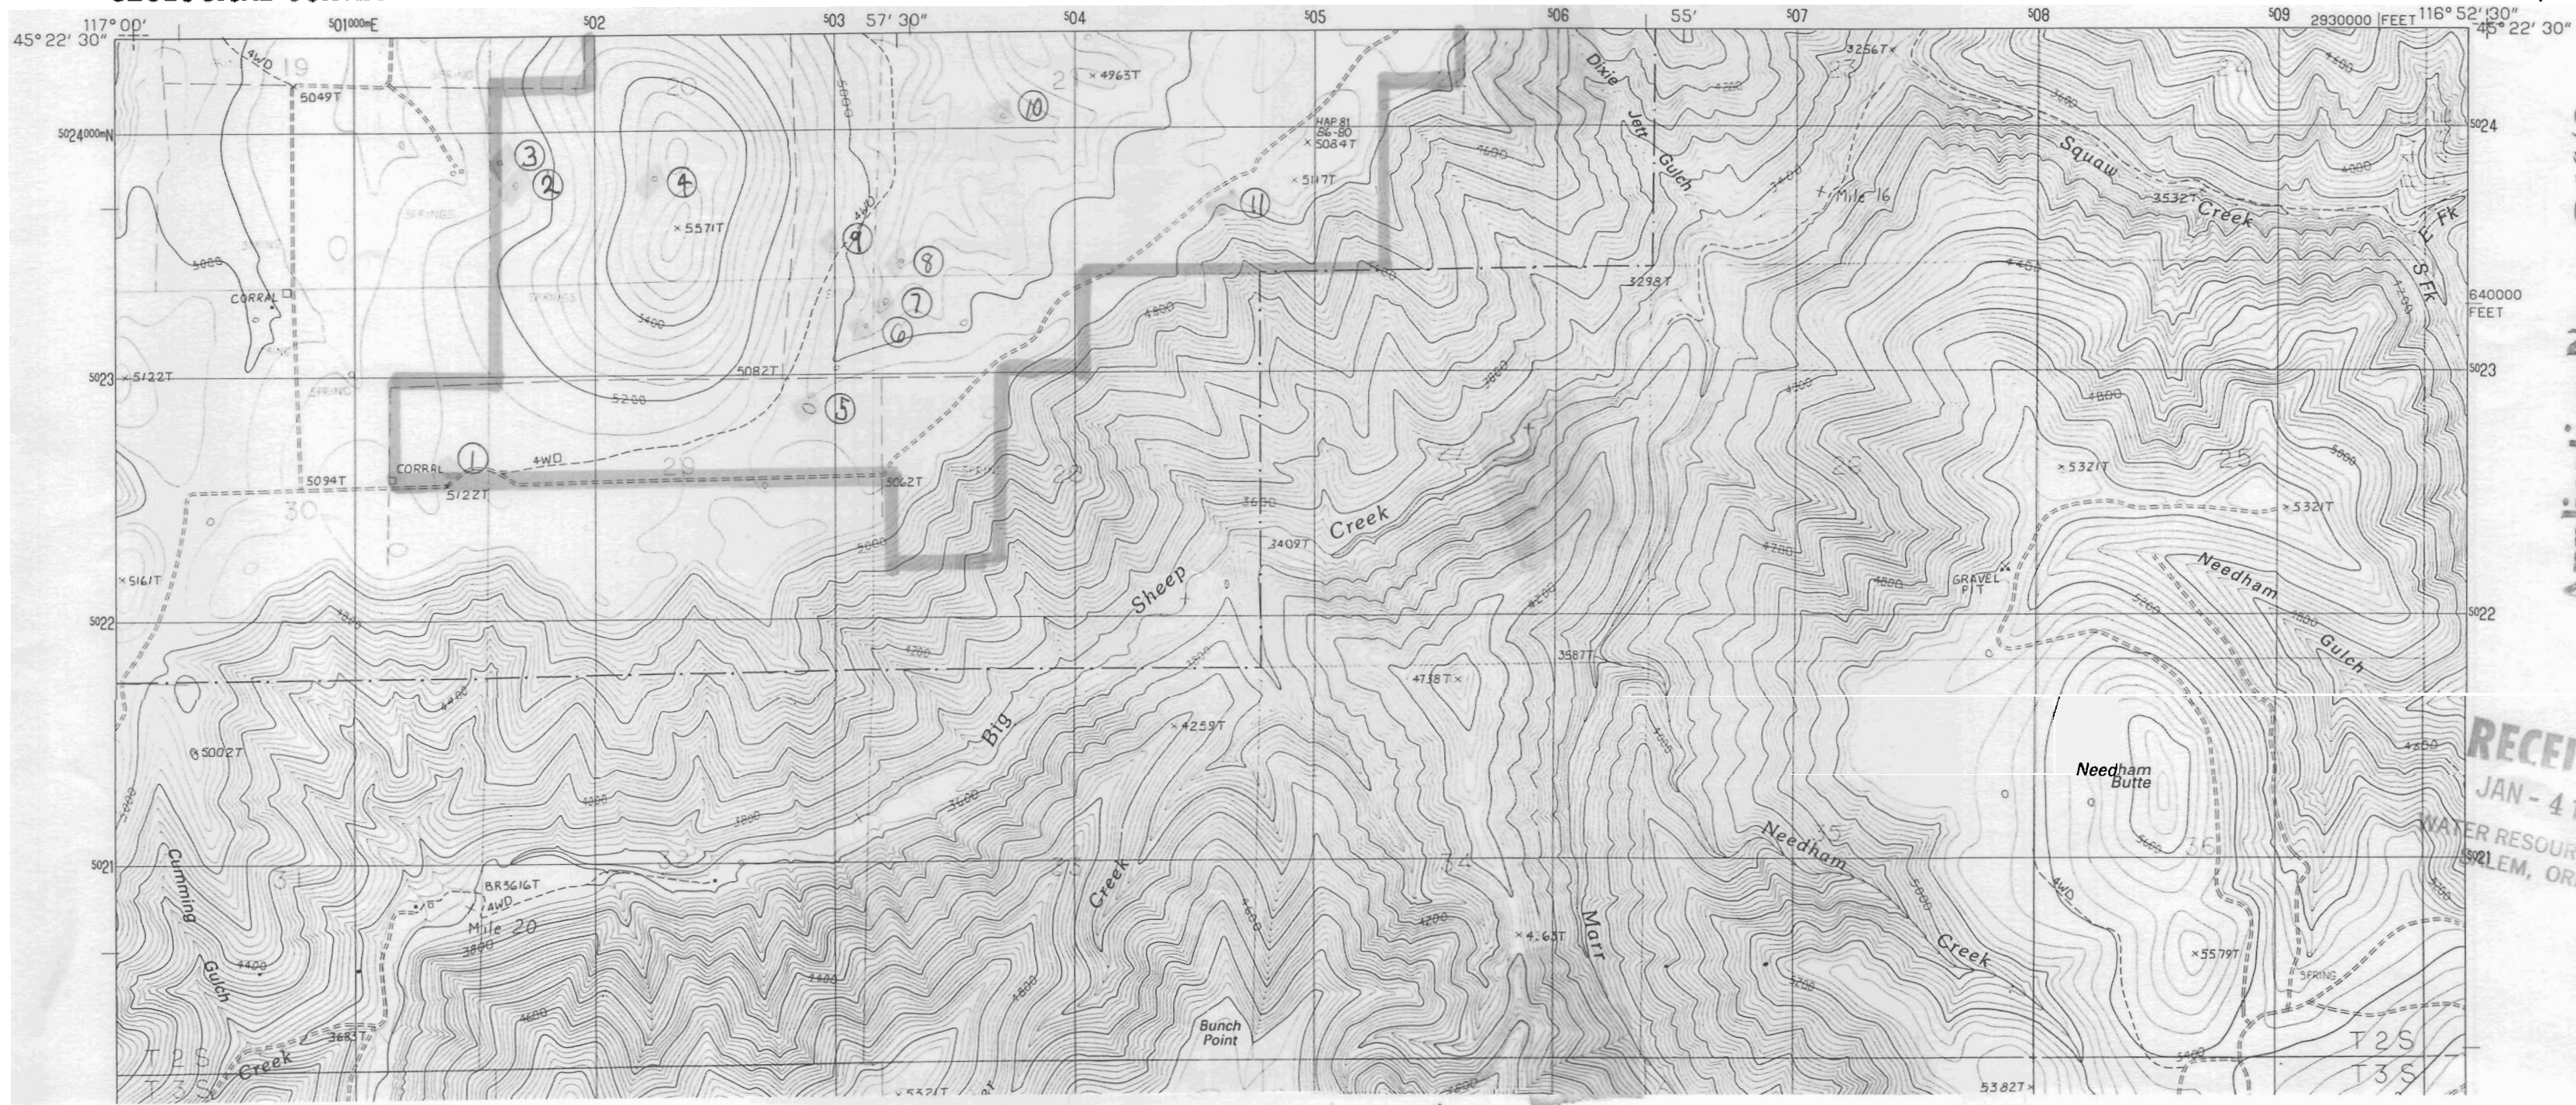


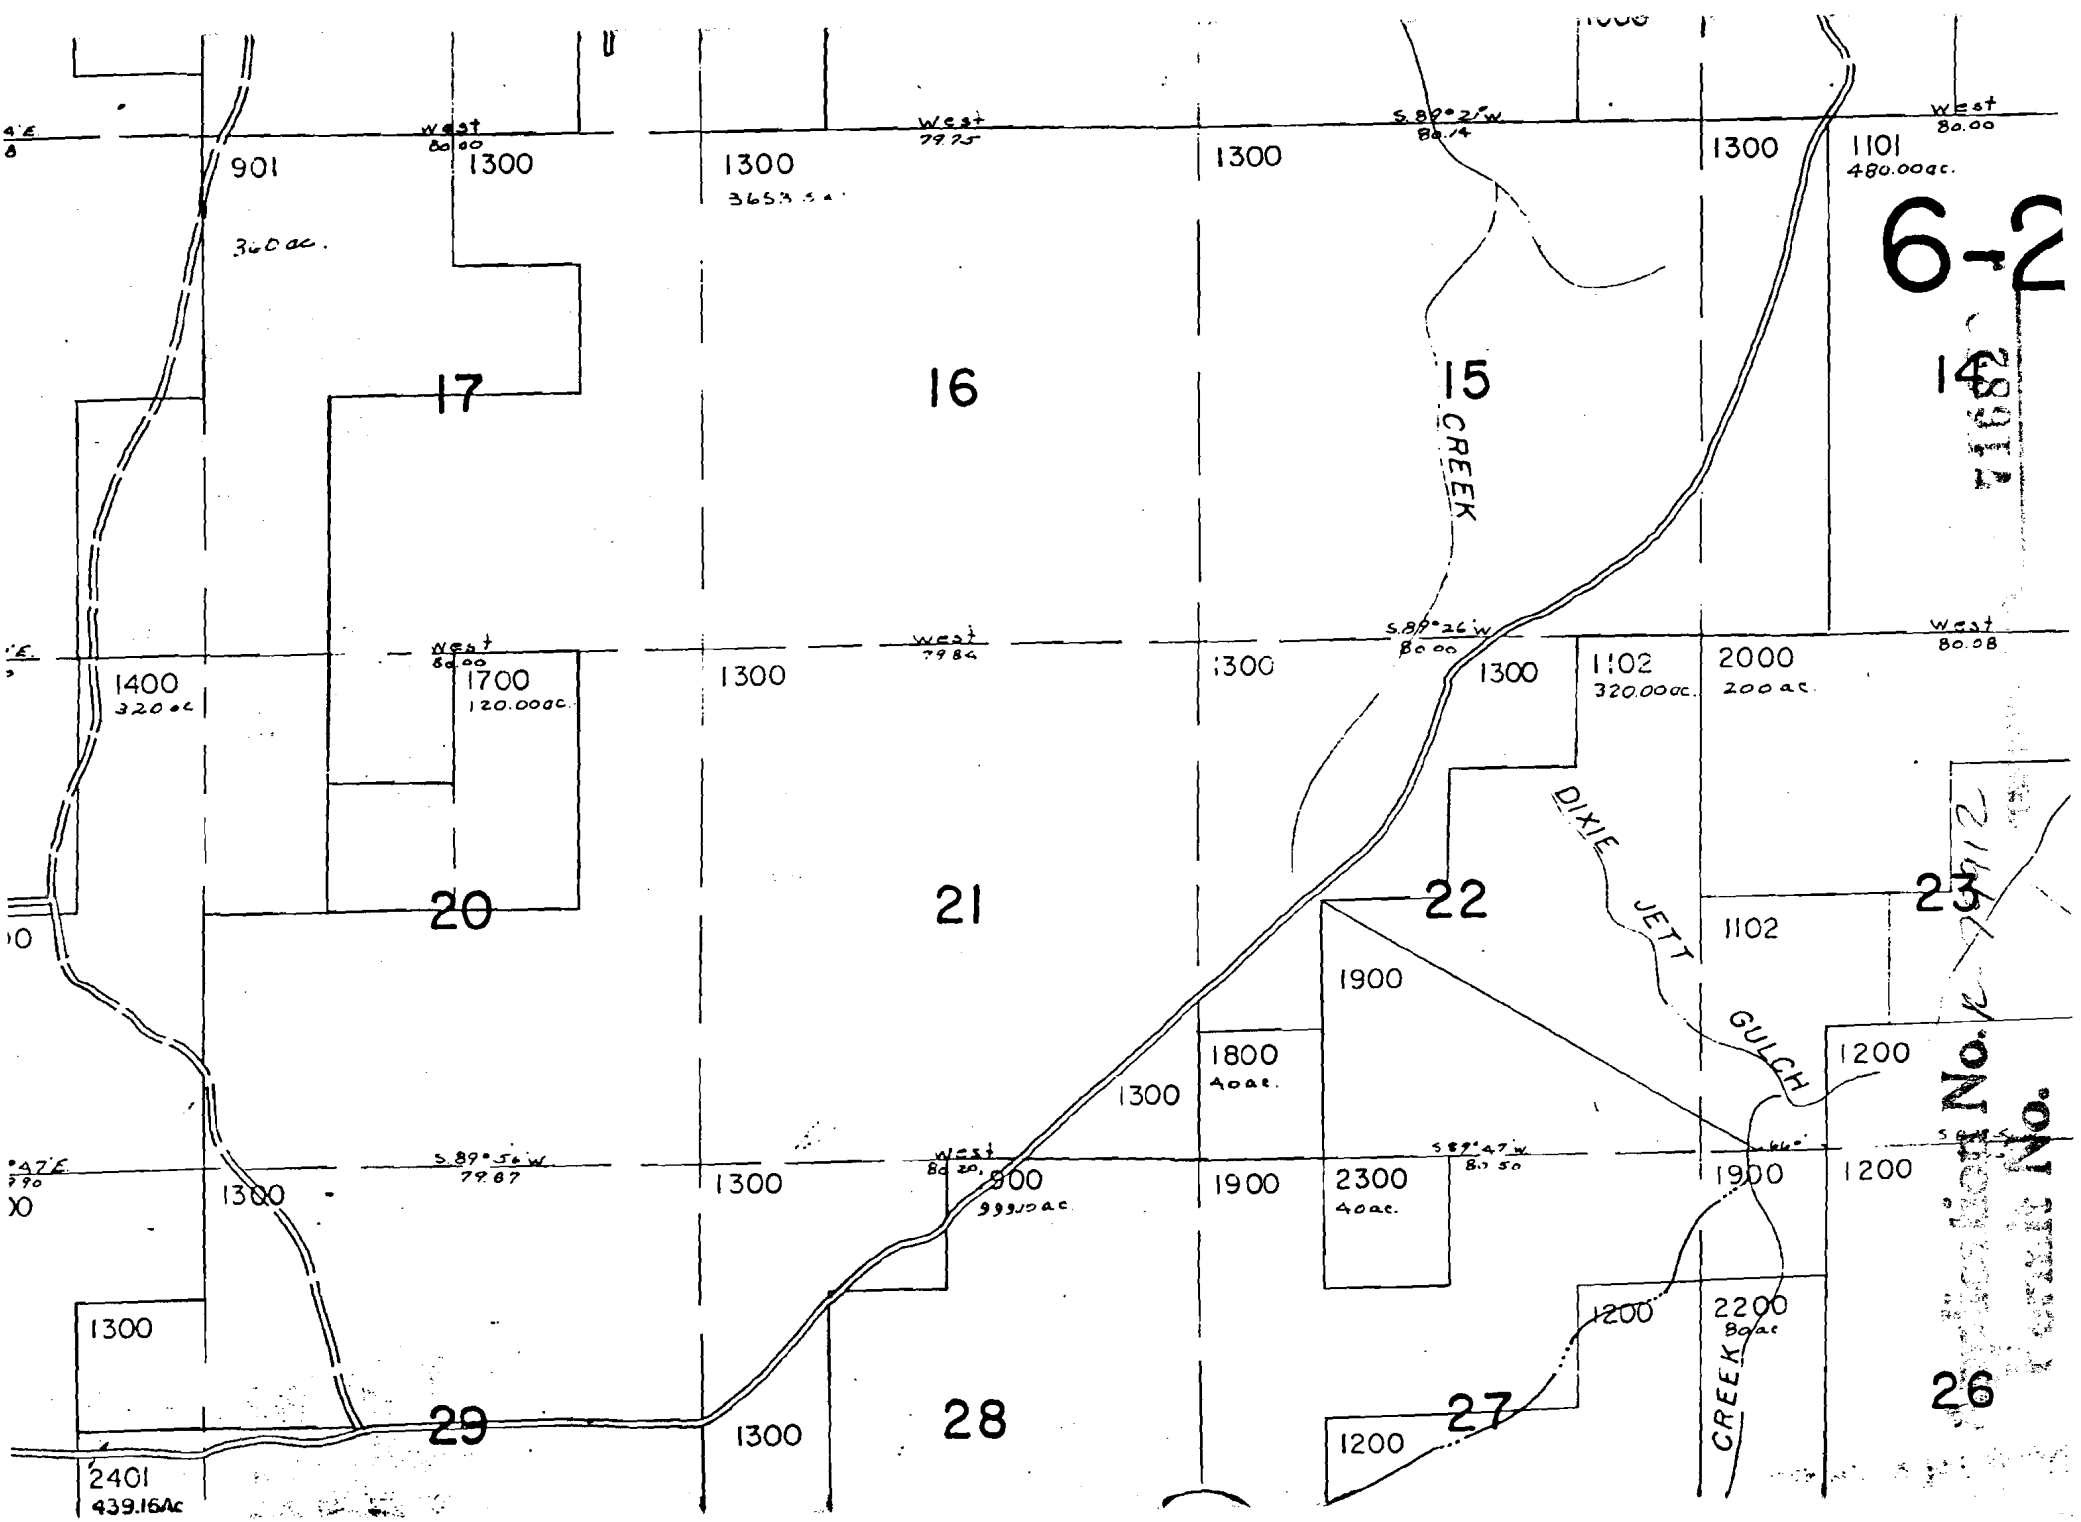

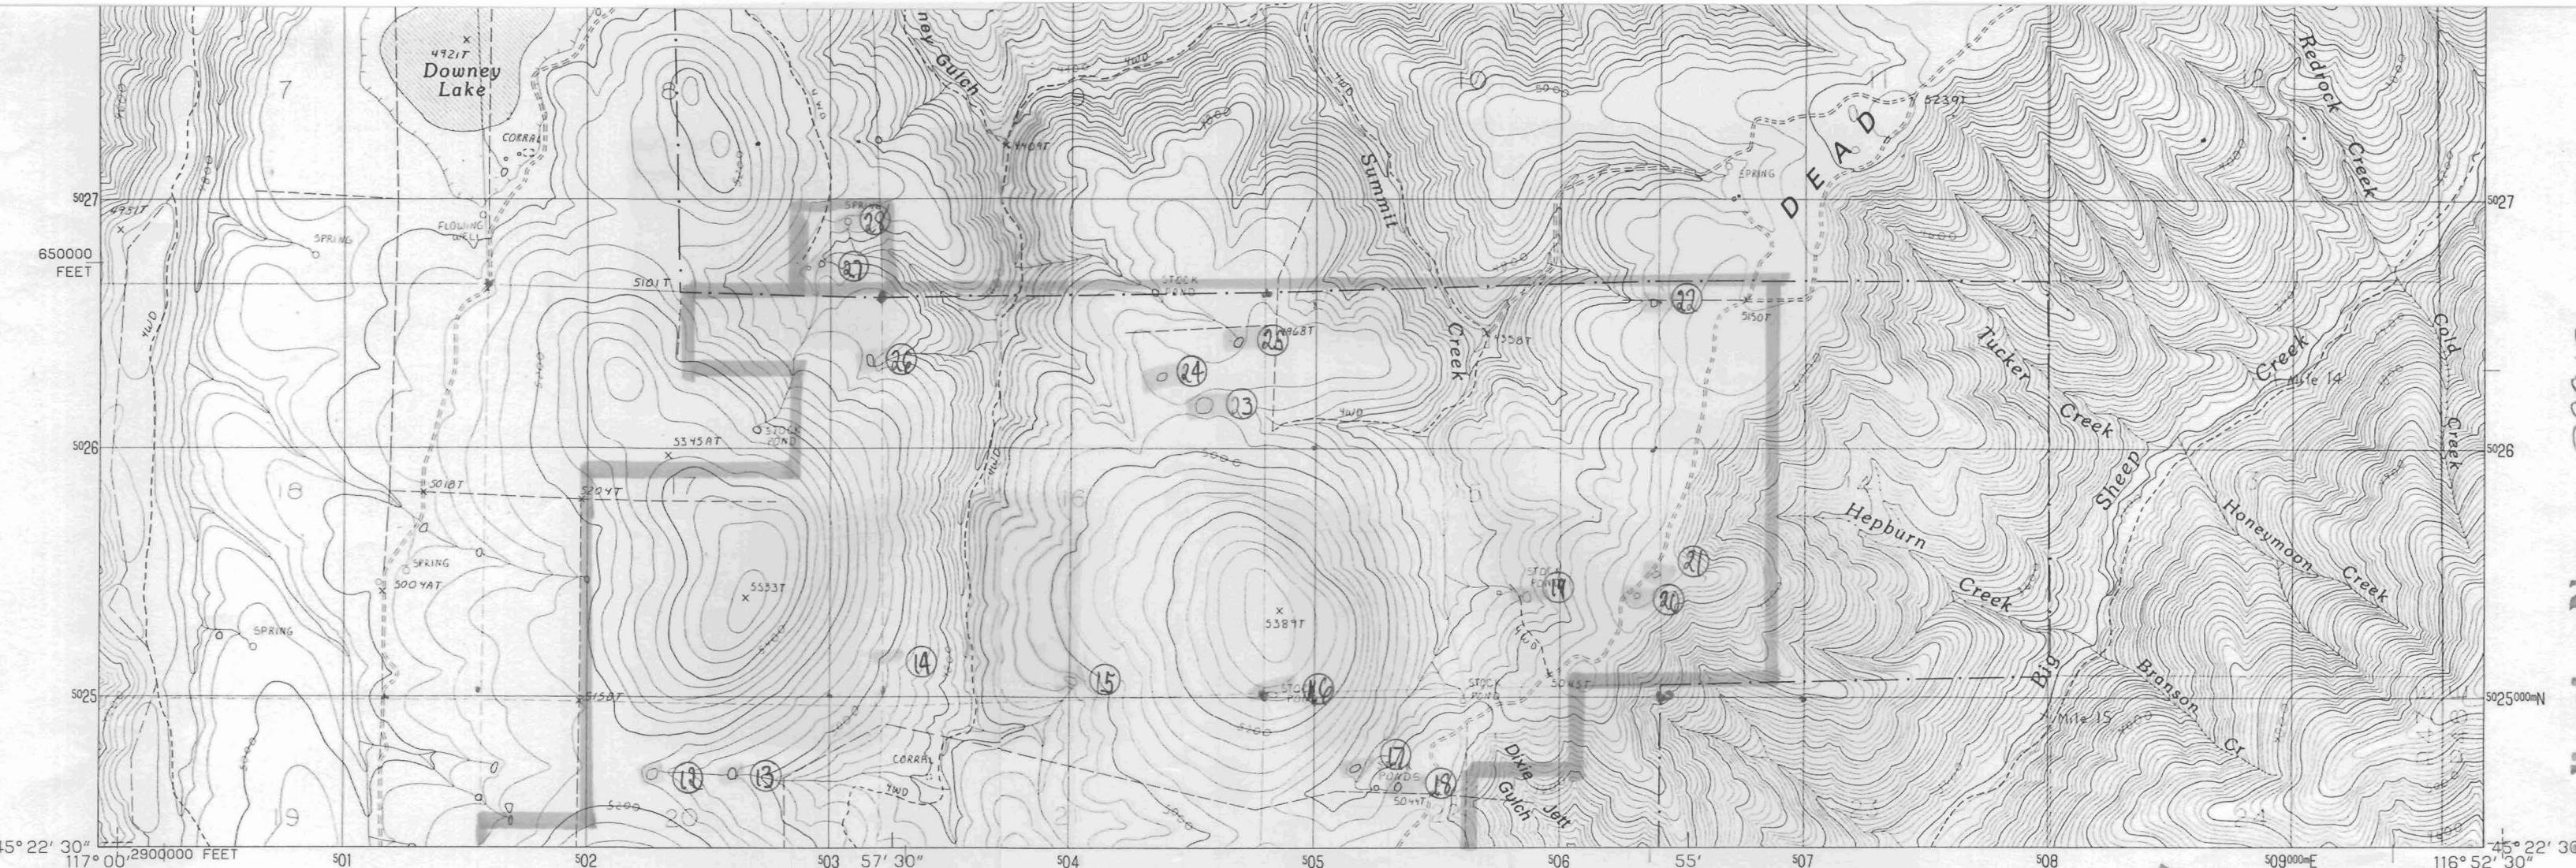

PRODUCED BY THE UNITED STATES GEOLOGICAL SURVEY
CONTROL BY.....USGS AND NOS/NOAA
COMPILED FROM AERIAL PHOTOGRAPHS TAKEN.....1981
FIELD CHECKED.....1987. MAP EDITED.....1990
PROJECTION.....LAMBERT CONFORMAL CONIC
GRID: 1000-METER UNIVERSAL TRANSVERSE MERCATOR.....ZONE 11
10,000-FOOT STATE GRID TICKS.....OREGON, NORTH ZONE
UTM GRID DECLINATION.....0°03' EAST
1990 MAGNETIC NORTH DECLINATION.....17°30' EAST
VERTICAL DATUM.....NATIONAL GEODETIC VERTICAL DATUM OF 1929
HORIZONTAL DATUM.....1927 NORTH AMERICAN DATUM
To place on the predicted North American Datum of 1983,
move the projection lines as shown by dashed corner ticks
(16 meters north and 78 meters east)
There may be private inholdings within the boundaries of any
Federal or State reservations shown on this map
Certain land lines are omitted because of insufficient data


PROVISIONAL MAP
Produced from original
manuscript drawings. Infor-
mation shown as of date of
field check.

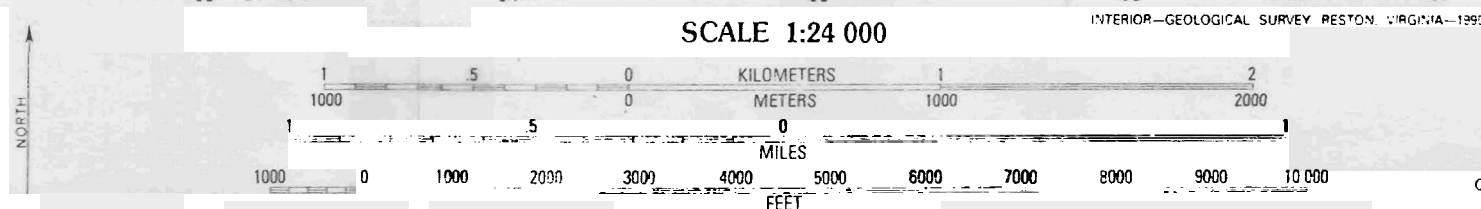

CONTOUR INTERVAL 40 FEET


To convert meters to feet multiply by 3.2808
To convert feet to meters multiply by .3048

THIS MAP COMPLIES WITH NATIONAL MAP ACCURACY STANDARDS
FOR SALE BY U. S. GEOLOGICAL SURVEY
DENVER, COLORADO 80225, OR RESTON, VIRGINIA 2209

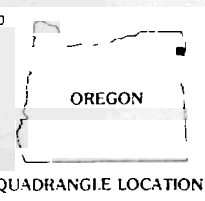

1	2	3	1 Elk Mountain SE
			2 Findley Buttes
			3 Innaha
4		5	4 Three Lakes Country
			5 Sheep Creek Divide
			6 Kinney Lake
			7 Harl Butte
			8 Jaynes Ridge

ADJOINING 7.5' QUADRANGLE NAMES

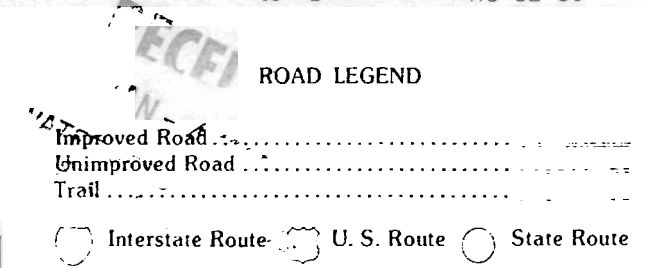

CLEAR LAKE RIDGE, OREGON
PROVISIONAL EDITION 1990

45116-D8-TF-024

Application No. *R-79912* 71682
Permit No.