
HB 2153 R79917

Dear Sir

This pond has been in for about 30 yea it is used as a over flow for my Irrigation, we have fish in it & the pond dose not hold water all the time, the water leek back into Deer Creek. Ducks & wild geese use it also. When I stop Irr. in the fall the Pond drop's down to about ½ foot then stays their if it rains or it will go dry.

RECEIVED
DEC - 5 1994
WATER RESOURCES DEPT.
SALEM, OREGON

RECEIVED
JAN - 4 1995
WATER RESOURCES DEPT.
SALEM, OREGON

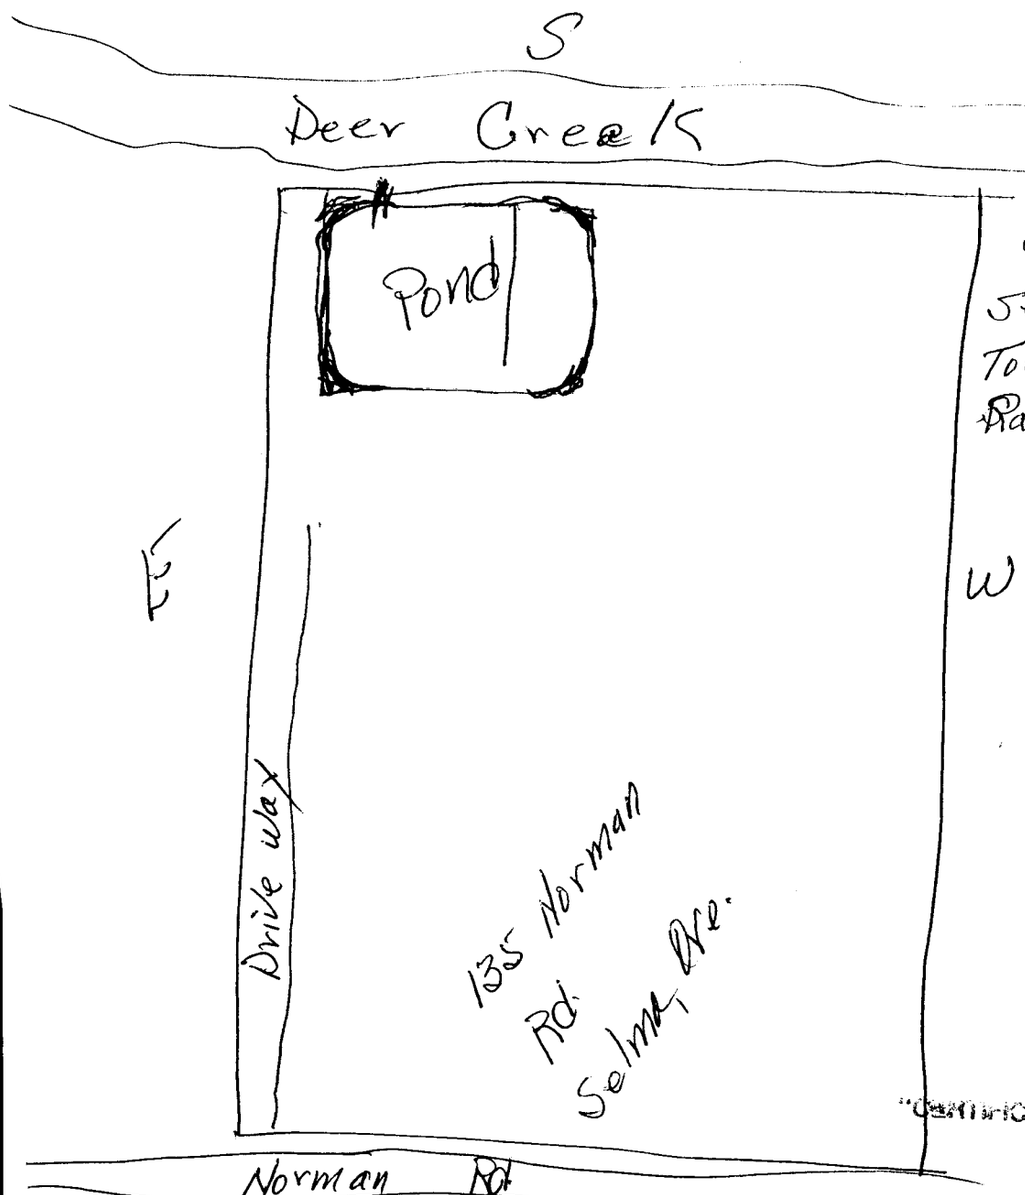

SE ¼ SE ¼,
Section 10,
Township 38 South,
Range 8 West,
W.M.

CERTIFICATE NO. 71687

Application No. R-79917
Permit No.