


71689

Application No. R-80000
Permit No.

T.5S., R.3W., W.M.

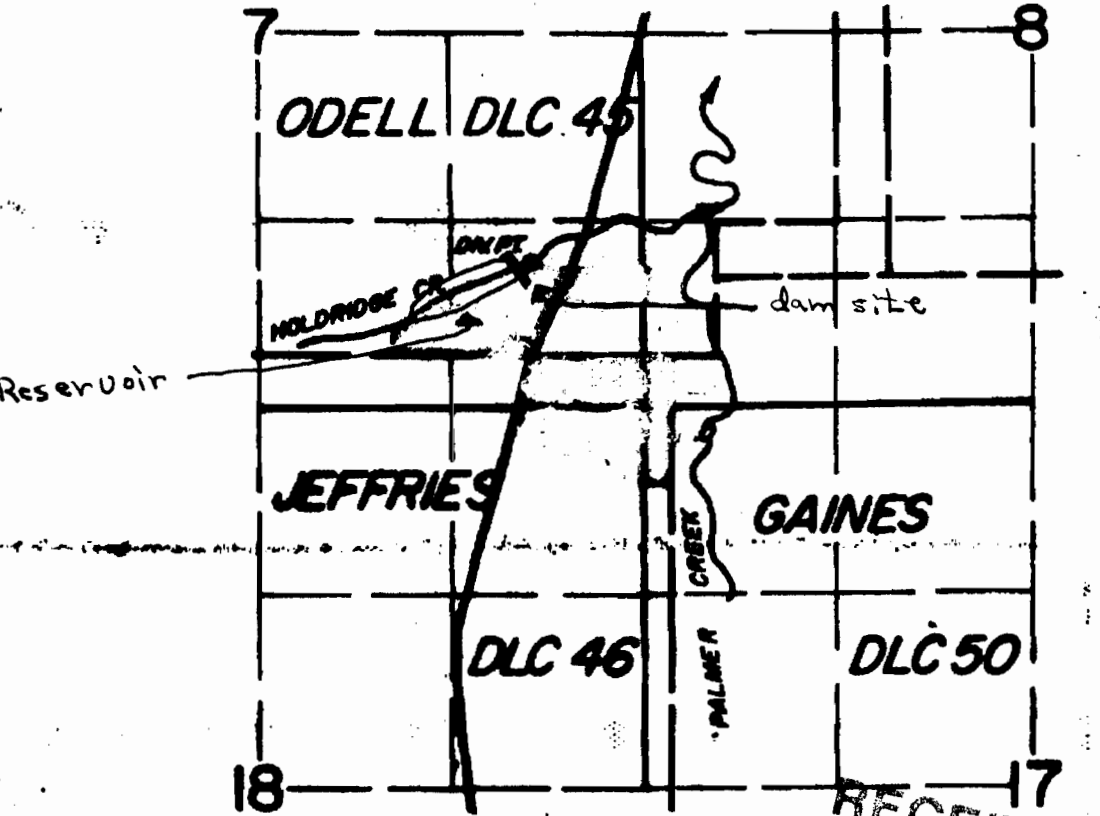

DIV. PT. LOC. 980' N. & 980' W. from the NE Corner DLC 46

 PRIMARY

 SUPPLEMENTAL

RECEIVED
DEC 20 1994

WATER RESOURCES DEPT
SOUTH CENTRAL REGION

FINAL PROOF SURVEY
UNDER

Application No. 53040 Permit No. 49028

IN NAME OF

MICHAEL CARR

Surveyed MAY 9, 1979, by C. RODRIGUEZ.