

# APPLICATION MAP

In The name of : Hemstreet Development

**RECEIVED**


Section 24, T.3S., R.8E., W.M. DEC 29 1994

Application No. R-80008  
Permit No.

Scale 1 inch = 400 feet

WATER RESOURCES DEPT.  
SALEM, OREGON


← NORTH 1/4 CORNER of SEC. 24

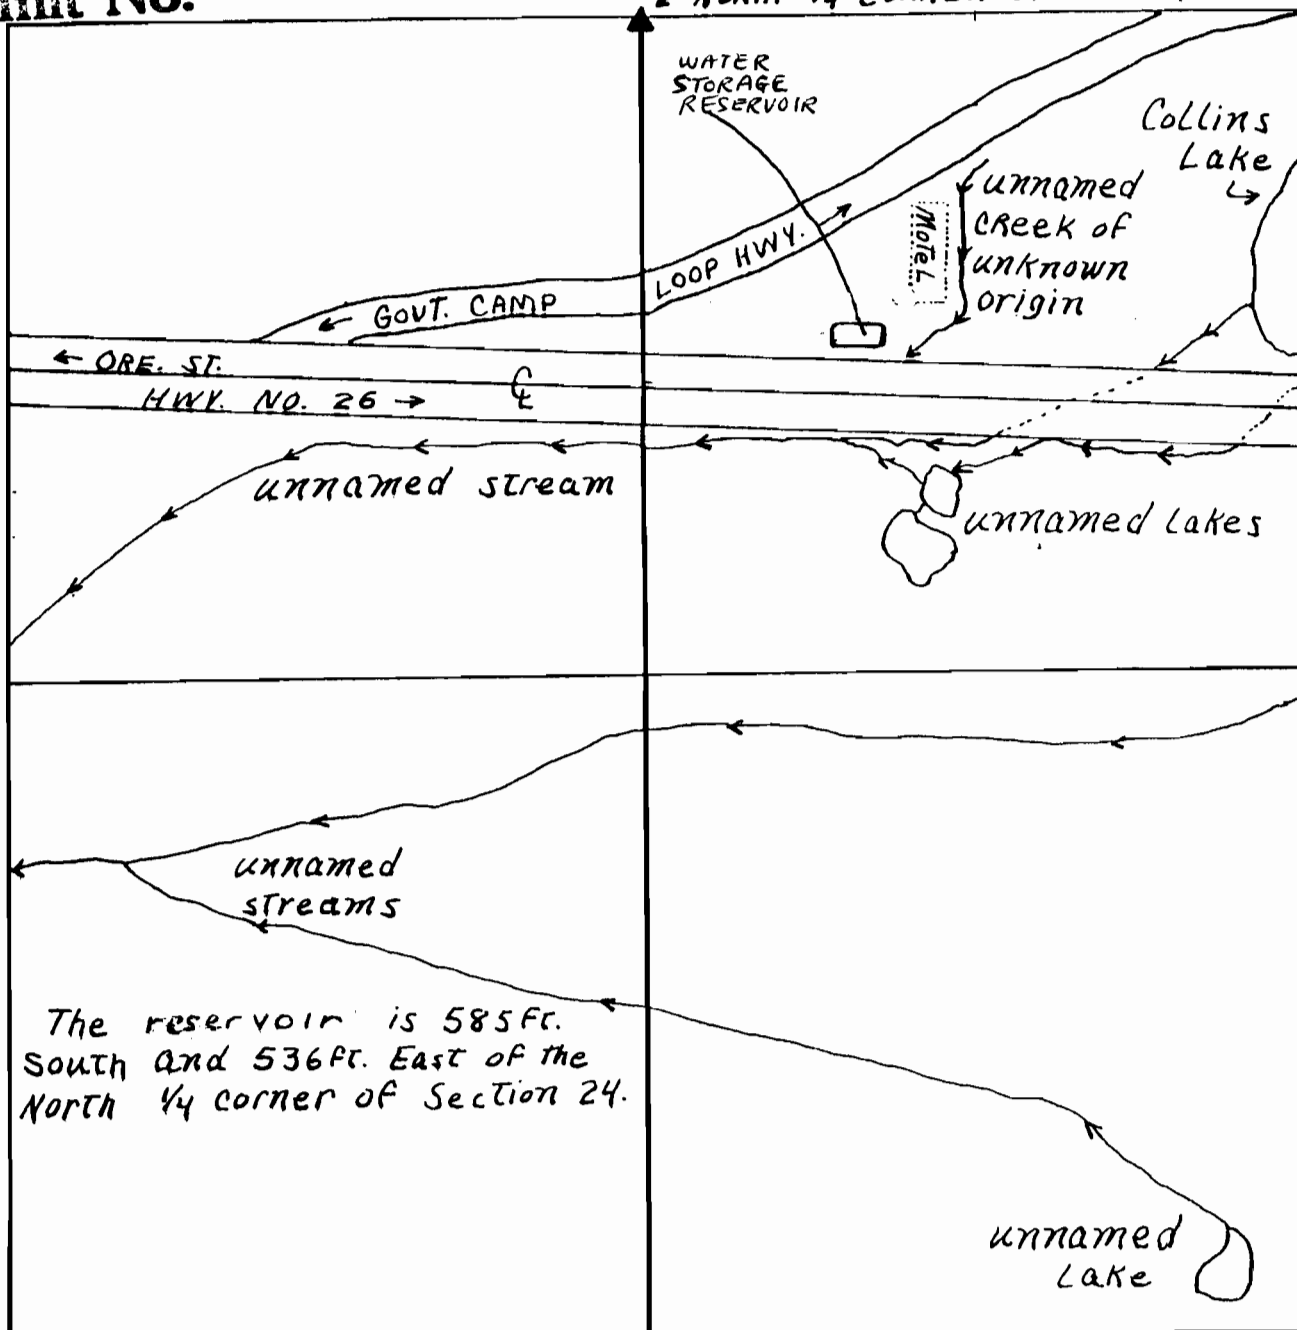


Basis of Bearing - P.S. 18002

⊙ = WELL POINT

The purpose of this map is to identify the location of the retention pond. It is not intended to provide information relative to the location of property ownership boundary lines.

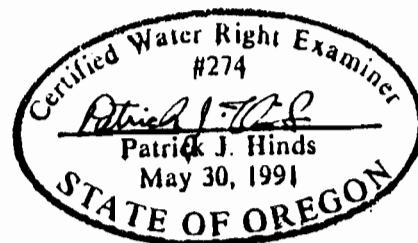

71697

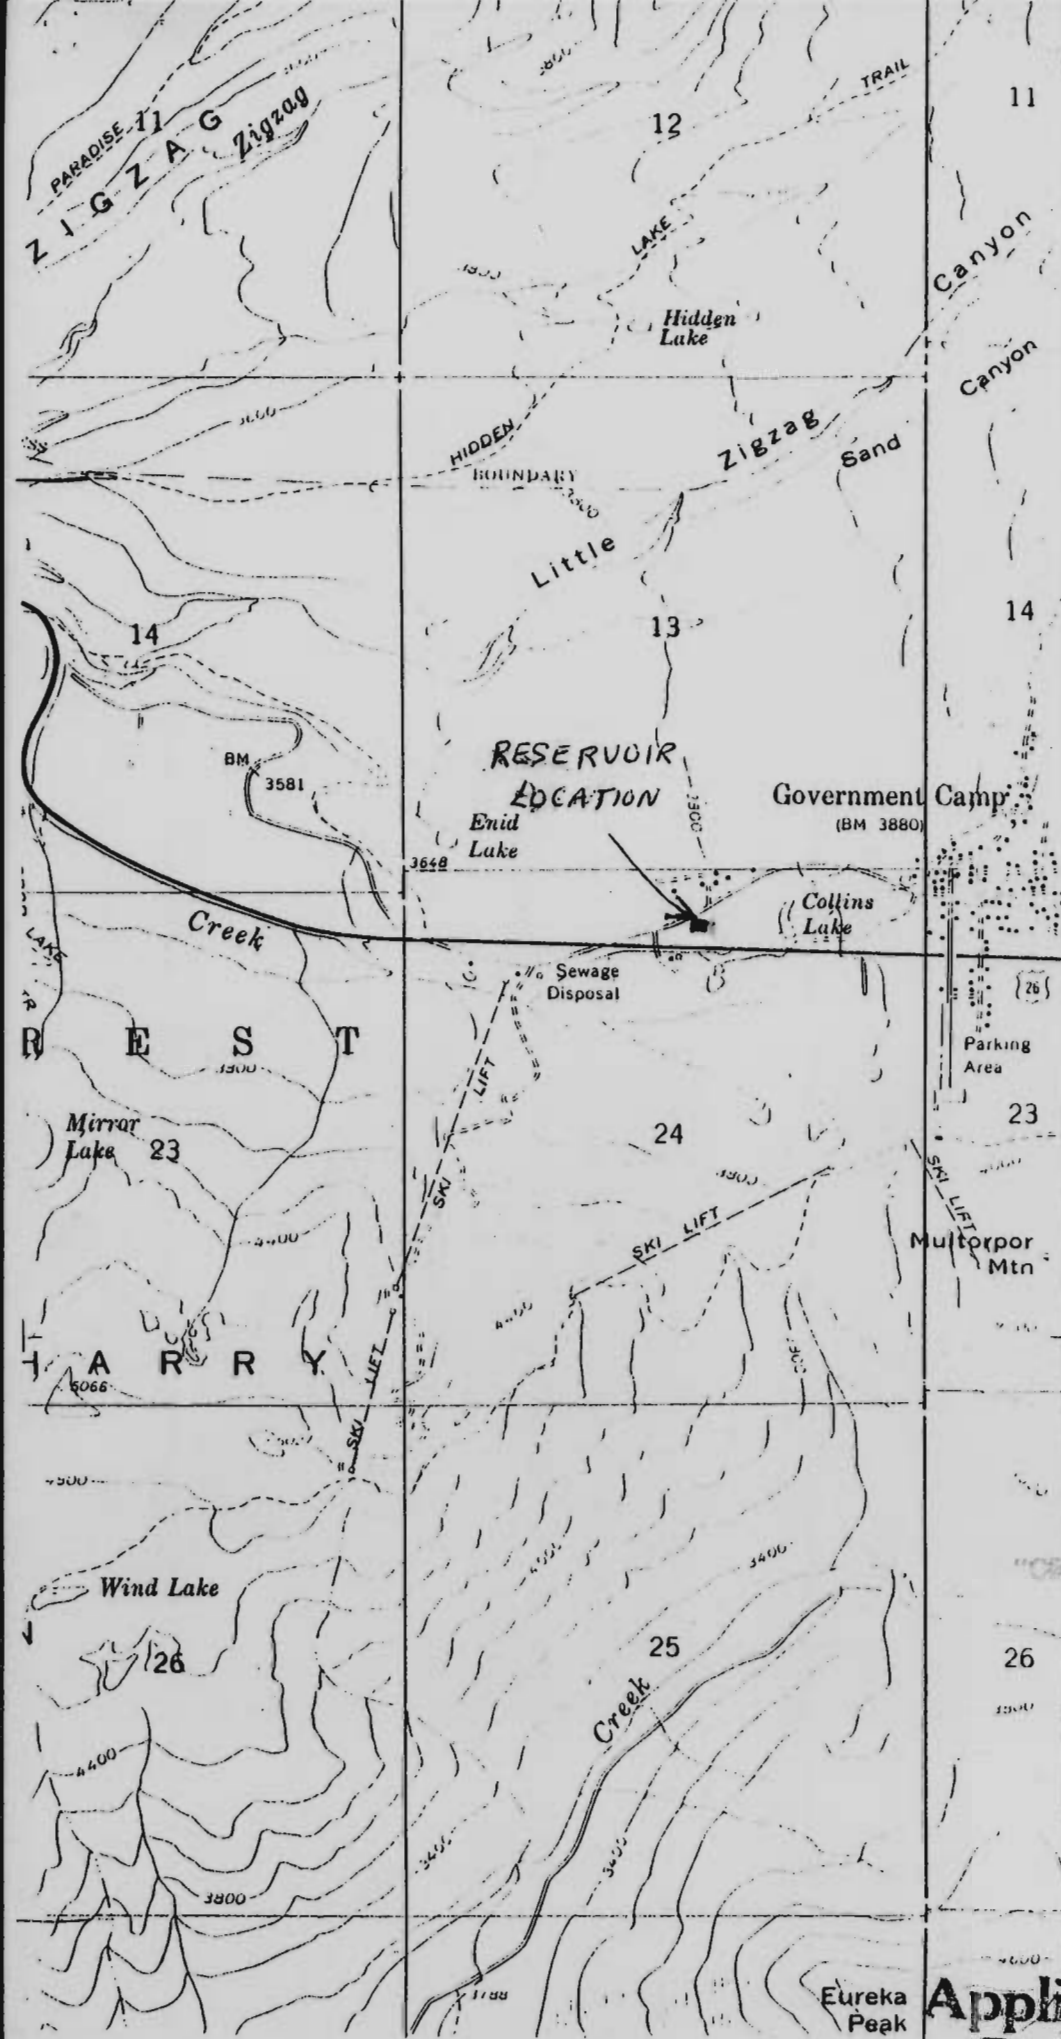

5020  
5019  
5017  
5016  
5015  
5014

(MT. HOOD SOUTH)  
1674' SW  
3 M. TO OREG 35  
MADRAS 60 MI

17'30

*Mt. Hood Motel  
Vicinity Map  
Government Camp  
Quadrangle*

**RECEIVED**  
DEC 29 1994  
WATER RESOURCES DEPT.  
SALEM, OREGON

"CERTIFICATE NO. 71697"

**Application No. R-80008**  
**Permit No.**