

JK

M 6 A - 3B

Not To Scale


ROAD

PERMIT NO. 71639

RECEIVED

DEC 29 1994

WATER RESOURCES DIVISION
SALEM, OREGON

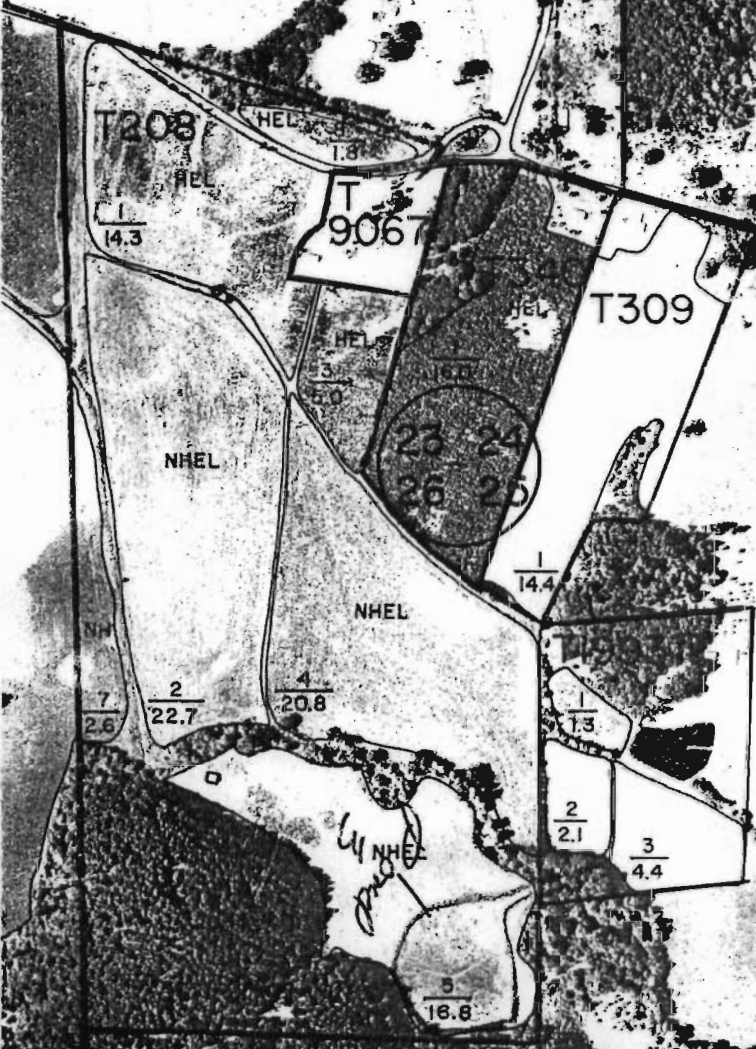

Handown NHEL
Looto Logging Inc.

Application No R-80010
Permit No.


CERTIFICATE NO. 71699

T 3 R 5
RECEIVED *Handwritten*

DEC 29 1994 *Robert R. & Arlene D. Loo to*

WATER RESOURCES DEPT.
SALEM, OREGON

N 7 A - 1A
Not To Scale

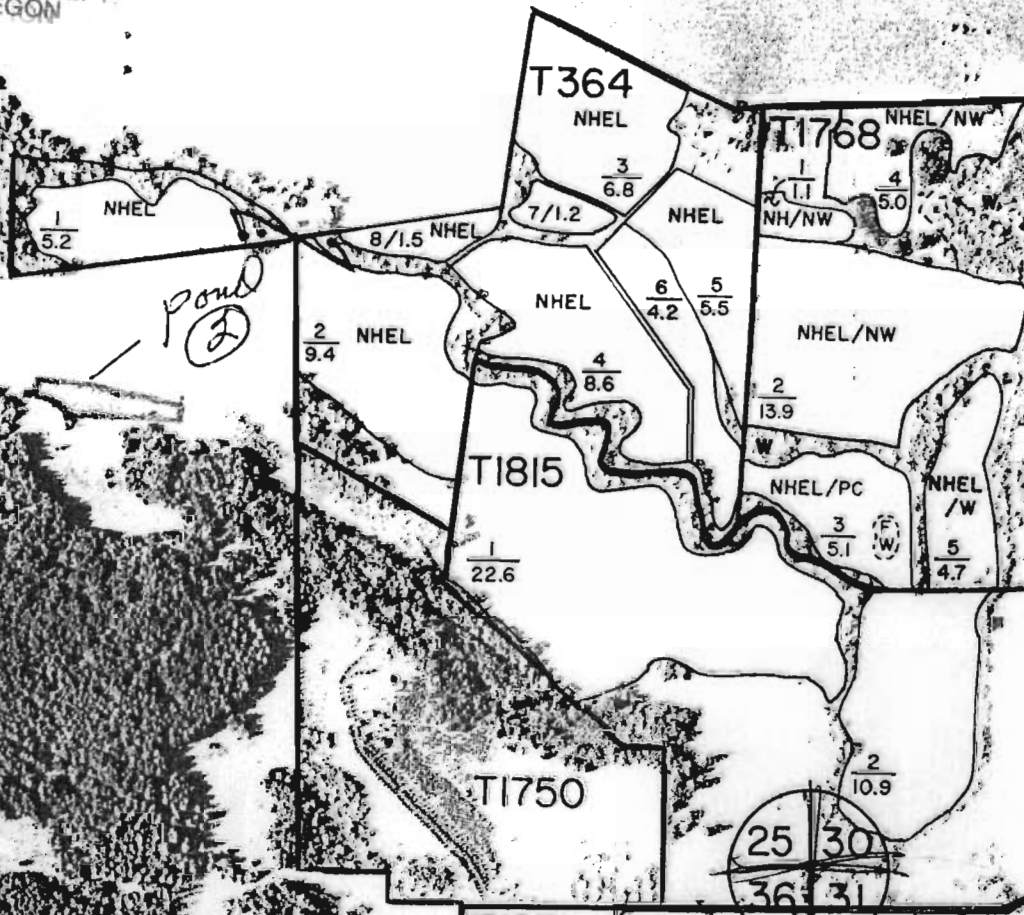

Pond 2

*25 30
36 31*

*POND SHOWS ON
ASCS 1992
AERIAL SLIDE
MG 38*

*T1742 by New D...
12/27/94*