


# FALLON TRUST PROPERTY

CERTIFICATE NO. 71712

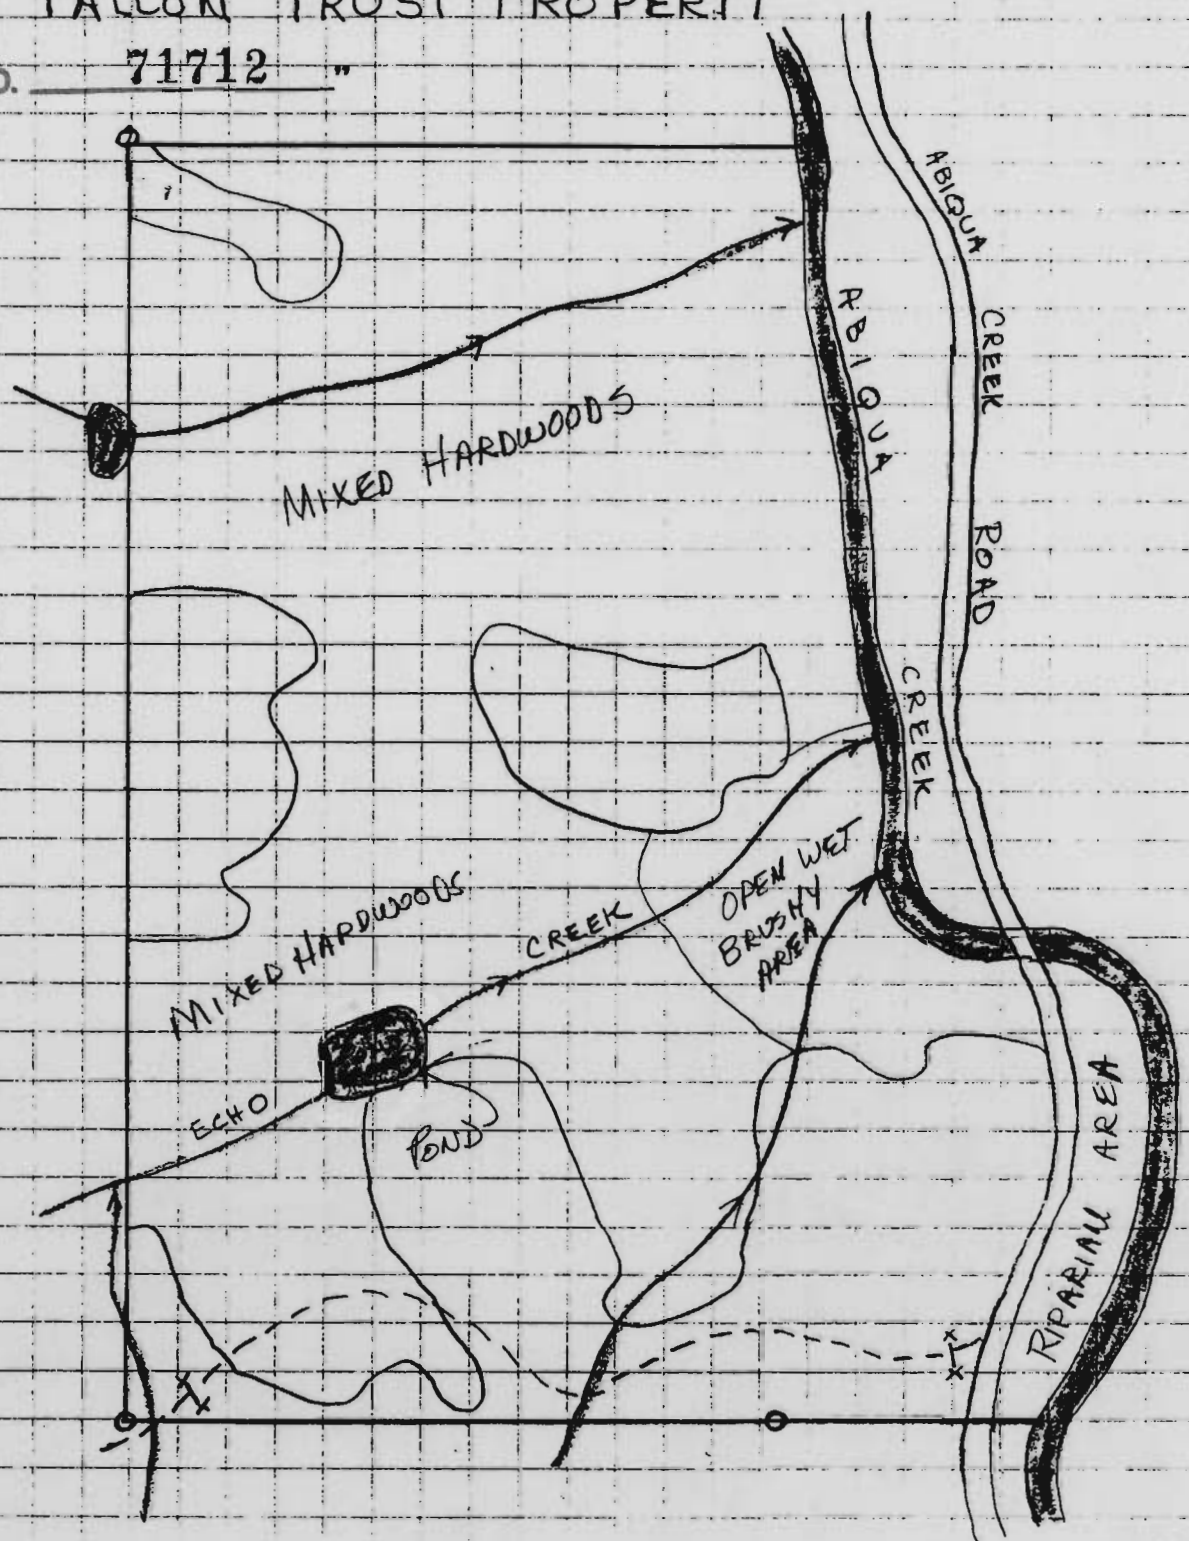

0 100' 200' 400'

MAP SCALE 1" = 400'

WATER RESOURCES DEPT.  
SALEM, OREGON

**RECEIVED**

JAN 3 1995

NORTH ↑

BEST TIMBER STANDS

Application No. R-80024

Permit No.

NTM 12-29-9

100  
64233000

1/4 COR

ABIQUA CREEK

SEE MAP

CERTIFICATE NO. 711712

Application No. R-8002  
Permit No. 2

10

ECHO CREEK

07 1E 11A

EL ROMAR DRIVE NE

004 00 02 0

WATER RESOURCES DEPT.  
SALEM, OREGON

JAN 3 1995

RECEIVED

OFF MAP

CTR SEC

1/4 COR

NE COR  
E W ROSS  
NO CLAIM

200  
64214000