


SEE MAP 09 3W 11

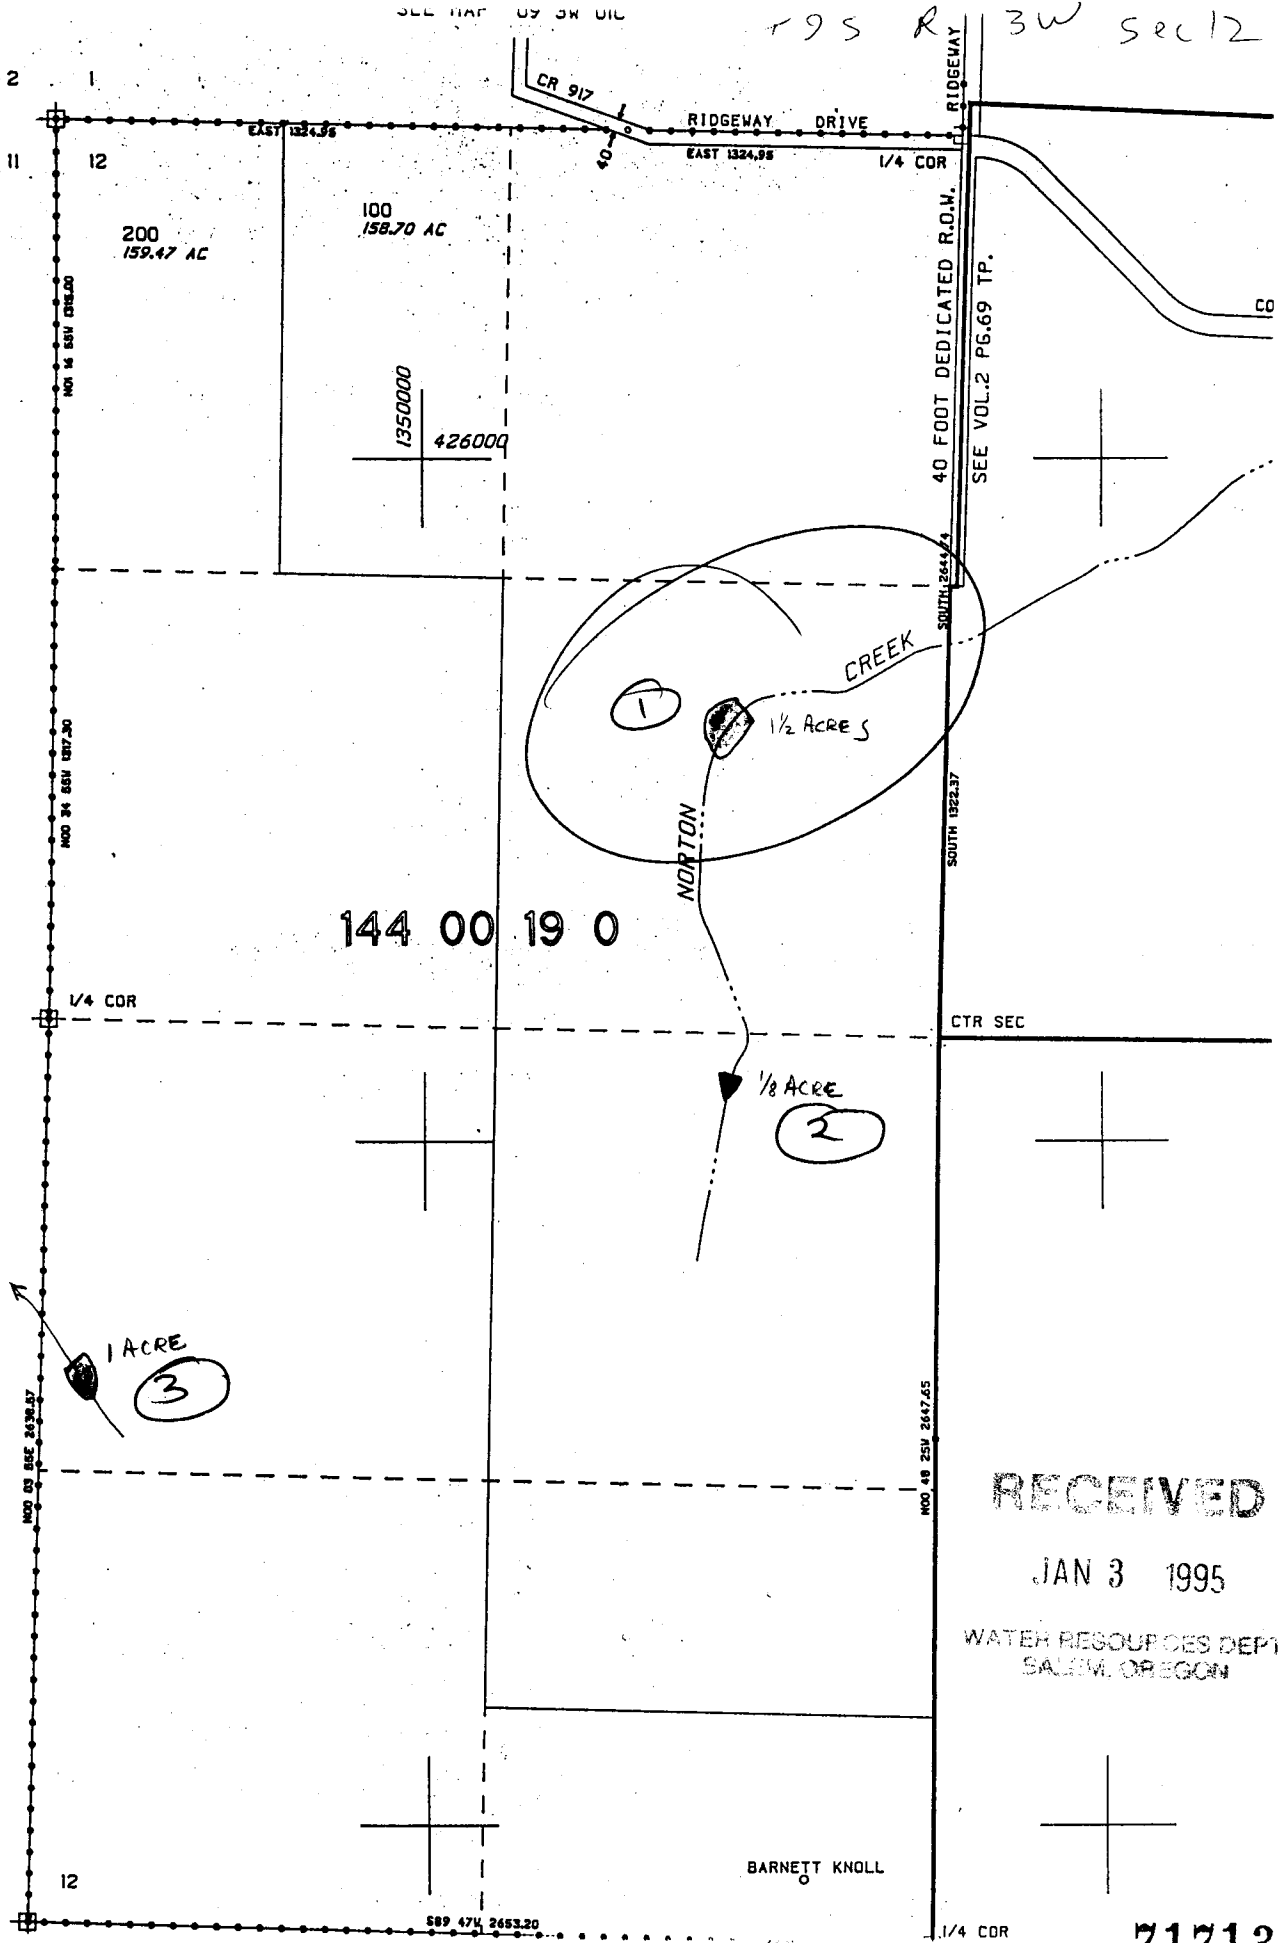

Application No. R-80025
Permit No.