
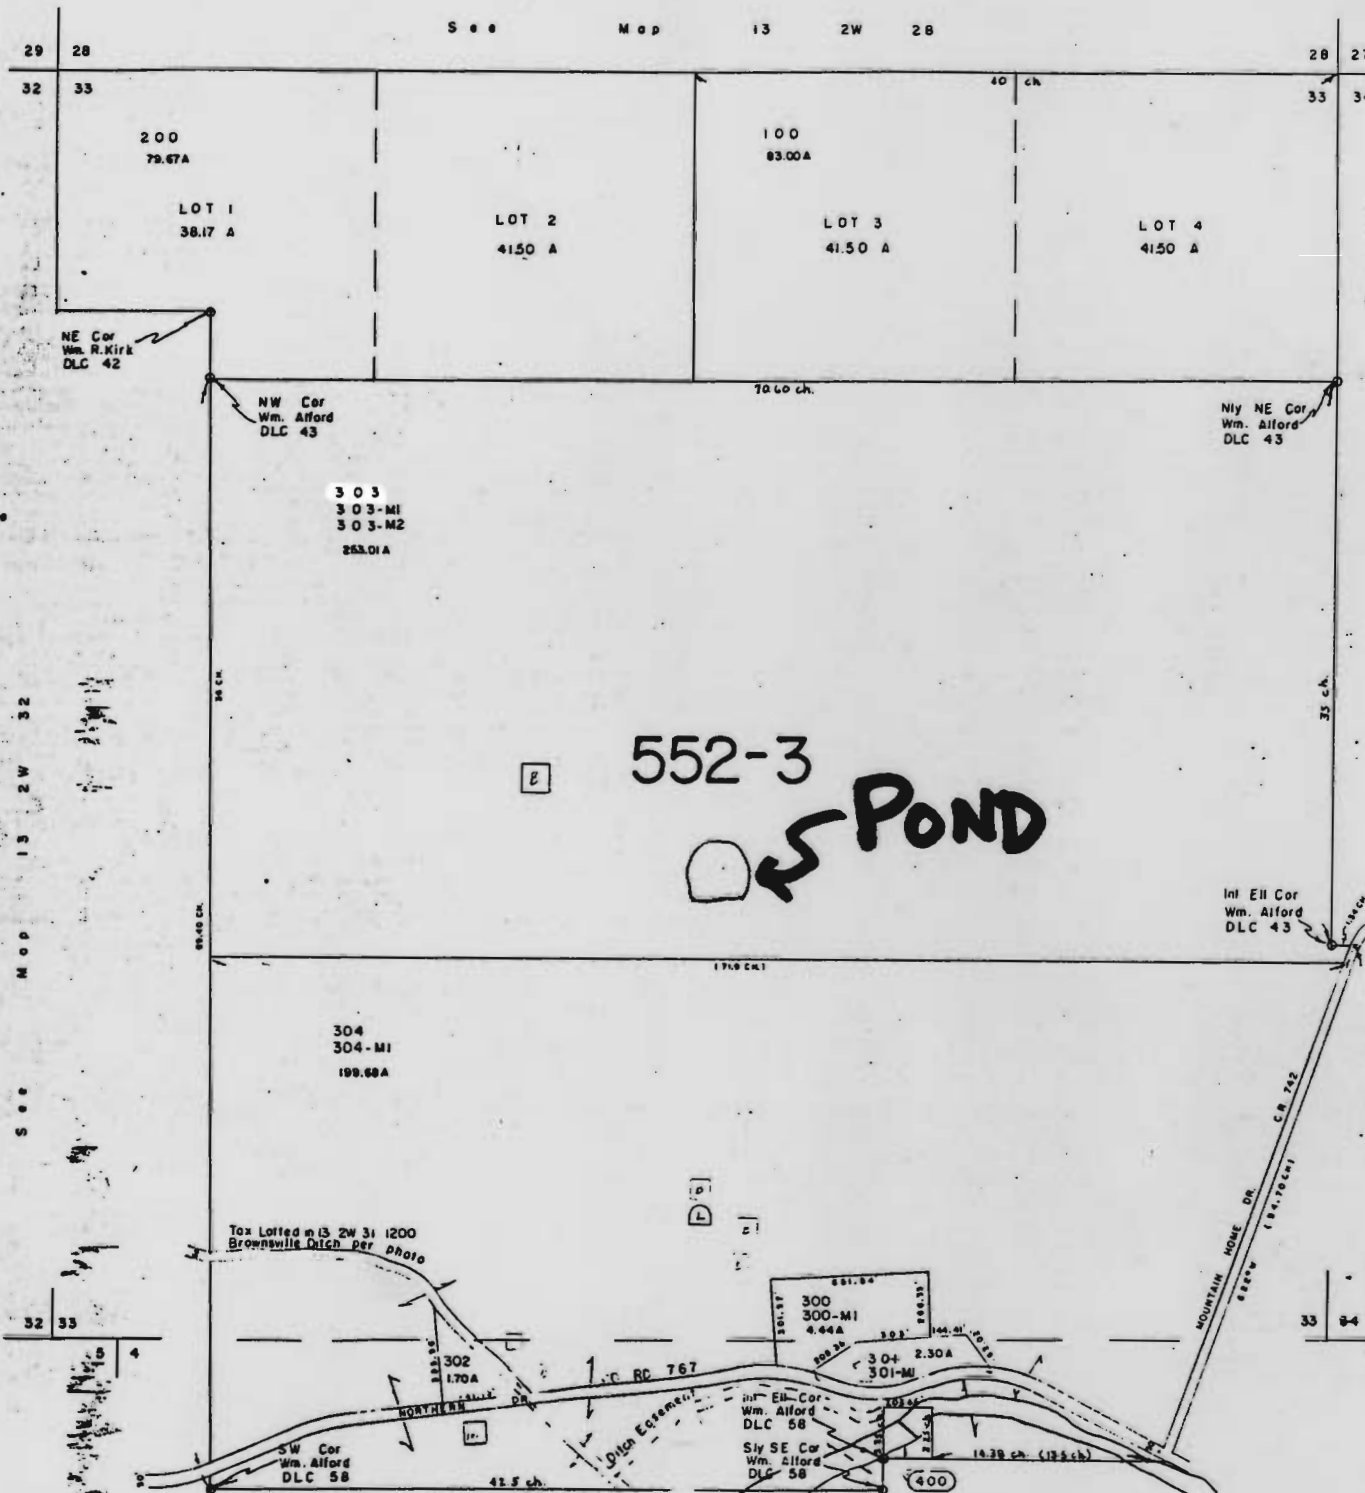


Sec. 33, T. 13 S., R. 2 W., W.M.

1" = 400'

13 2W33
LINN

SCALE 1:9600.

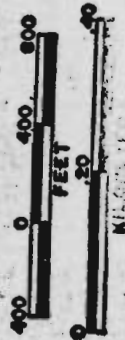

RECEIVED

JAN 3 1995

WATER RESOURCES DEPT.
SALEM, OREGON

71717

CERTIFICATE NO.

Application No R-80029
Permit No.

RECEIVED
JUL 21 1990
DEPT. OF WATER
SALEM, OREGON