

RECEIVED  
JUL 27 1992  
DEPT. OF REVENUE STATE OF OREGON  
REGISTERED & APPROVED INT.

# Application No R-80039 Permit No.

SEE MAP 9 1E 17

"CERTIFICATE NO. 71727"

SCALE 1:9600.



RECEIVED  
DEC 28 1994  
SEE MAP 9 1E 16B

WATER RESOURCES DEPT.  
SALEM, OREGON

077 00 04 0

SEE MAP  
9 1E 16A

SEE MAP


9 1E 16D

SEE MAP 9 1E 15C

SEE MAP 9 1E 15B

*I have owned this property since 1974 and I dug a small pond in 1976*

*Walter D. Johnson*

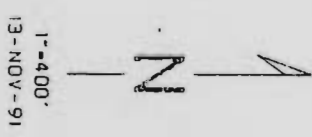

STATE OF OREGON  
COUNTY OF MARION

Subscribed and sworn to (or affirmed) before me this 28th day of Dec 1994, by Walter D. Johnson



OFFICIAL SEAL  
LINDA S. STANDLEY  
NOTARY PUBLIC-OREGON  
COMMISSION NO. 008600  
MY COMMISSION EXPIRES JULY 30, 1995

NOTARY PUBLIC *Linda S Standley*  
MY commission expires 7-30-95

9 1E 16  
INDEX