


photo 7/90 - Lake Co. ASCS - L. Hamilton

R-52

Application No. R-80051
Permit No.

No. 71737

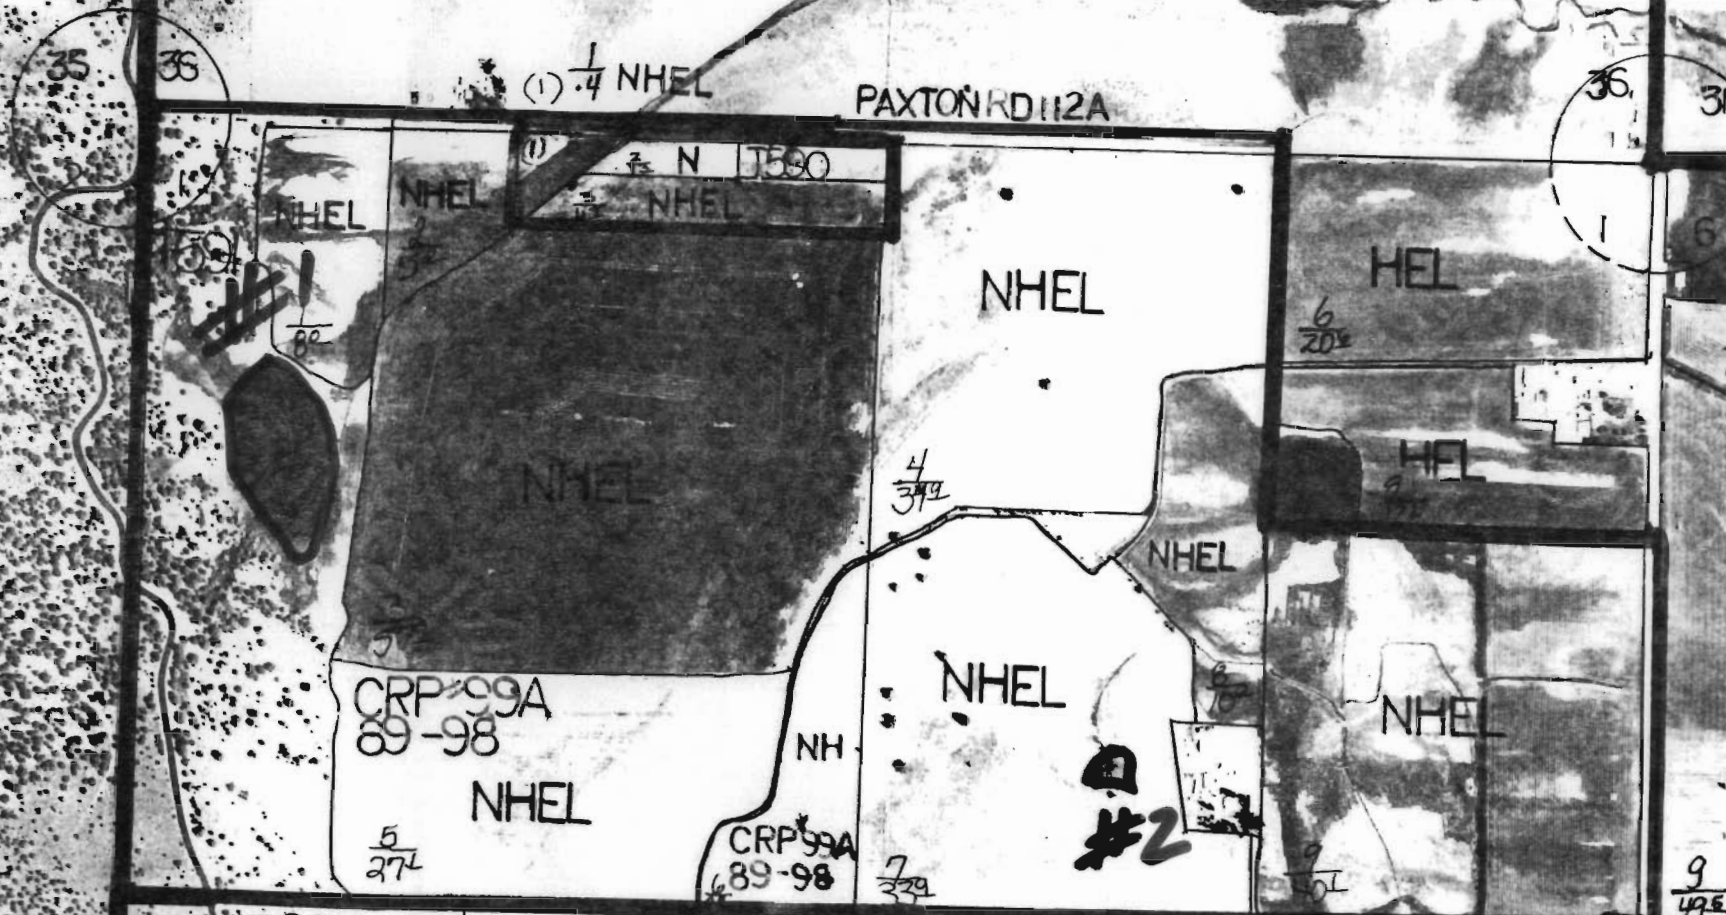

T-207

RECEIVED
JAN - 4 1995
WATER RESOURCES DEPT.
SALEM, OREGON

2

RECEIVED

JAN - 4 1995

WATER RESOURCES DEPT.
SALEM, OREGON


SCALE 1:48000



71737

Application No. P-80051
Permit No.

SEE MAP 40 17

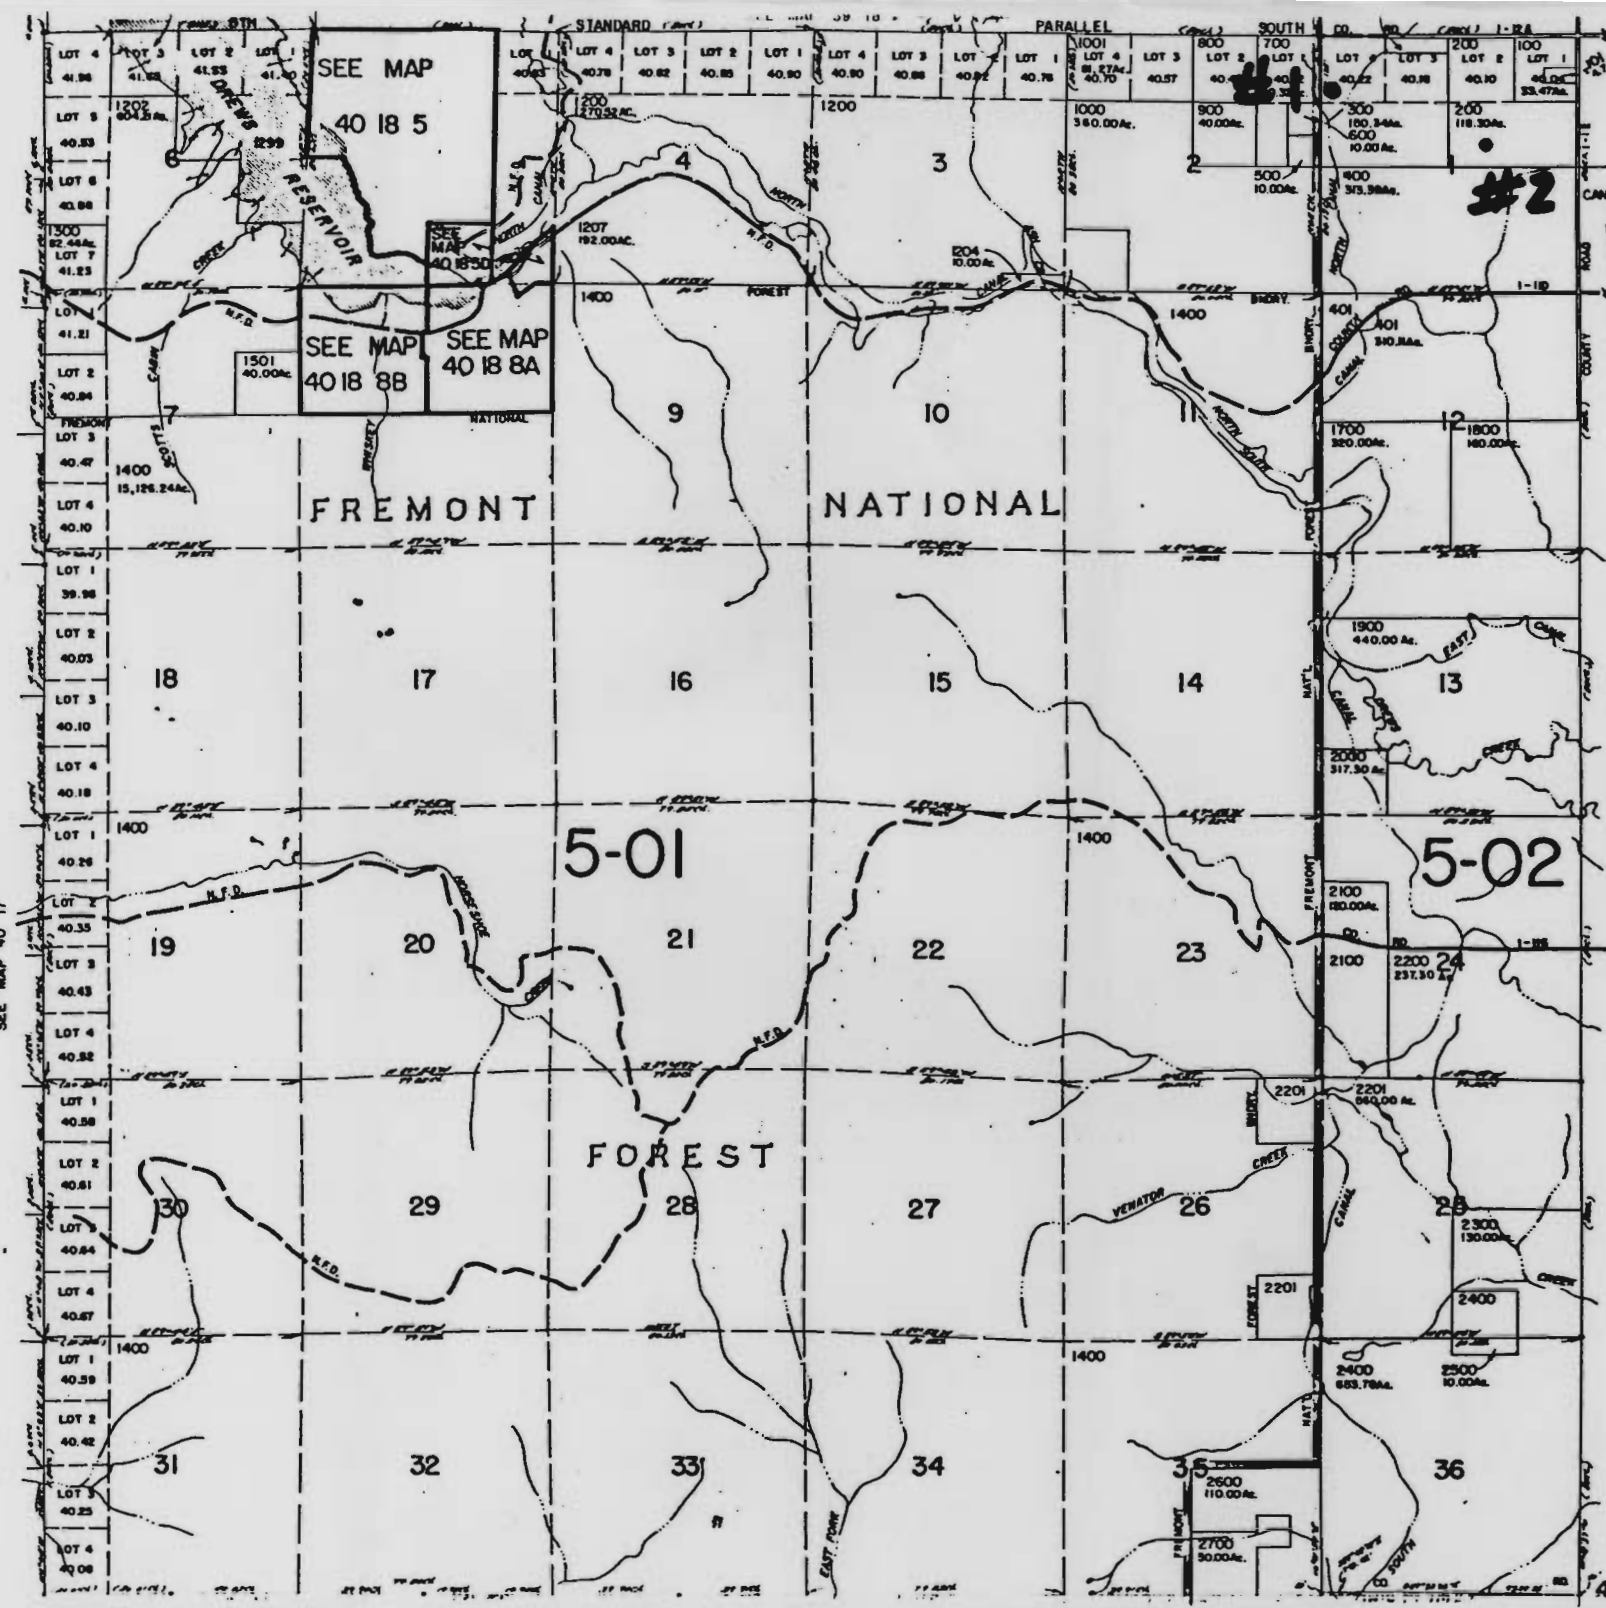

40 18
Index

#2

CANCELLED NO 3
1203
1205
1230
1500
1101
1100
1201
1206
1600

SEE MAP 40 19

40 18