

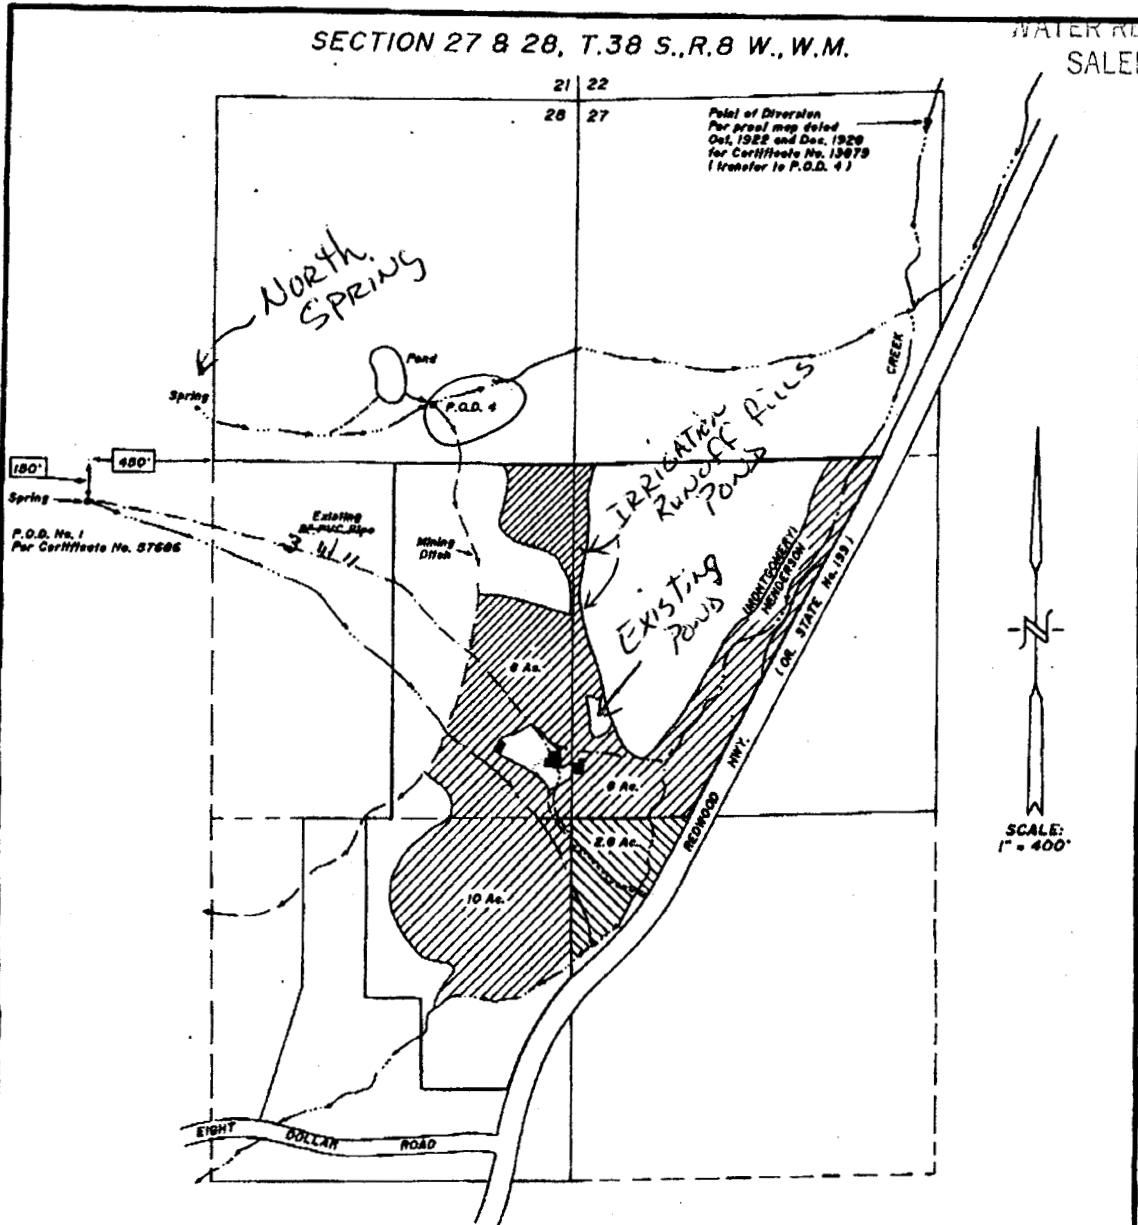
71738

RECEIVED



JAN - 4 1995

WATER RESOURCES DEPT.
SALEM, OREGON

SECTION 27 & 28, T.38 S., R.8 W., W.M.



LEGEND:

-  PLACE OF USE APPROVED BY CERTIFICATE NO. 13879 PRIORITY DATE = 1903
-  UNAPPROVED PLACE OF USE (BLM PROPERTY)
-  EXISTING BUILDING

P.O.D. 4 - PROPOSED PRIMARY POINT OF DIVERSION
200W AND 800E OF NE COR. SW NE

THE PURPOSE OF THIS APPLICATION IS TO TRANSFER THE POINT OF DIVERSION FROM THE HILDEBRANDT DITCHES (WHICH NO LONGER EXISTS) TO P.O.D. 4 AS SHOWN AND ADDITIONAL DIVERSION POINTS ALONG THE MINING DITCH FOR FLOOD IRRIGATION.

THIS PLAT WAS PREPARED FOR THE PURPOSE OF IDENTIFYING THE LOCATION OF THE WATER RIGHT ONLY. THERE IS NO INTENT TO PROVIDE DIMENSIONS OR LOCATIONS OF PROPERTY OWNERSHIP LINES.

Application No. R-80052
Permit No.

PROJECT NO. 215-92-165	PLAT OF WATER RIGHT TRANSFER <small>LOCATED IN SW 1/4 NW 1/4 SEC. 27, AND SE 1/4 NE 1/4, NE 1/4 SE 1/4 SEC. 28, T.38 S., R.8 W., W.M. JOSEPHINE COUNTY, OREGON</small>
DRAWING NO. 18-11.17	
DATE 4-6-92	
SCALE 1" = 400'	
PREPARED FOR: TRIANGLE 3 RANCH 600 EIGHT DOLLAR MOUNTAIN ROAD KERBY, OREGON 97531 TEL. 592-2663	PREPARED BY: GARY D. WICKS, P.E., P.L.S. CIVIL ENGINEER & LAND SURVEYOR 962 S.E. "M" STREET GRANTS PASS, OREGON 97526-3250 TEL. 479-3436