

Application No. R-80057
Permit No. IN 4 34


RECEIVED

JAN - 5 1995

WATER RESOURCES DEP.
SALEM, OREGON

71743

"CERTIFICATE NO."

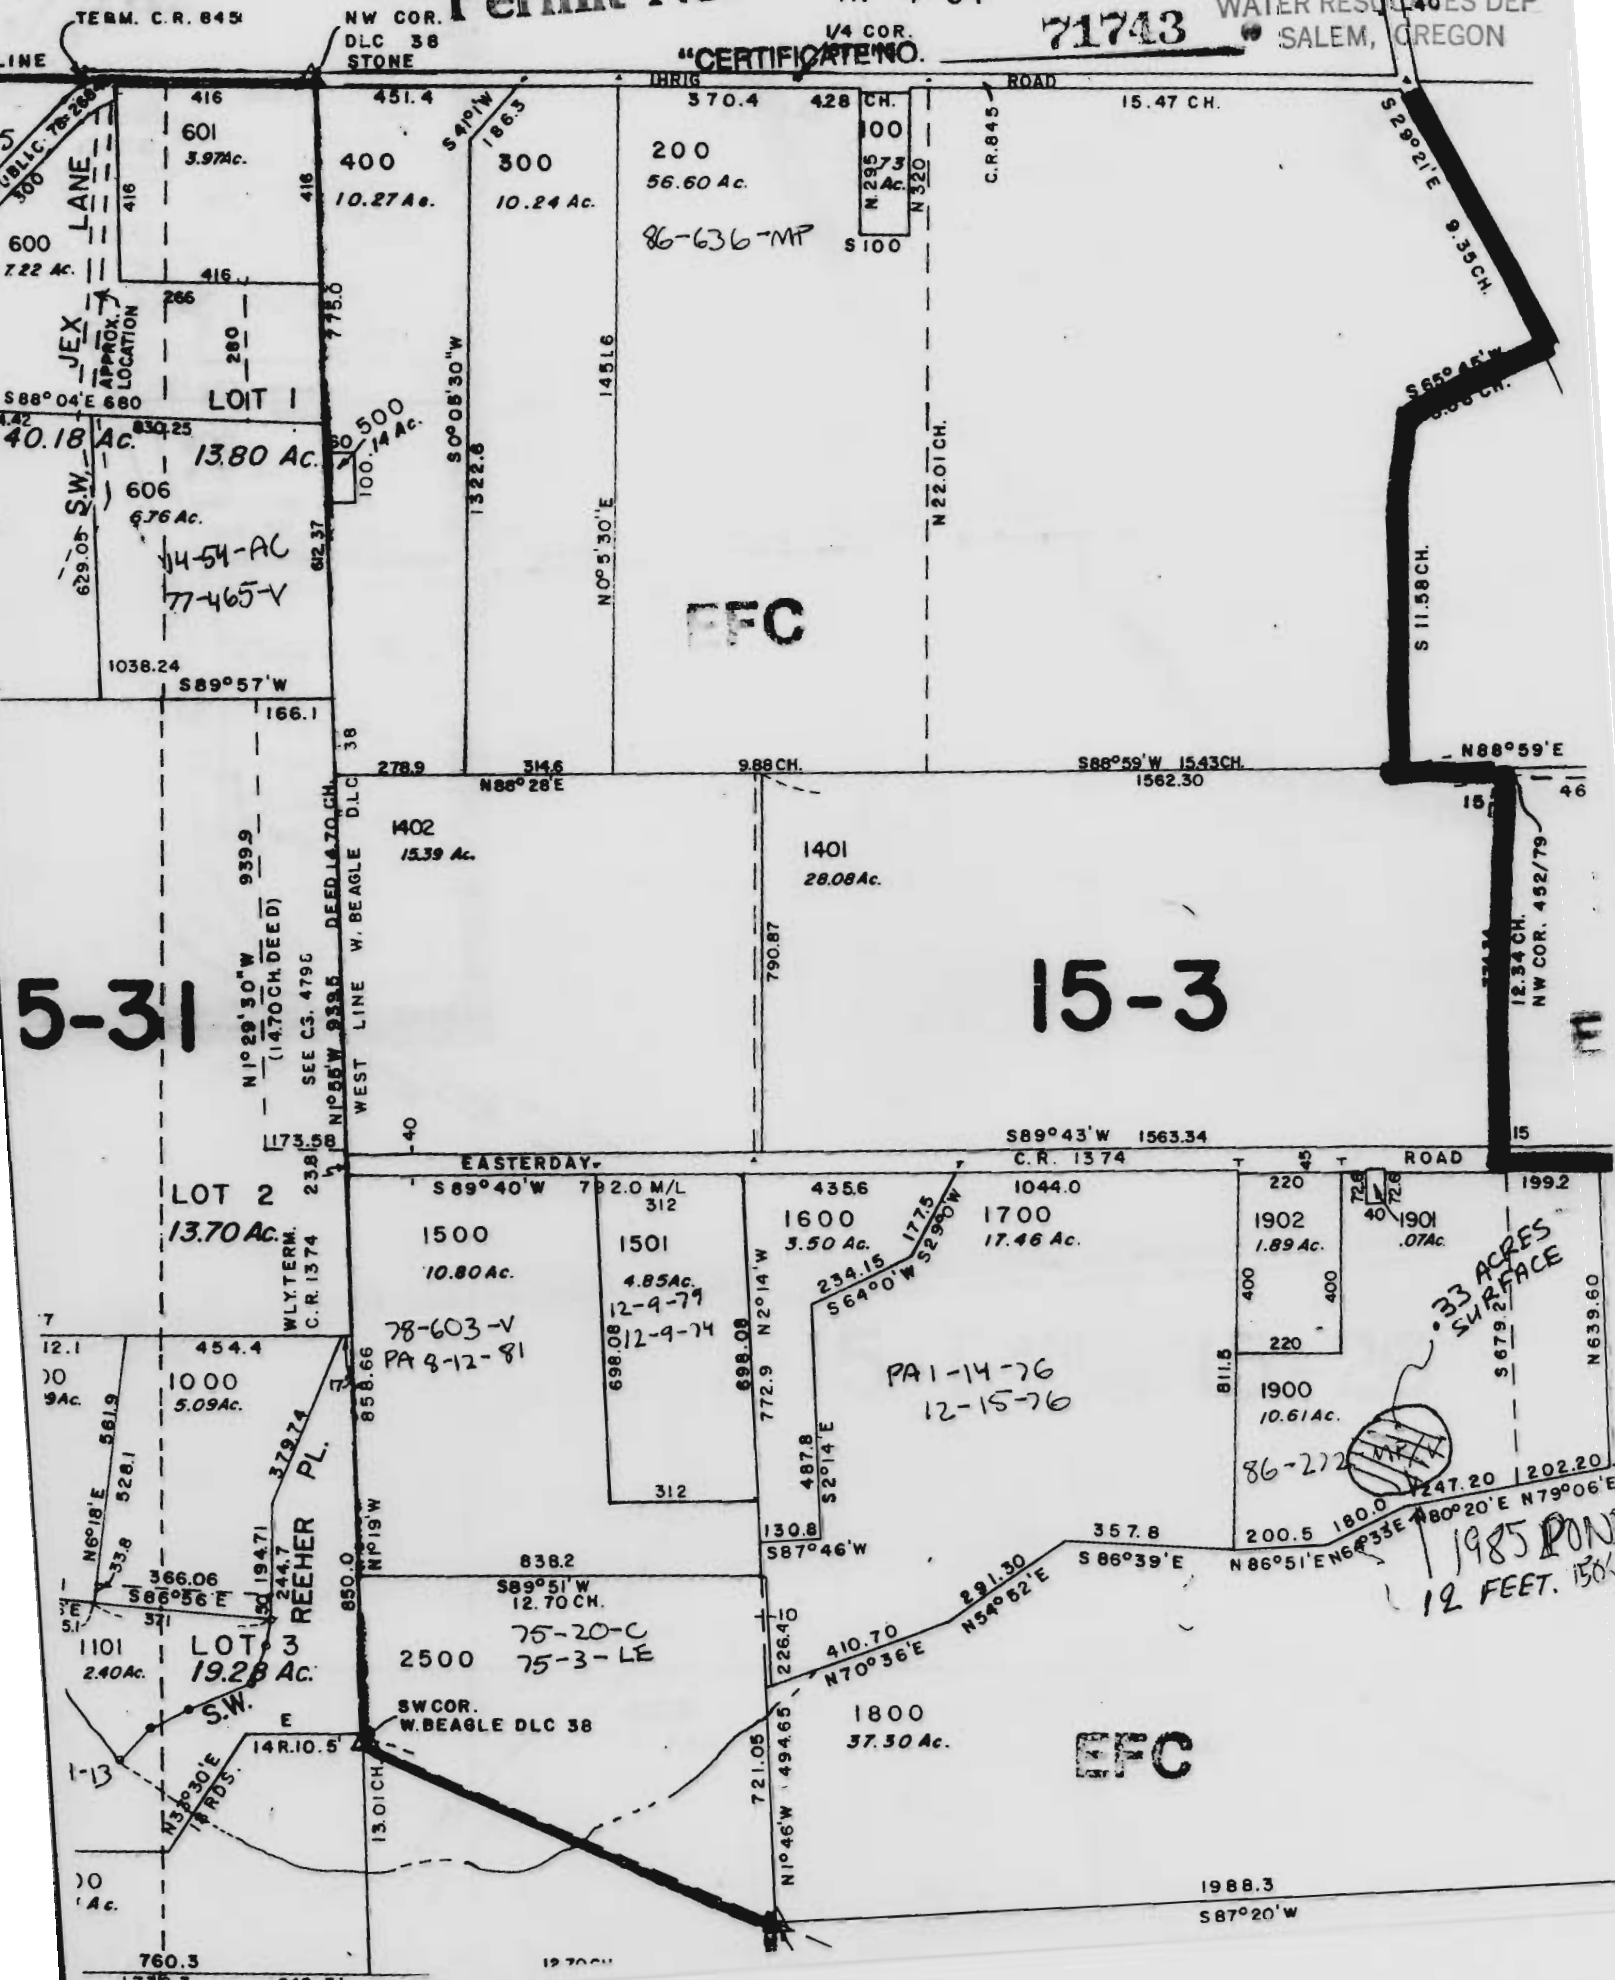

5-31

15-3

33 ACRES SURFACE

1985 POND
12 FEET. 150x1

EFC

EFC

1988.3
S87°20'W