


Application No. R-80061
Permit No. 71747
"CERTIFICATE NO. 71747"

D Mc D Ranch, Existing Stock Water Ponds
on Chesnimnus Creek Drainage in Wallowa County

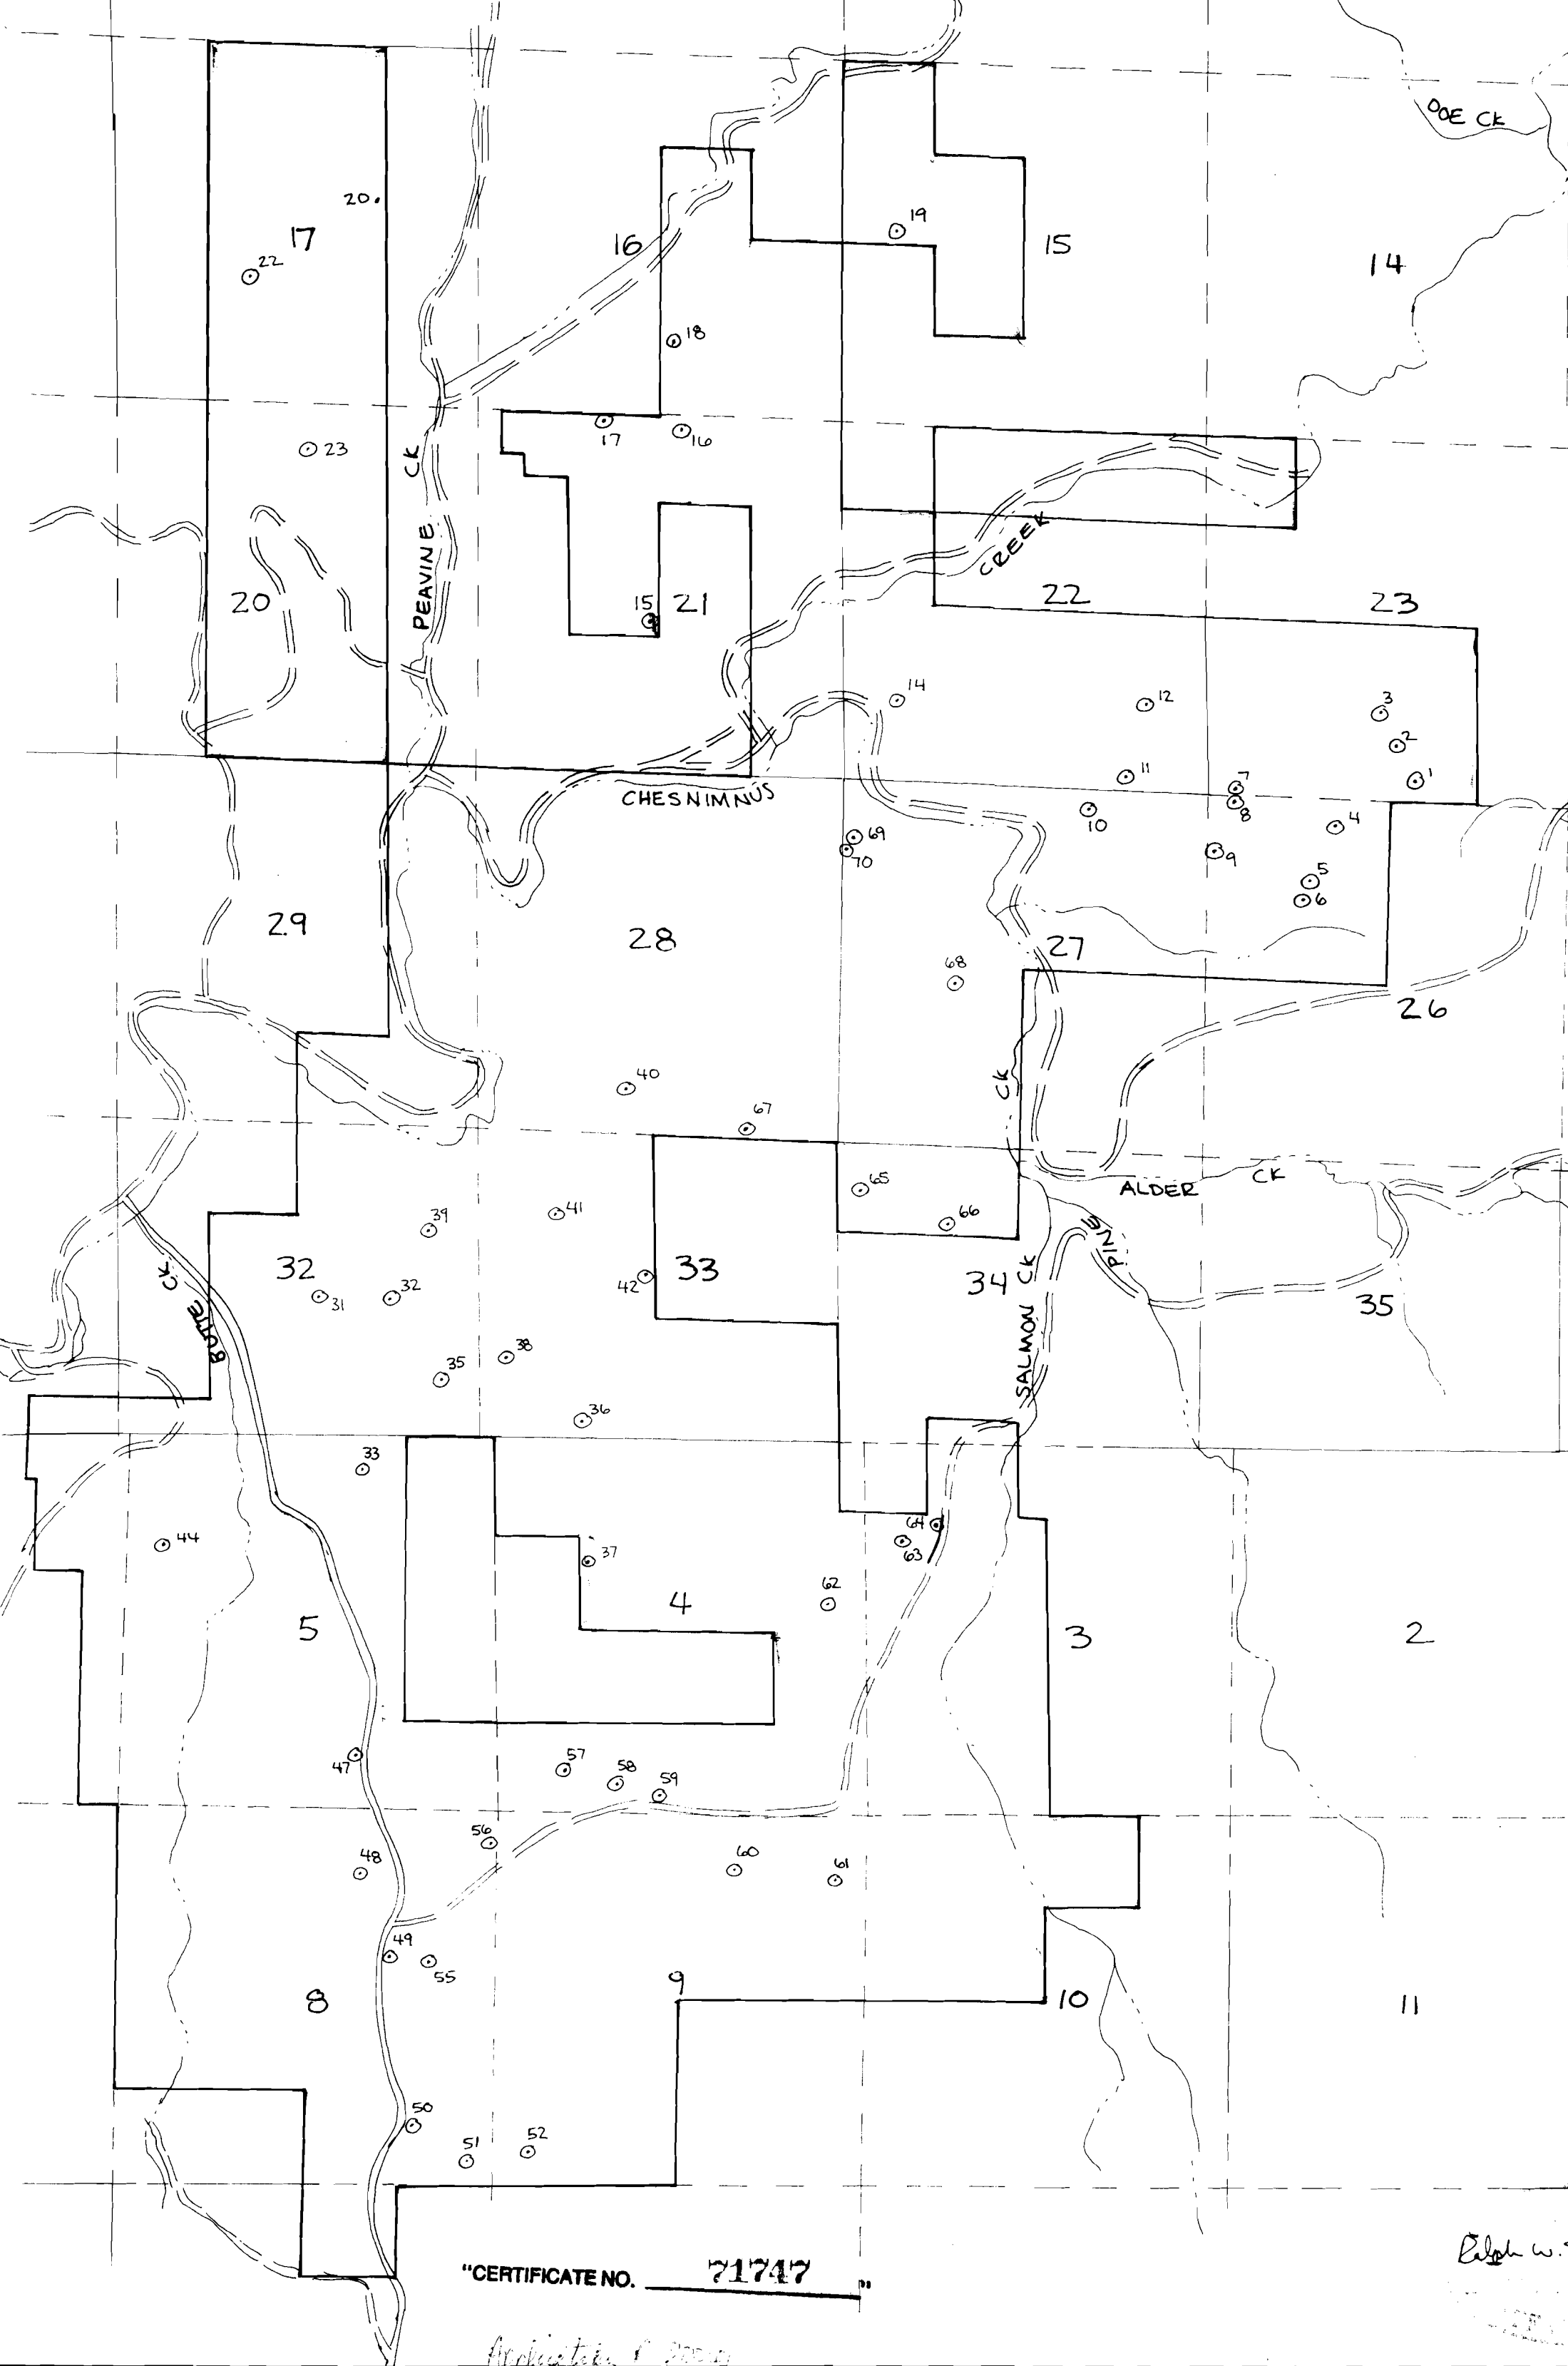

APPLICATION No.	POND No.	Corner ties	in Sec.	Area sq.ft.	Depth ft	Volume
1	63	1400'S 550'E of NW corner	Sec 3	3,2N46E 3,800	6	0.3 AF
1	64	1150'S 1150'E of NW corner	Sec 3	" 1,800	6	0.2 AF
1	37	1800'S 1350'E of NW corner	Sec 4	4,2N46E 4,600	6	0.3 AF
1	57	600'N 1000'E of SW corner	Sec 4	" 1,800	6	0.2 AF
1	58	450'N 1700'E of SW corner	Sec 4	" 1,800	6	0.2 AF
1	59	250'N 2350'E of SW corner	Sec 4	" 4,500	6	0.3 AF
1	62	2350'S 530'W of NE corner	Sec 4	" 3,800	6	0.3 AF
1	33	500'S 1950'W of NE corner	Sec 5	5,2N46E 1,400	6	0.1 AF
1	44	1600'S 500'E of NW corner	Sec 5	" 3,200	6	0.2 AF
1	47	750'N 2050'W of SE corner	Sec 5	" 700	3	0.1 AF
2	48	900'S 2000'W of NE corner	Sec 8	8,2N46E 5,000	7	0.4 AF
2	49	2150'S 1650'W of NE corner	Sec 8	" 7,400	4	0.4 AF
2	50	850'N 1200'W of SE corner	Sec 8	" 2,700	6	0.2 AF
2	51	350'N 400'W of SE corner	Sec 8	" 1,800	6	0.2 AF
2	55	2200'S 1000'W of NE corner	Sec 8	" 7,200	8	0.7 AF
2	56	450'S 100'W of NE corner	Sec 8	" 1,800	6	0.2 AF
2	52	500'E 500'N of SW corner	Sec 9	9,2N46E 1,800	6	0.2 AF
2	60	750'S 1900'W of NE corner	Sec 9	" 1,800	6	0.2 AF
2	61	900'S 450'W of NE corner	Sec 9	" 1,800	6	0.2 AF
1	19	2750'N 800'E of SW corner	Sec 15	15,3N46E 27,200	9.2	2.9 AF
3	18	1080'N 200'E of S 1/4 cor	Sec 16	16,3N46E 5,400	3.3	0.2 AF
3	20	3000'N 1440'W of SE corner	Sec 17	17,3N46E 2,000	6	0.2 AF
3	22	1850'N 3300'W of SE corner	Sec 17	" 1,250	6	0.1 AF
3	23	650'S 2400'W of NE corner	Sec 20	20,3N46E 7,800	6	0.6 AF
3	15	2550'E 2150'N of SW corner	Sec 21	21,3N46E 9,000	8.8	0.9 AF
3	16	150'S 300'E of N 1/4 cor	Sec 21	" 25,900	5	1.5 AF
3	17	800'W 75'S of "	"	" 2,600	6	0.2 AF
3	11	200'N 1200'W of SE corner	Sec 22	22,3N46E 10,400	9	1.1 AF
3	12	1300'N 900'W of SE corner	Sec 22	" 1,700	5	0.1 AF
3	13	95'W 100'S of Cent 1/4	Sec 22	" 2,400	7	0.2 AF
3	14	800'E 1150'N of SW corner	Sec 22	" 14,000	9	1.5 AF
4	1	350'N 335'E of S 1/4 cor	Sec 23	23,3N46E 5,400	5	0.3 AF
4	2	845'N 30'E of S 1/4 cor	Sec 23	" 4,500	5	0.3 AF
4	3	1330'N 160'W of S 1/4 cor	Sec 23	" 4,400	5	0.3 AF
4	7	75'N 400'E of SW corner	Sec 23	" 2,600	4	0.2 AF
2	4	400'S 1800'E of NW corner	Sec 26	26,3N46E 24,800	8	2.3 AF
5	5	1150'S 1500'E of NW corner	Sec 26	" 10,500	9	1.1 AF
4	6	1445'S 1400'E of NW corner	Sec 26	" 12,700	9	1.3 AF
4	8	75'S 400'E of NW corner	Sec 26	" 2,300	4	0.1 AF
4	9	775'S 80'E of NW corner	Sec 26	" 2,800	4	0.2 AF
5	10	300'S 1750'W of NE corner	Sec 27	27,3N46E 11,000	9	1.2 AF
5	68	2900'S 1650'E of NW corner	Sec 27	" 2,900	6	0.2 AF
5	69	800'S 100'E of NW corner	Sec 27	" 4,200	6	0.3 AF
5	70	1000'S 10'E of NW corner	Sec 27	" 2,000	4	0.1 AF
5	40	650'N 2150'E of SW corner	Sec 28	28,3N46E 5,000	7	0.4 AF
5	67	150'N 1350'W of SE corner	Sec 28	" 3,800	6	0.3 AF
5	31	2000'N 2350'W of SE corner	Sec 32	32,3N46E 2,400	7	0.2 AF
5	32	2000'N 1300'W of SE corner	Sec 32	" 3,200	5	0.2 AF
5	35	850'N 600'W of SE corner	Sec 32	" 3,600	6	0.3 AF
5	39	3000'N 750'W of SE corner	Sec 32	" 10,000	8	1.0 AF
6	36	250'N 1500'E of SW corner	Sec 33	33,3N46E 6,600	6	0.5 AF
6	38	1150'N 360'E of SW corner	Sec 33	" 6,800	7	0.6 AF
6	41	1200'S 1100'E of NW corner	Sec 33	" 8,800	8	0.8 AF
6	42	2450'N 2450'E of SW corner	Sec 33	" 1,500	6	0.1 AF
6	65	700'S 300'E of NW corner	Sec 34	34,3N46E 2,500	6	0.2 AF
6	66	1100'S 1600'E of NW corner	Sec 34	" 4,200	6	0.3 AF

○ 99 = LOCATION & DESIGNATION OF POND
MAP IS DRAWN TO WALLOWA COUNTY ASSESSOR MAP SCALE. CORNER TIES TO PONDS ARE BASED ON LOCATING POND SITES ON USGS GREENWOOD BUTTE ORTHOQUADANGLE MAP FOR THIS AREA.
THIS MAP IS DRAWN FOR WATER RIGHT PURPOSES ONLY AND SHOULD NOT BE USED FOR PROPERTY LINE LOCATION

EXISTING POND WATER RIGHT APPLICATION MAP FOR
D Mc D CORPORATION, LOSTINE, OREGON
IN SECTIONS 3,4,5,8,9 T2N R46E
15,16,17,20,21,22,23,24,27,28,32,33,34 T3N,R46E
IN WALLOWA COUNTY

"CERTIFICATE NO. 71747"

Elph W. Simment