Klamath Rs. misc.

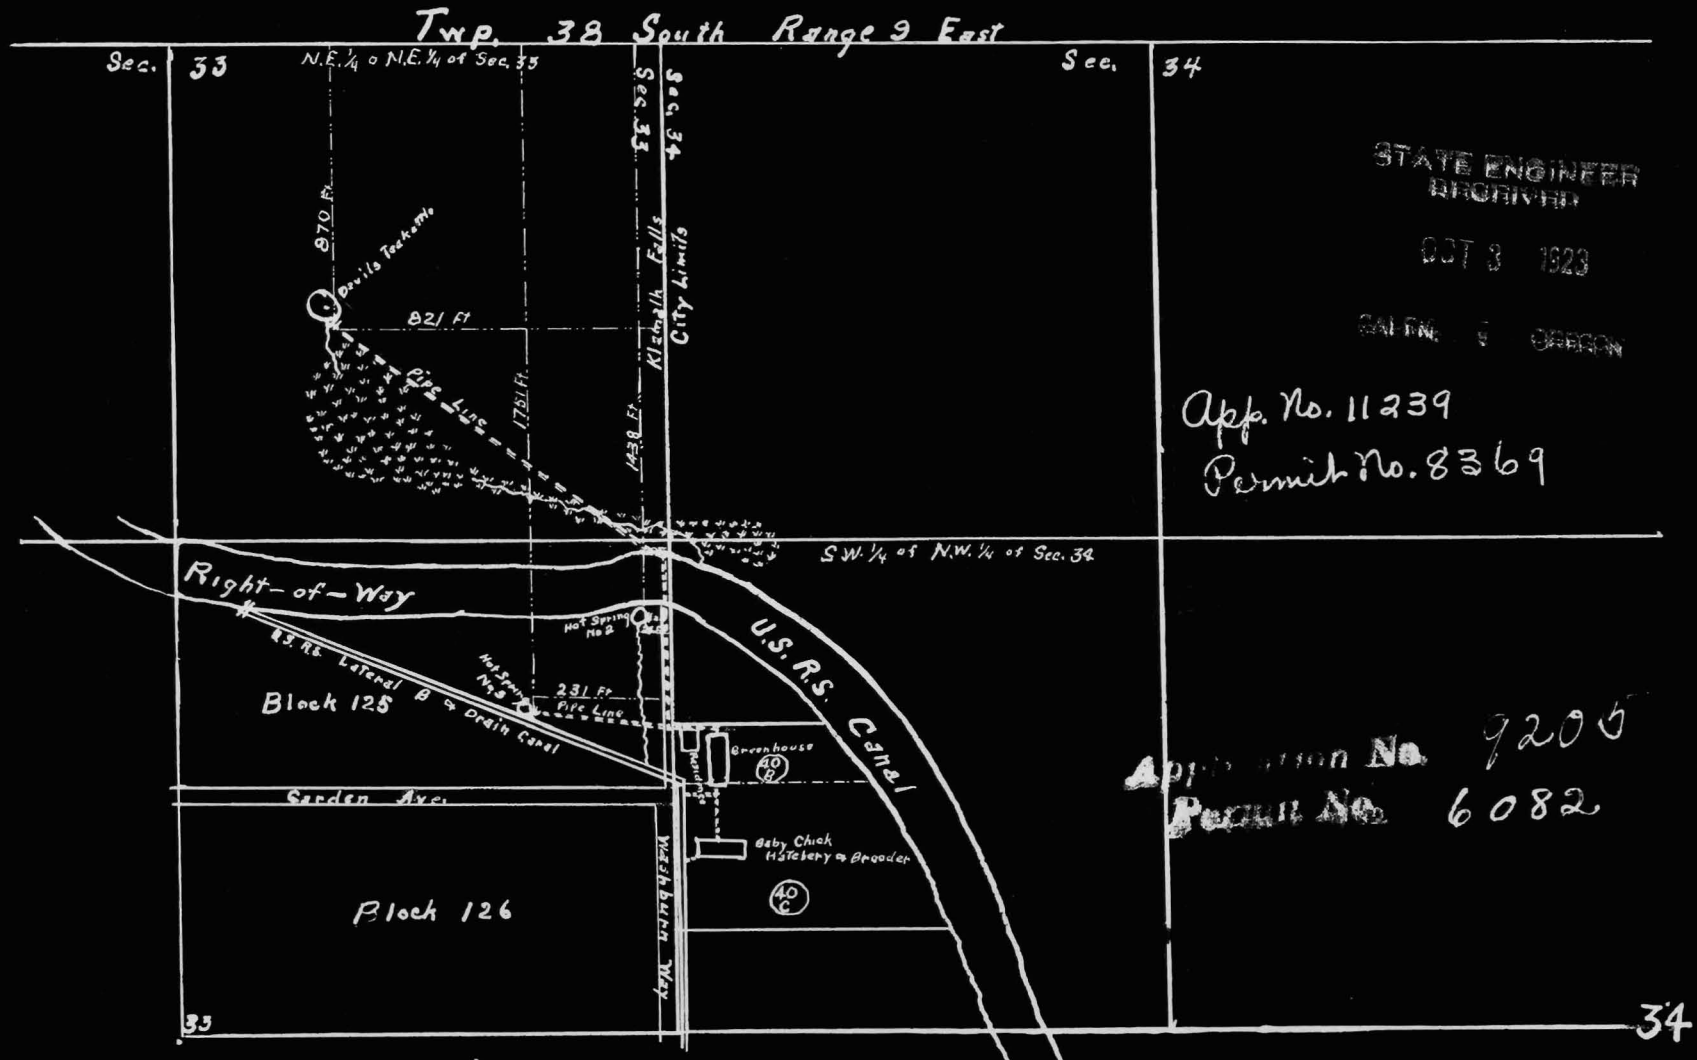


Scale 1/2" = one Mile

# Lewis Heating Project Map

Accompanying Application to Appropriate Water

September 27 1923

6082