


RECORDED

JAN - 4 1995

WATER RESOURCES DEPT.  
SALEM, OREGON

T5S R  
Gilliam Co


SEE MAP

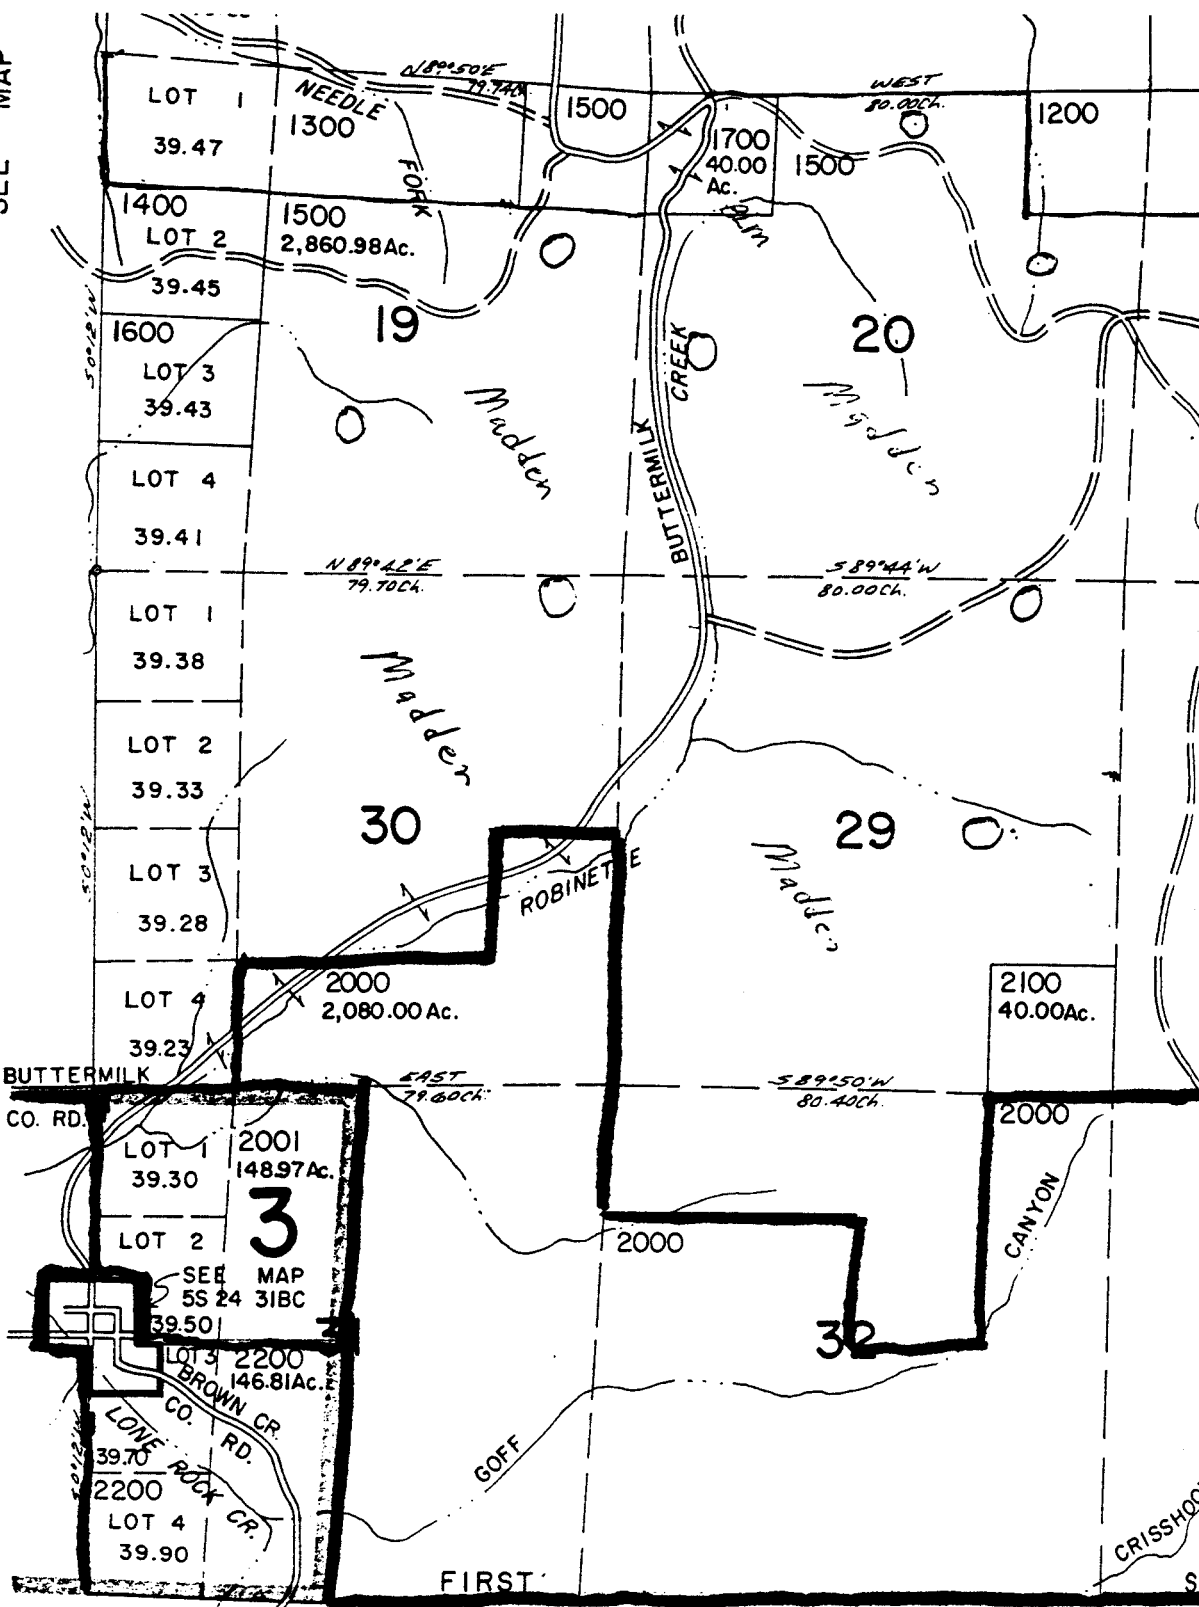

SEE MAP  
5S 24 31BC

SEE MAP 6


R24E  
County

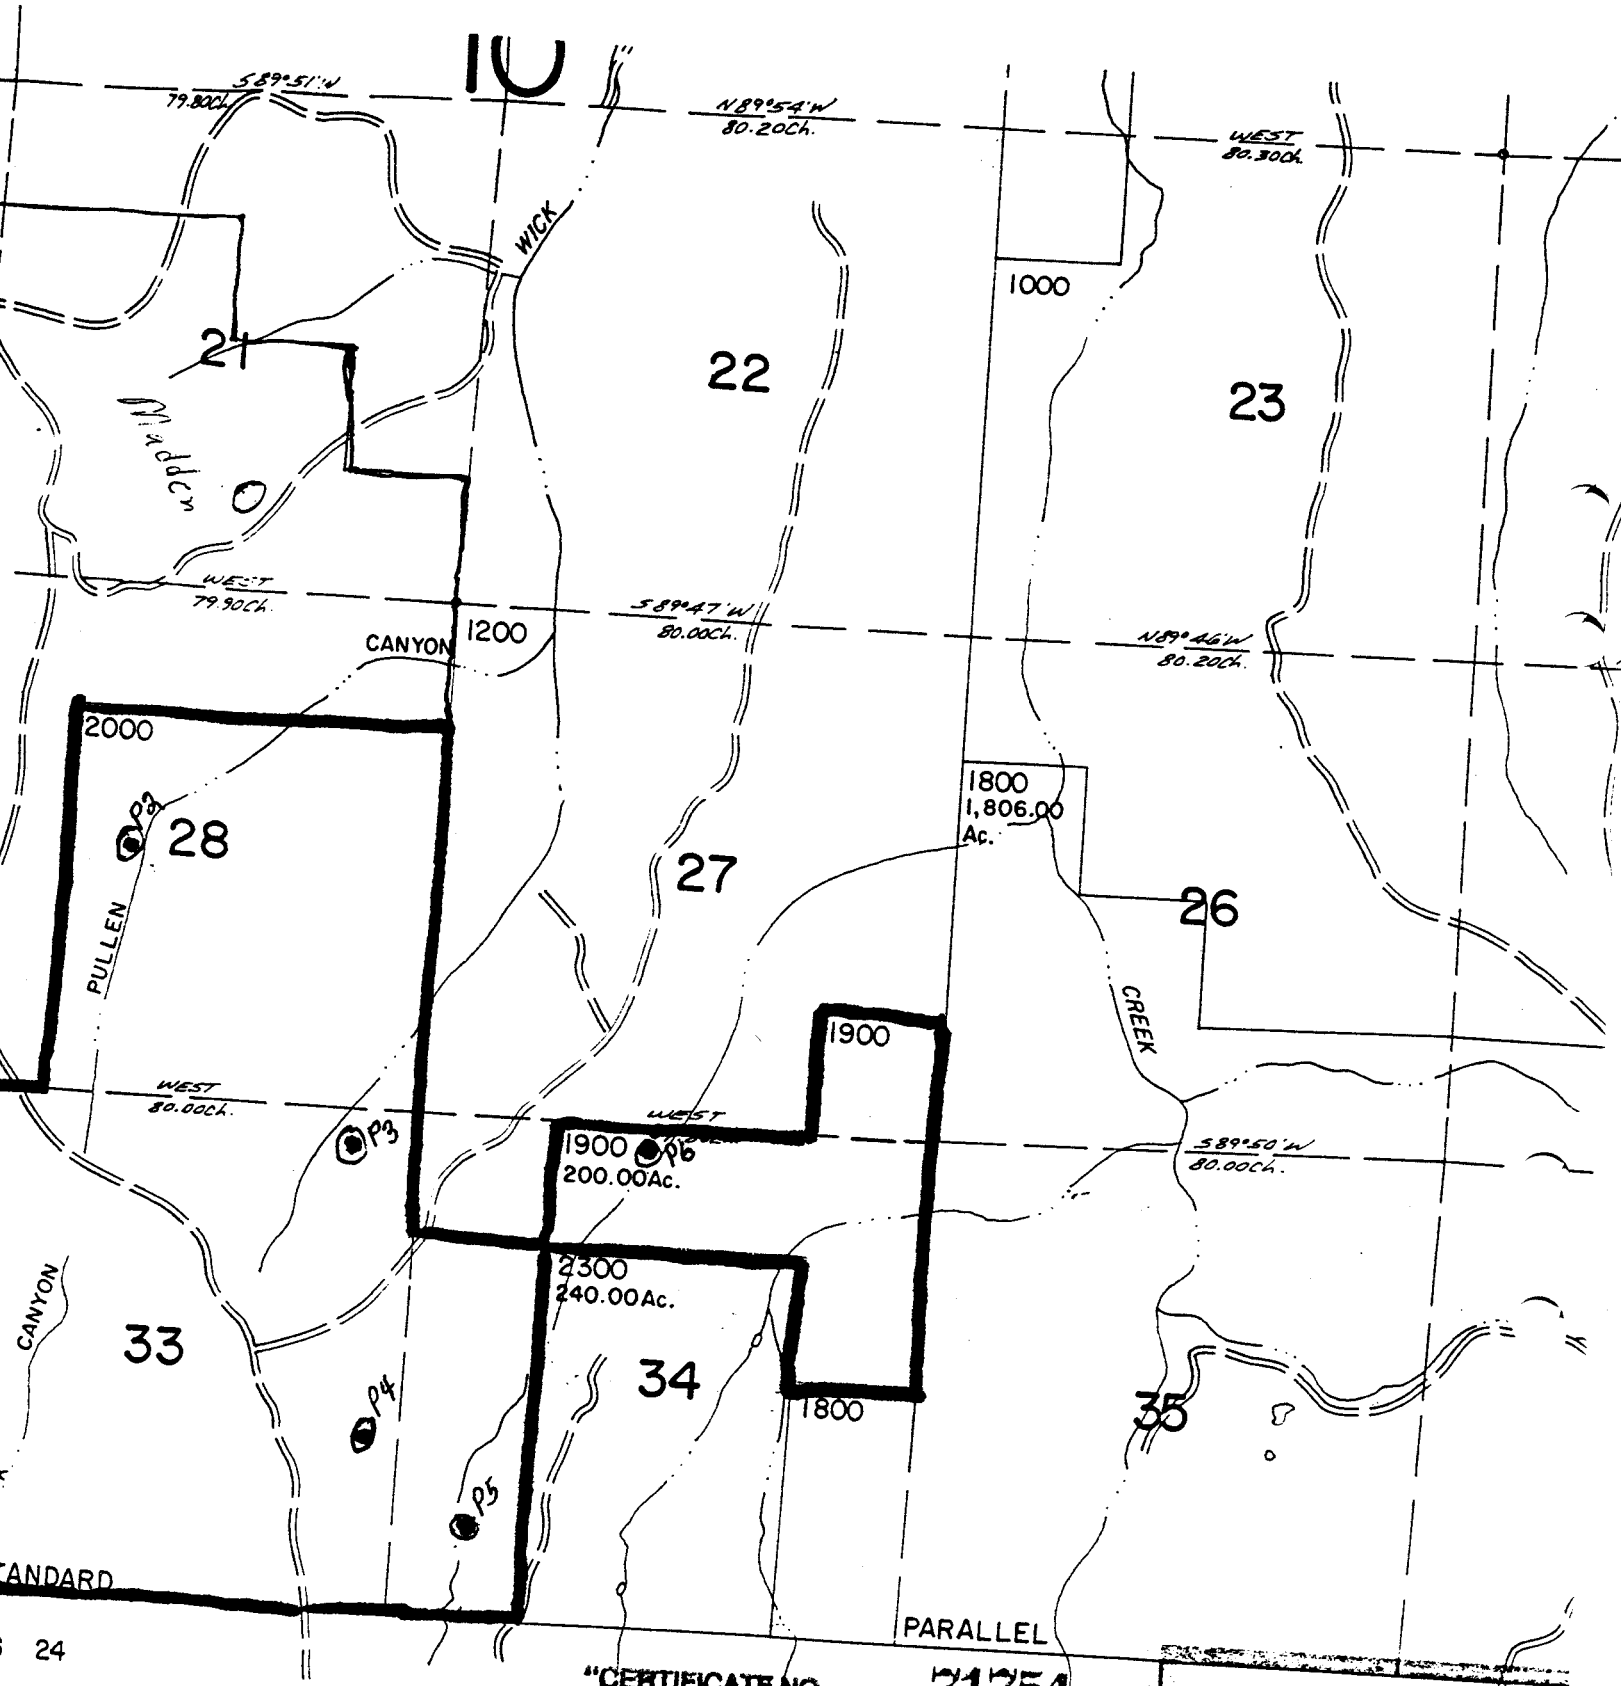

"CERTIFICATE NO. 71754"

MORROW

Application No. R-80064  
Permit No.

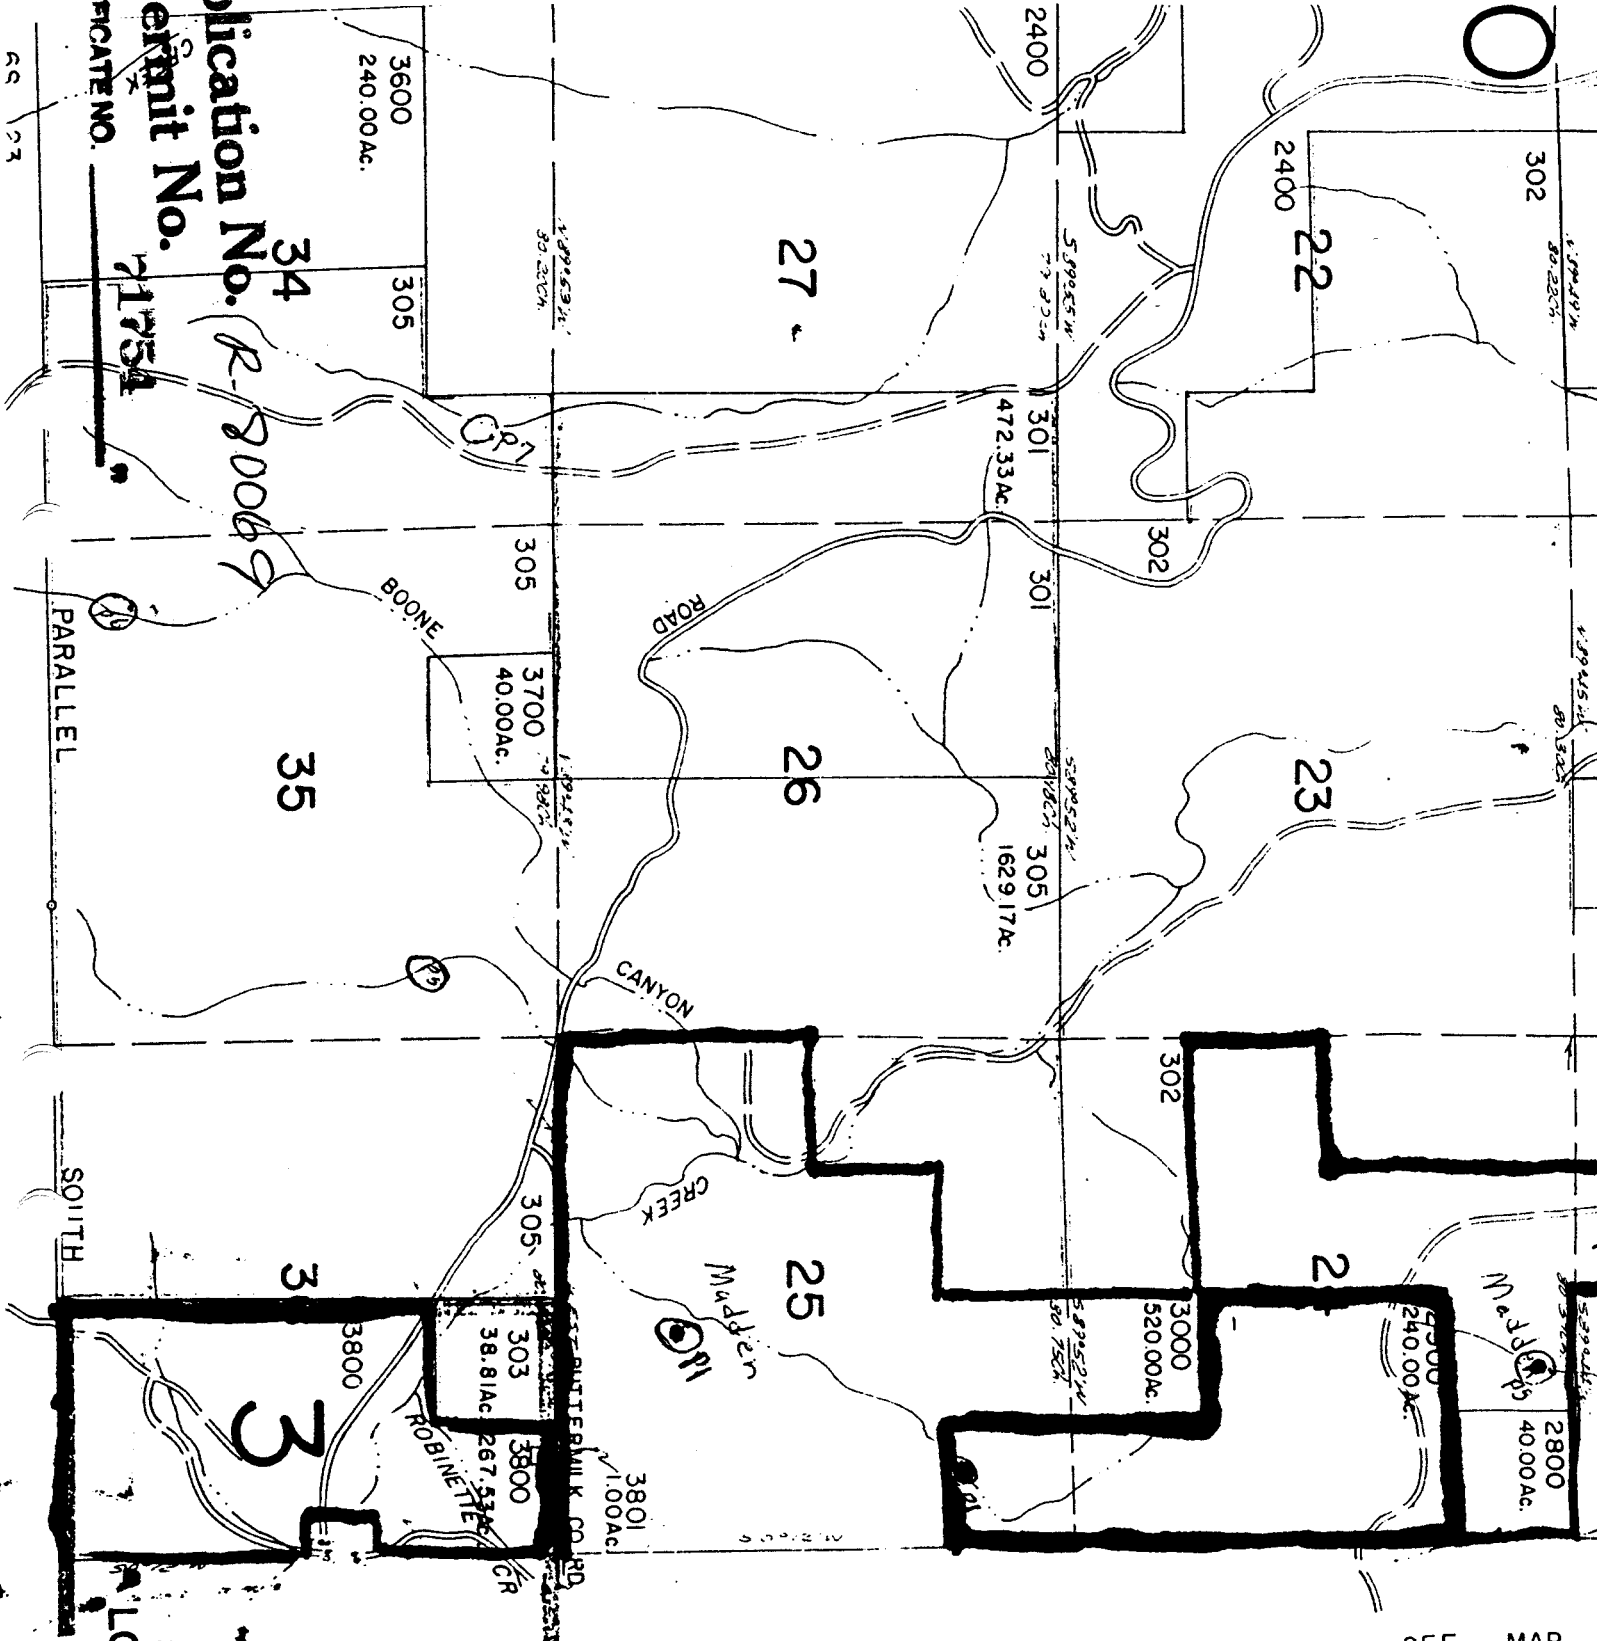


Application No. R-80069  
 Permit No. 71754  
 "CERTIFICATE NO. \_\_\_\_\_"

SEE MAP

T5S-R23E

5S 23  
 LONEROCK

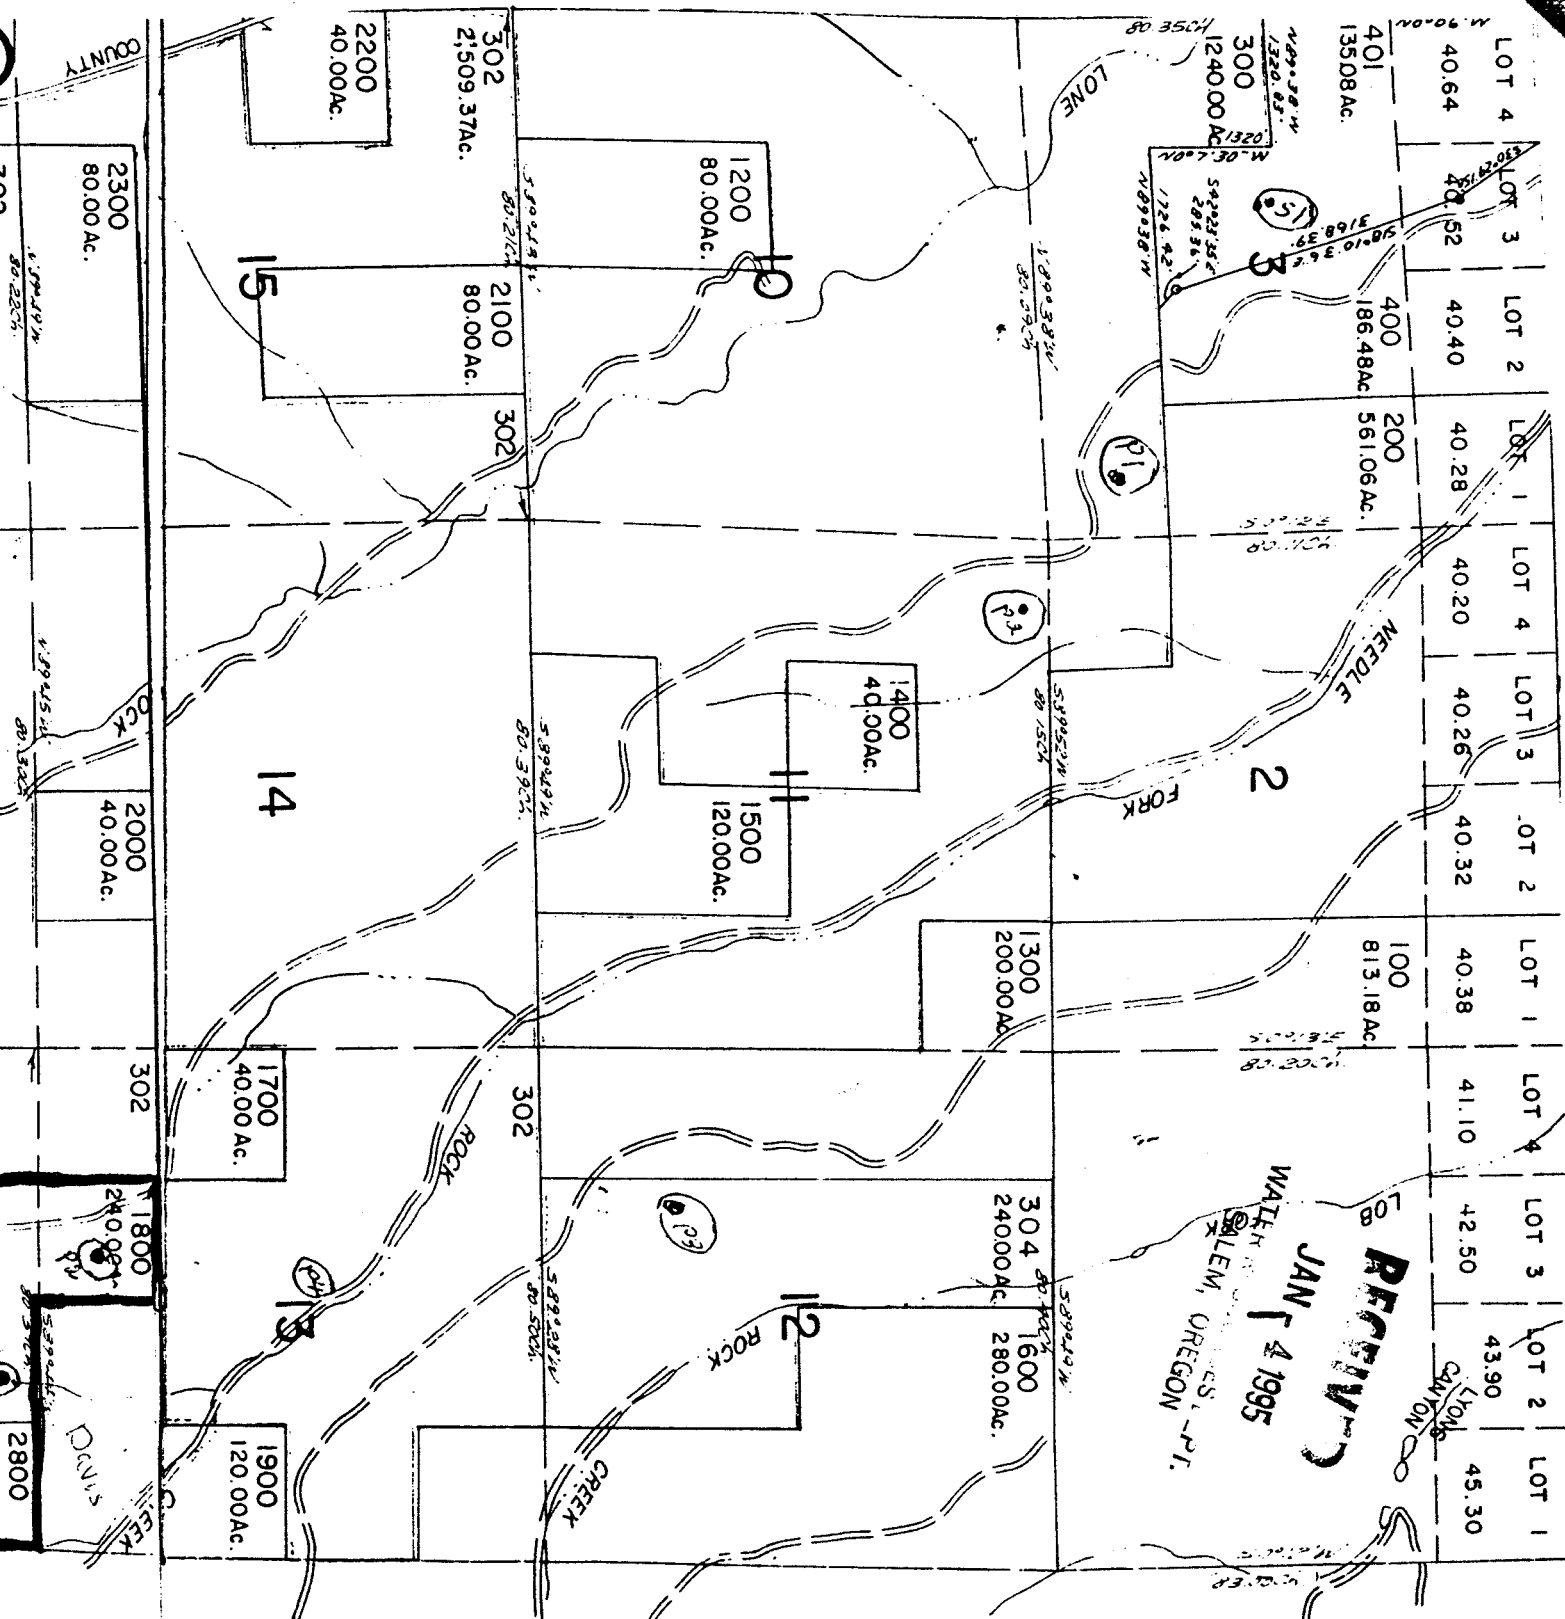

LOT 4	LOT 3	LOT 2	LOT 1	LOT 4	LOT 2	LOT 1	LOT 4	LOT 3	LOT 2	LOT 1
401 13508Ac.	401 40.52	400 186.48Ac.	200 561.06Ac.	404 40.20	402 40.32	100 813.18Ac.	404 41.10	403 42.50	402 43.90	401 45.30

**RECEIVED**  
 JAN 4 1995  
 SALEM, OREGON - PT.  
 FOR CALYON

CANCELLED  
 NUMBERS  
 600 U1  
 600 U2