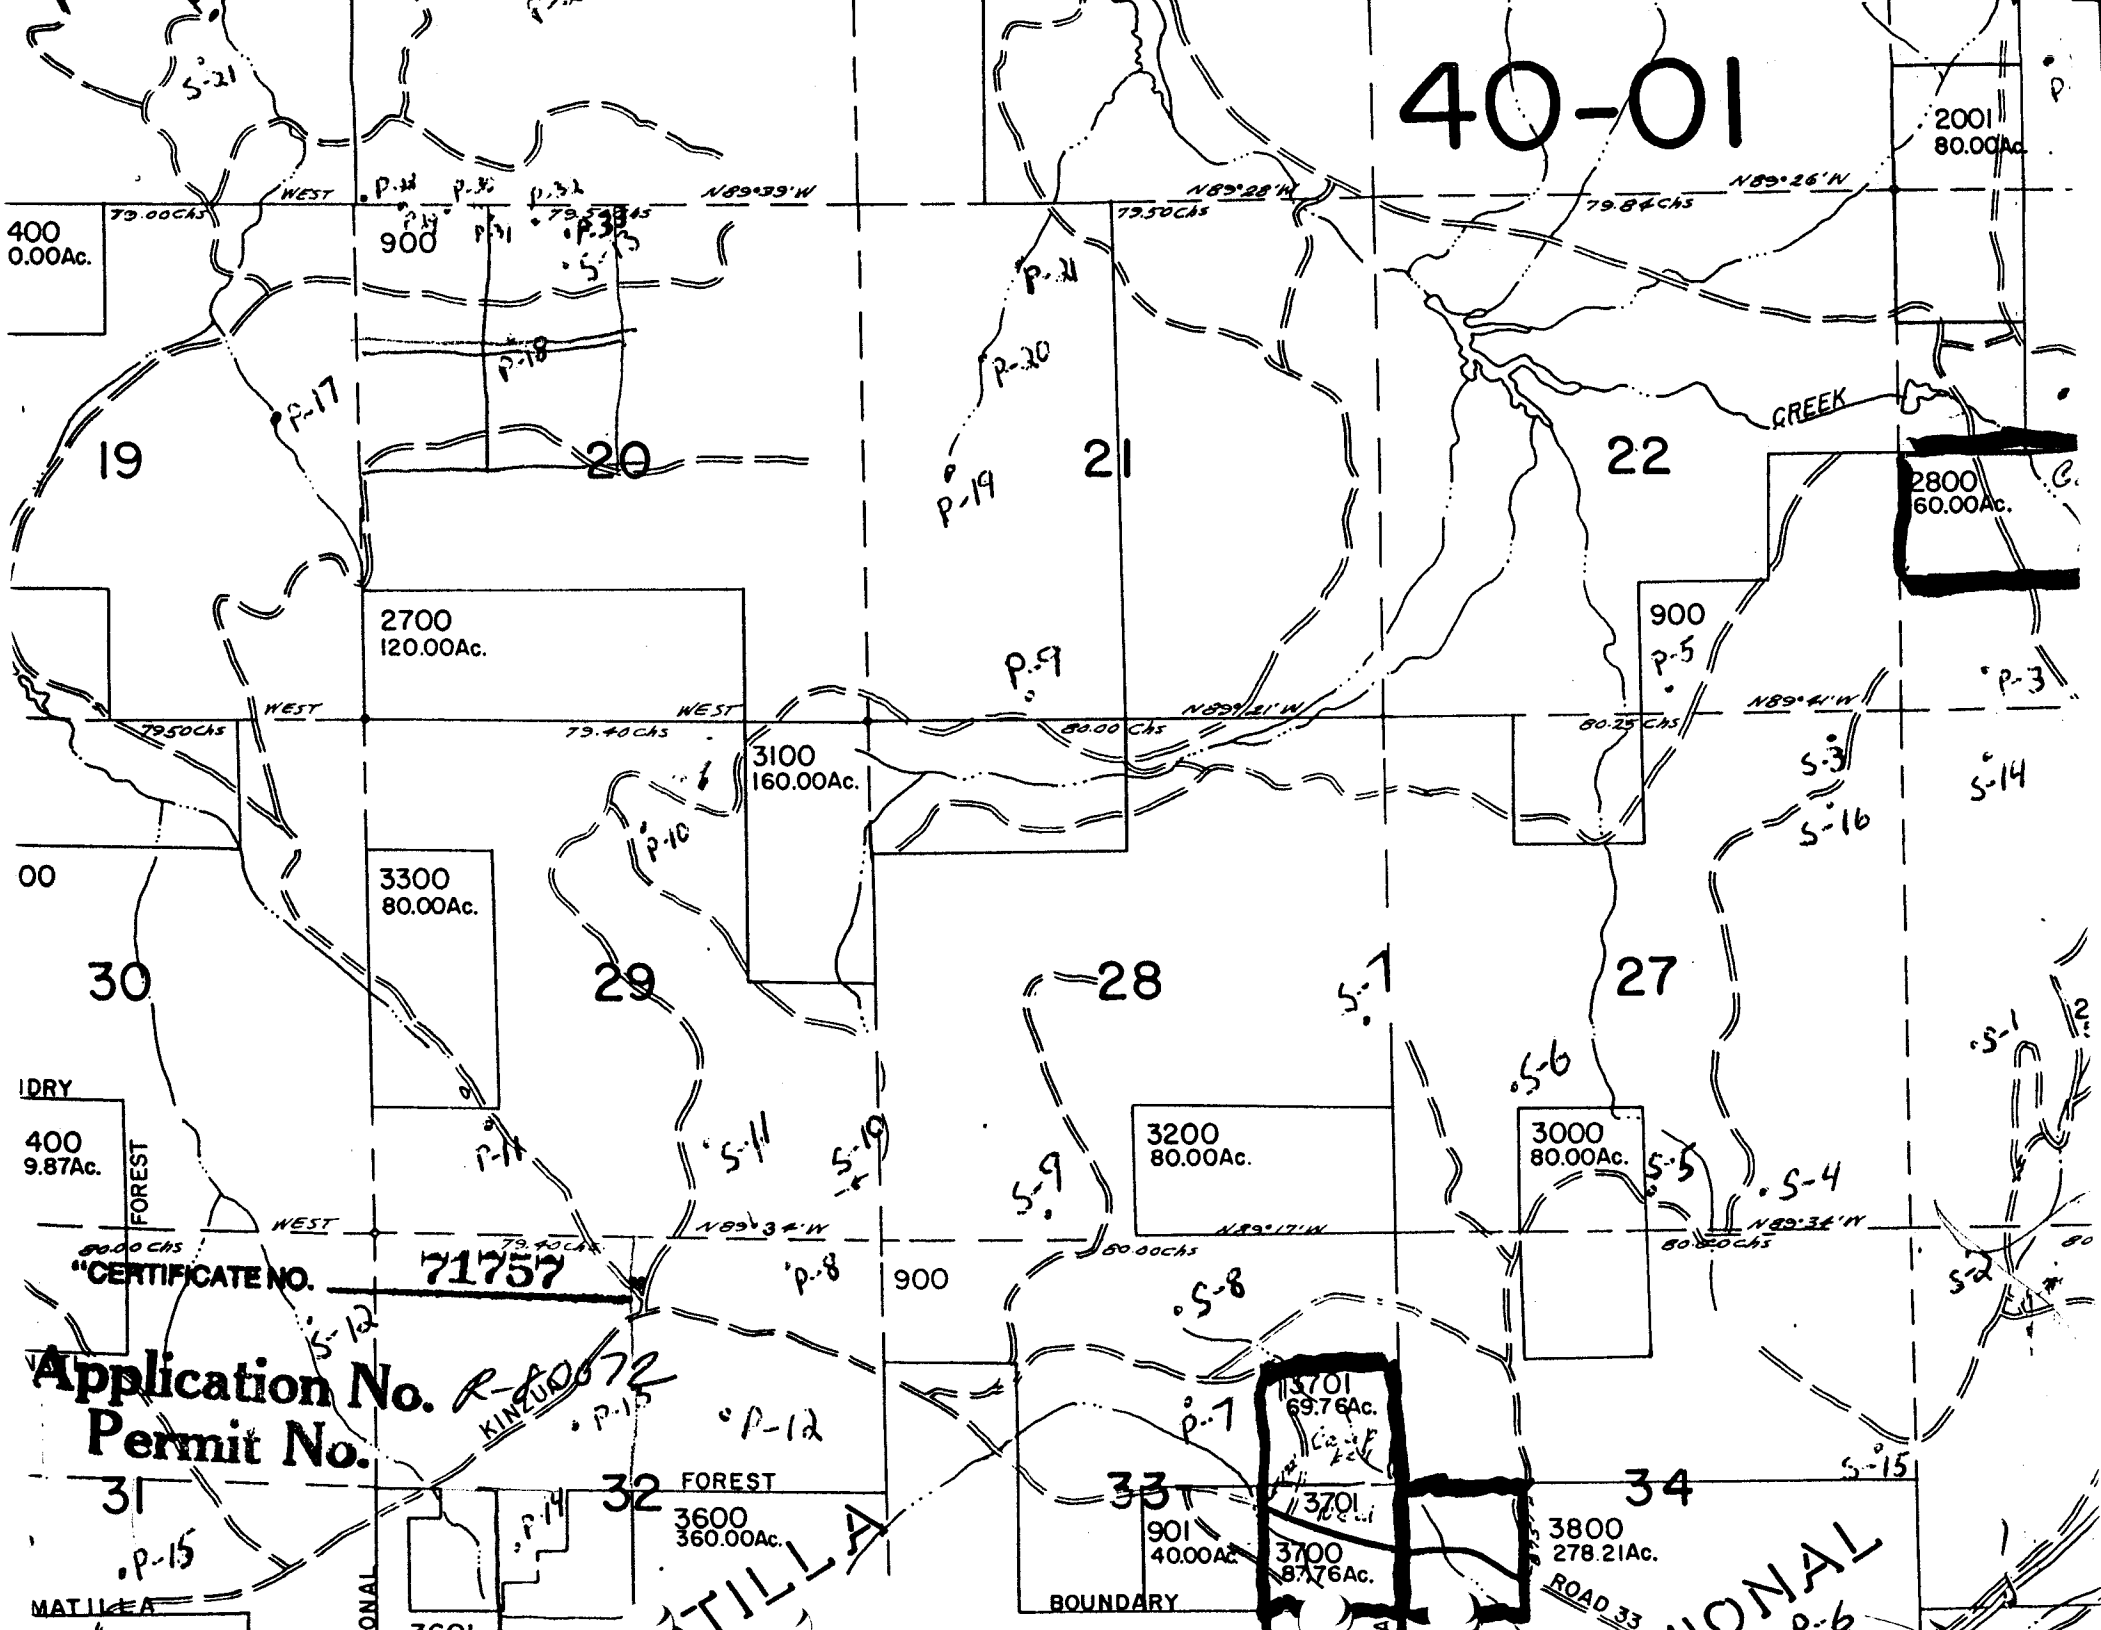
40-01
19
20
21
22
29
28
27
30
31
32
33
34
400
0.00Ac.
900
2700
120.00Ac.
3100
160.00Ac.
3300
80.00Ac.
2001
80.00Ac.
2800
60.00Ac.
900
3200
80.00Ac.
3000
80.00Ac.
400
9.87Ac.
3701
69.76Ac.
3701
3700
87.76Ac.
3800
278.21Ac.
901
40.00Ac.
3600
360.00Ac.
CREEK
FOREST
BOUNDARY
ROAD 33
WEST
N89°39'W
N89°28'W
N89°26'W
N89°21'W
N89°41'W
N89°34'W
N89°17'W
79.00chs
79.50chs
79.84chs
79.40chs
80.00chs
60.25chs
"CERTIFICATE NO. 71757
Application No. R-40072
Permit No.
KINZUA
