


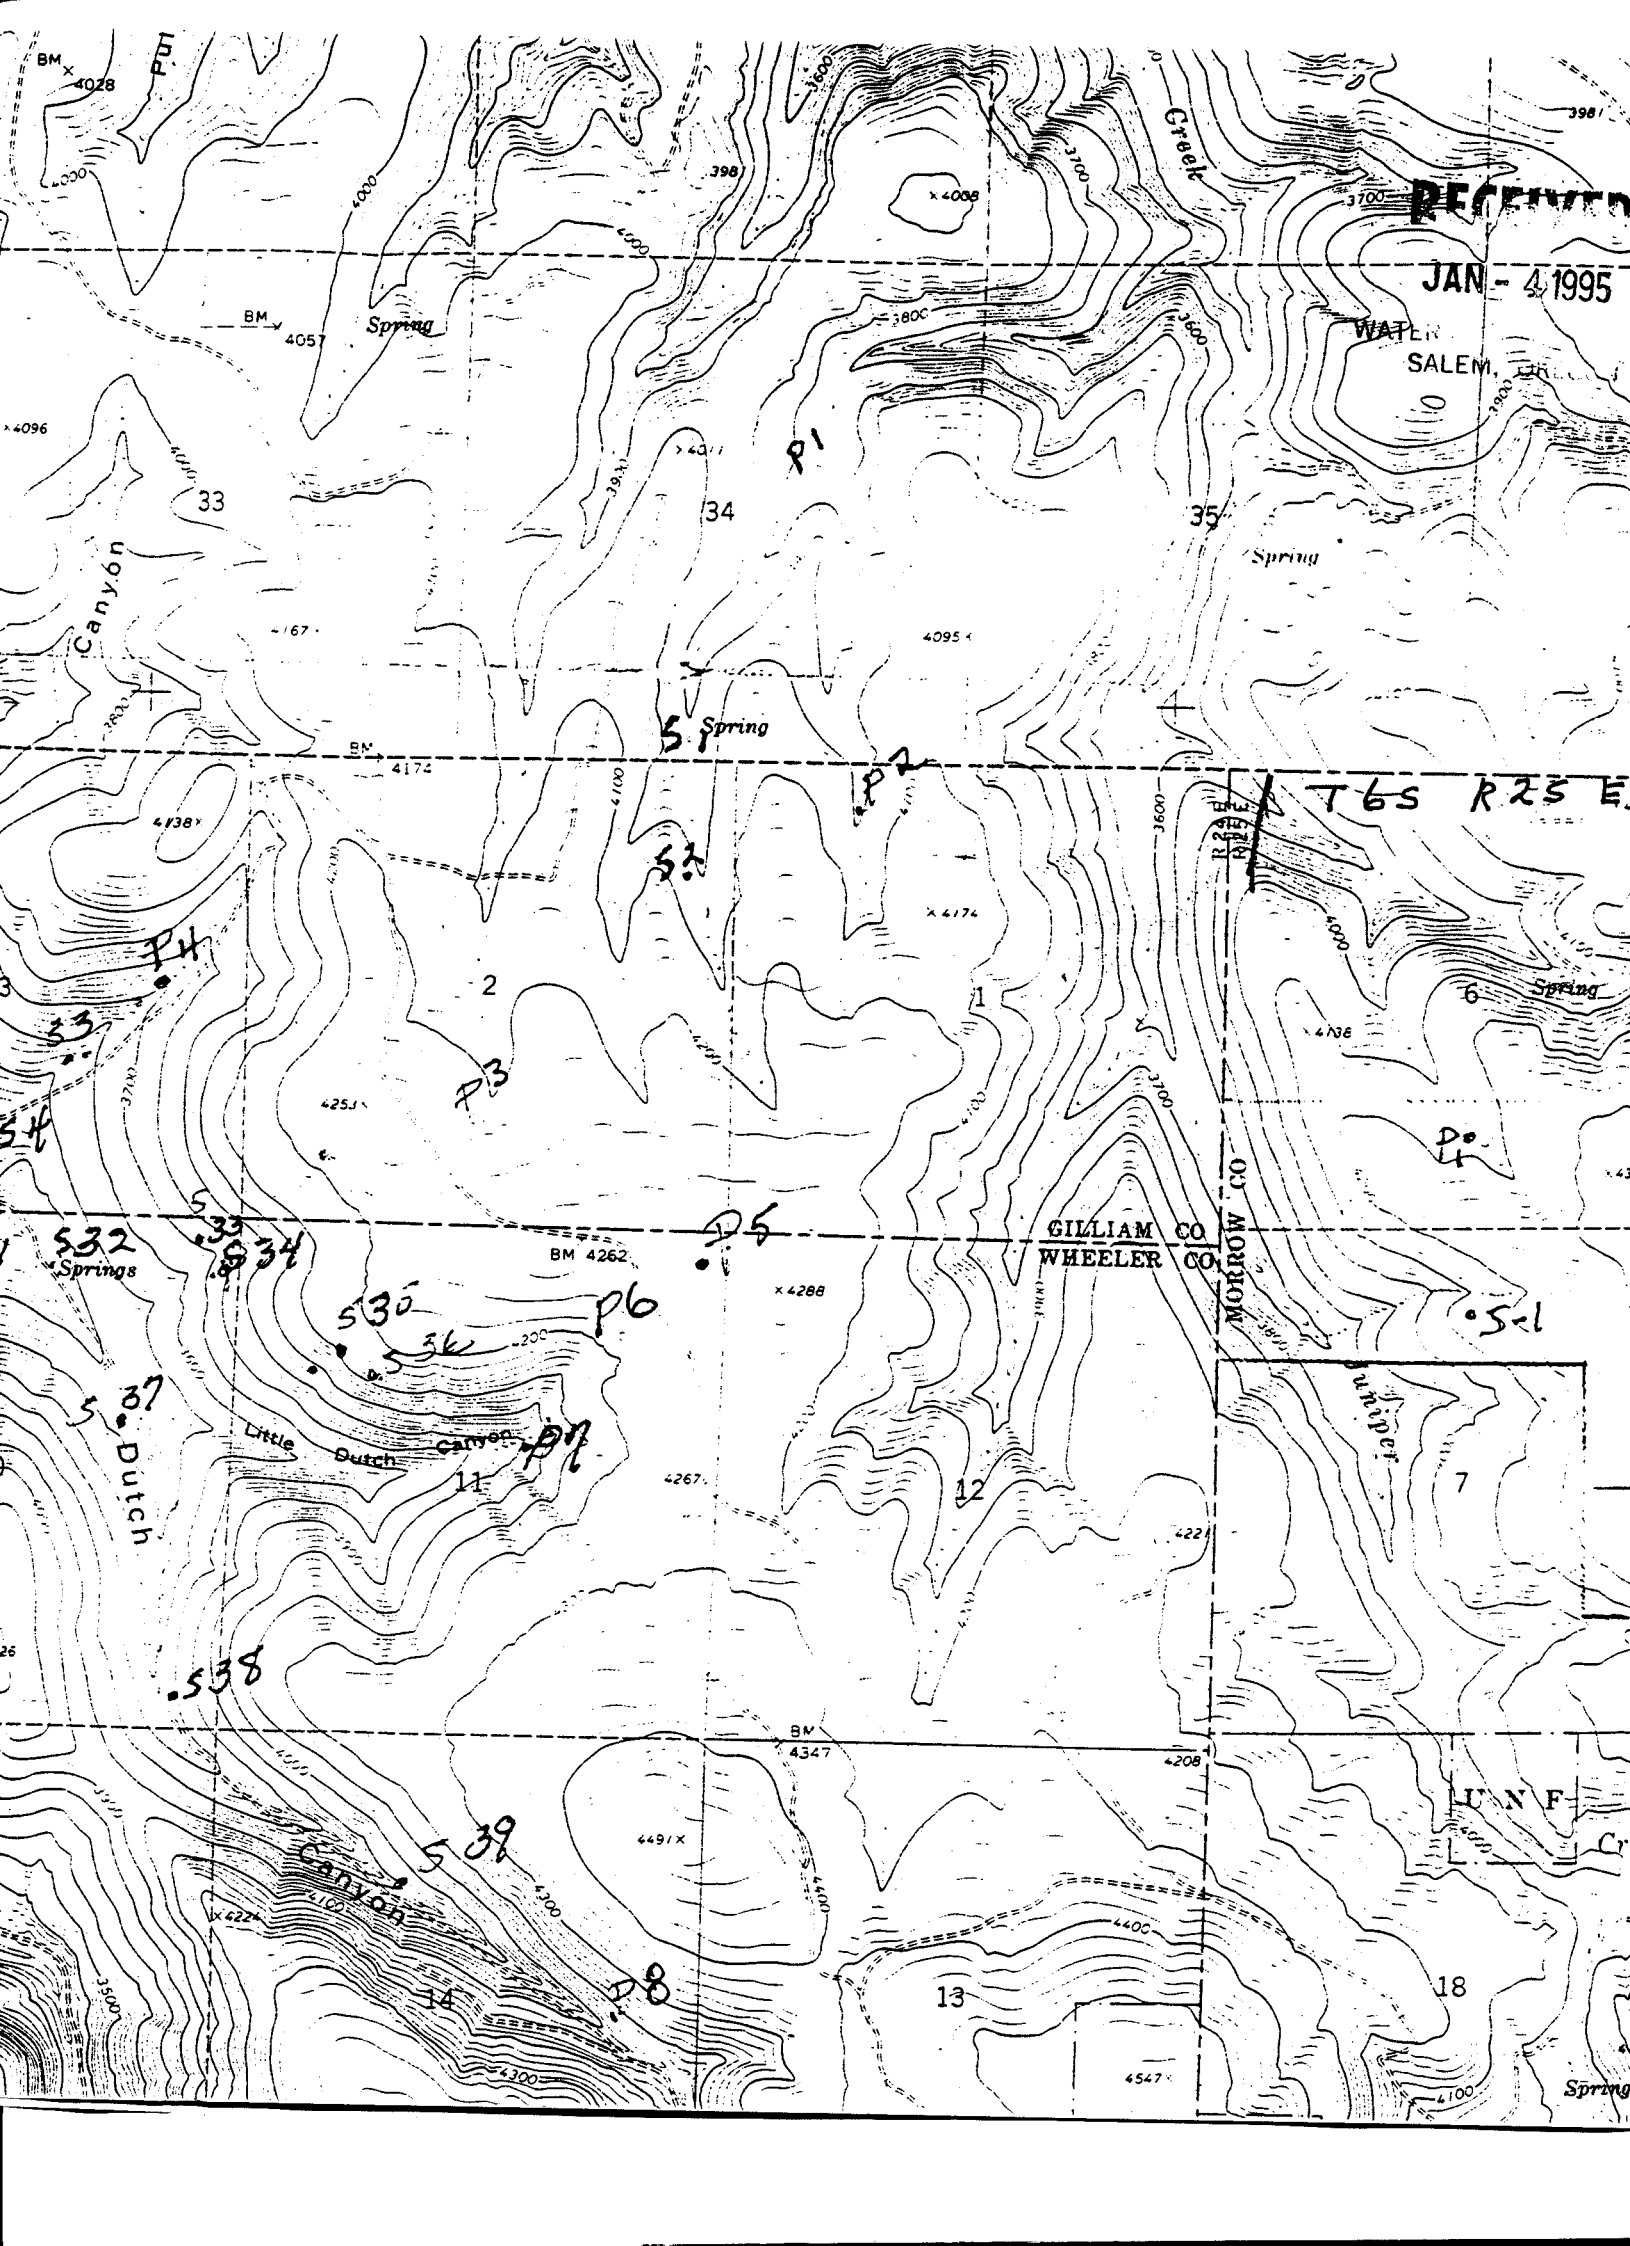

RECEIVED

JAN - 4 1995

WATER
SALEM, OR

T6S R23E

GILLIAM CO
WHEELER CO

MORROW CO

UNF