

Application No R-80080  
Permit No.

SECTION 17 T.30S. R.4W. W.M.  
DOUGLAS COUNTY

30 4 17


THIS MAP WAS PREPARED FOR  
ASSESSMENT PURPOSE ONLY.

71762

1"=400'

CERTIFICATE NO.

SEE MAP 30 4 8

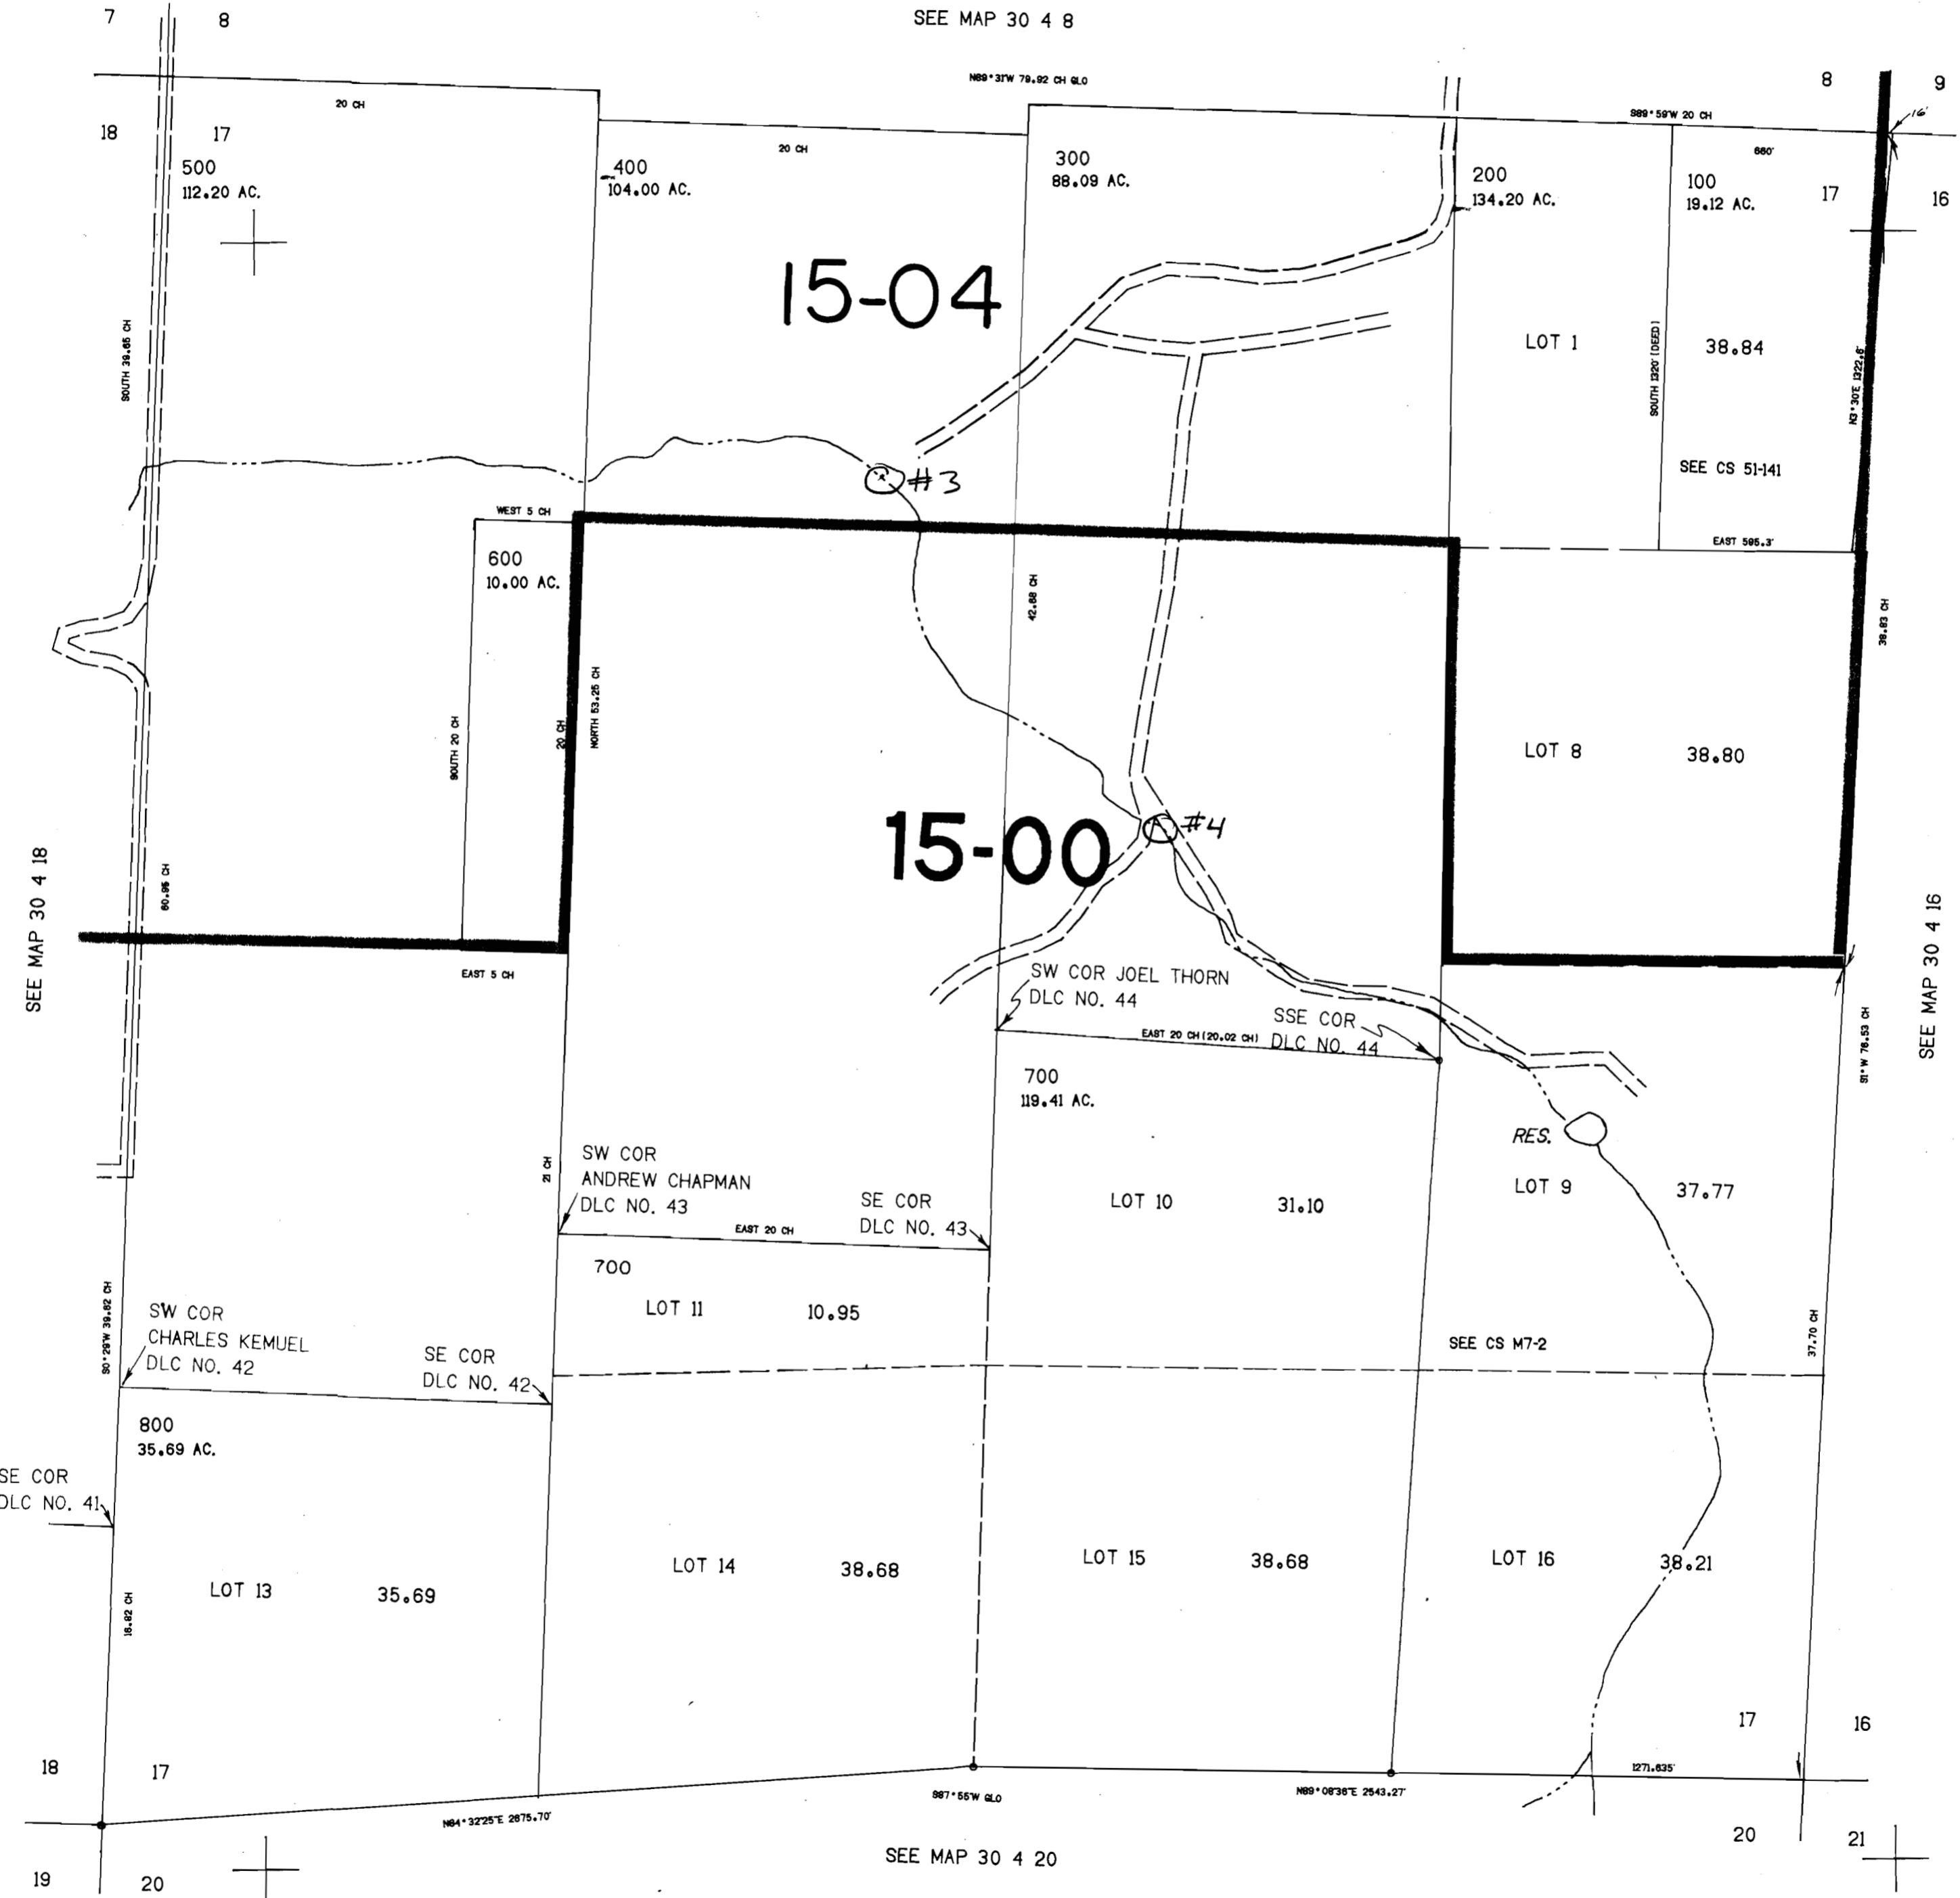

481.000

30 4 17

000181