



Jefferson

SCALE 1:46000

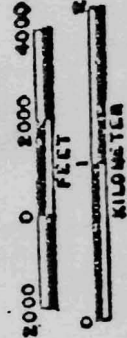

This map was prepared for assessment purposes only

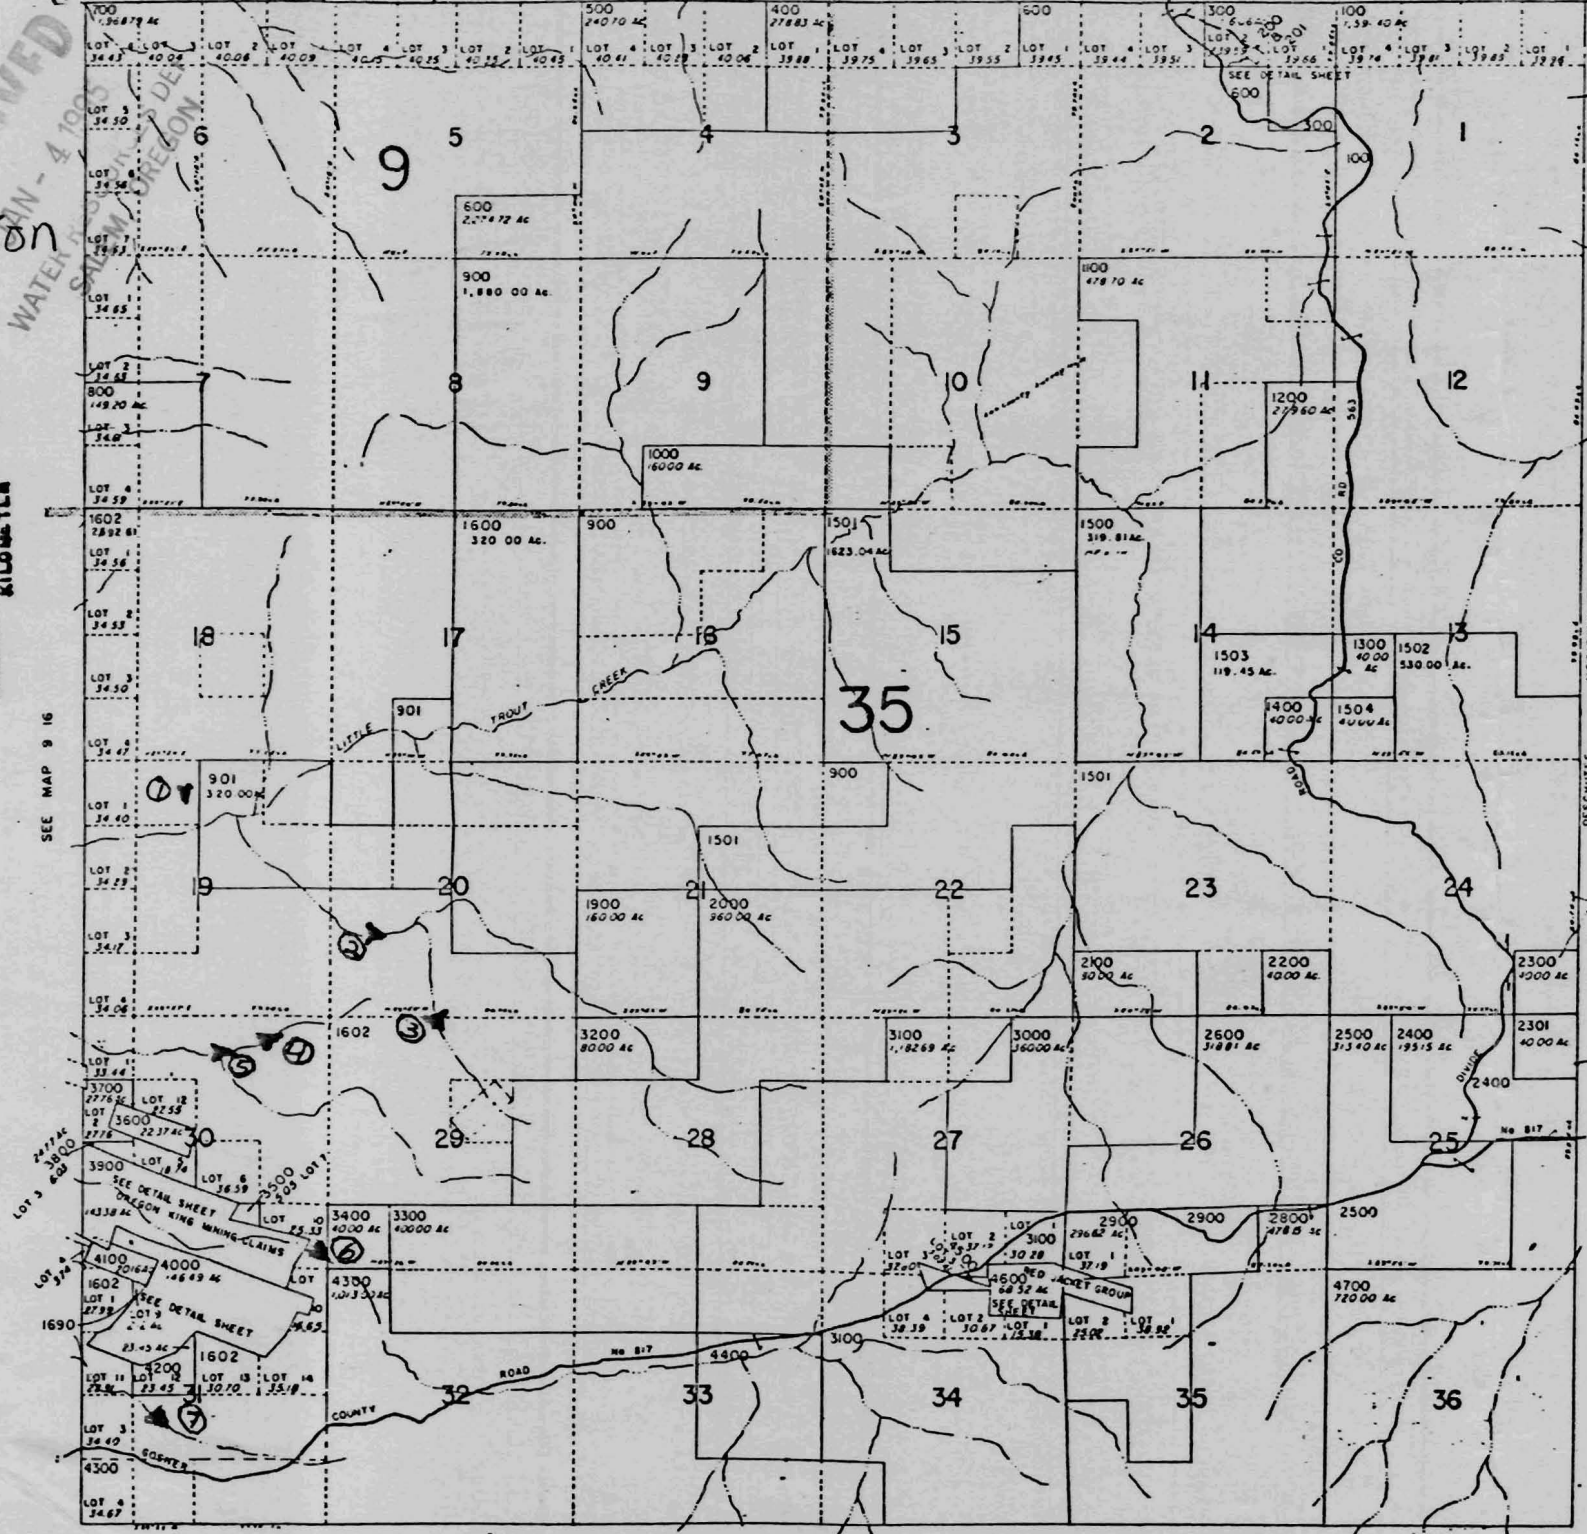

T9SR17E  
1"=2000'


DARRELL FRIED  
Box 41  
ASHWOOD, OR  
97711

ALL IN TAX  
LOT #1602  
Sec 19 1  
Sec 20 2,3  
Sec 30 45,6  
Sec 31 7

T9SR16E  
Sec 36  
TAX LOT  
3001  
Pond 8,9

Application No. R-80083  
Permit No.

CERTIFICATE NO. 71765

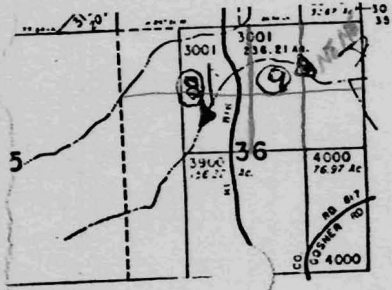

SEE MAP 10 17