Application No. R-80090
Permit No.

71772

RECEIVED
JAN 26 1996
WATER RESOURCES DEPT.
SALEM, OREGON

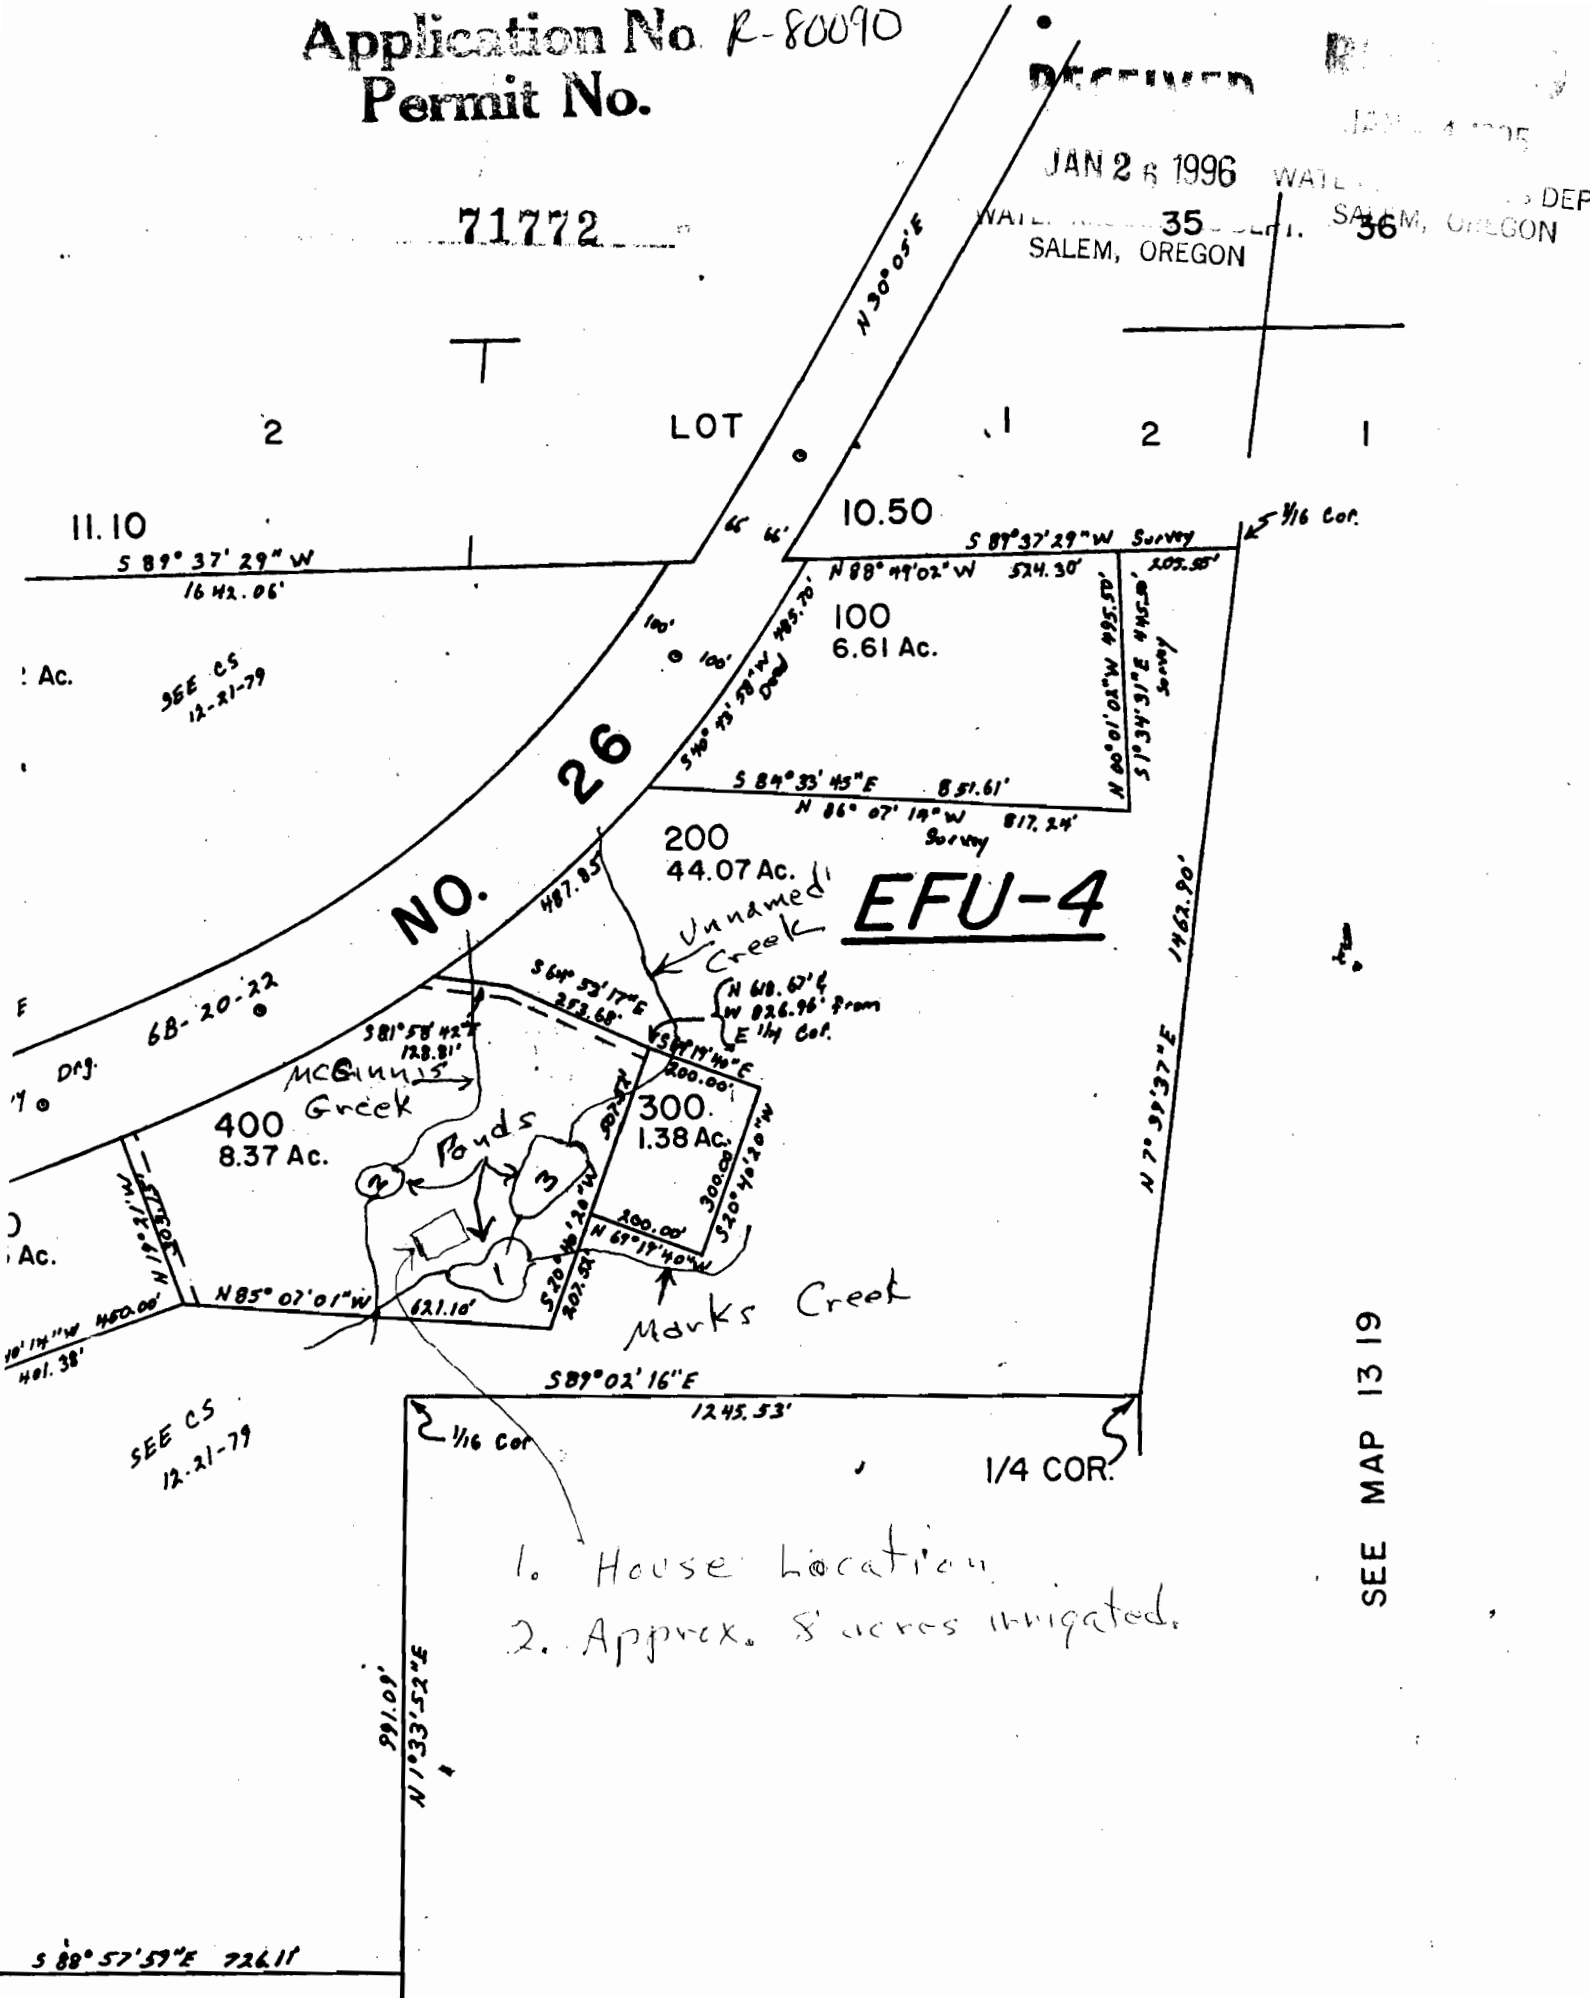

1. House Location
2. Approx. 8 acres irrigated.