

THIS MAP WAS PREPARED FOR ASSESSMENT PURPOSE ONLY.

NW1/4SW1/4 SEC 15 T3S R40E WM

3S 40 15CB

UNIC COUNTY

CC

1" = 200'

SEE MAP 38 40 15CB

1200' 1200' 1200'

SCALE 1:2400




RECEIVED  
N - 4 1995  
WATER RESOURCES DEP  
SALEM, OREGON

Application No. R 800A  
Permit No. 71773

CERTIFICATE NO. 71773

SEE MAP 38 40 18DA

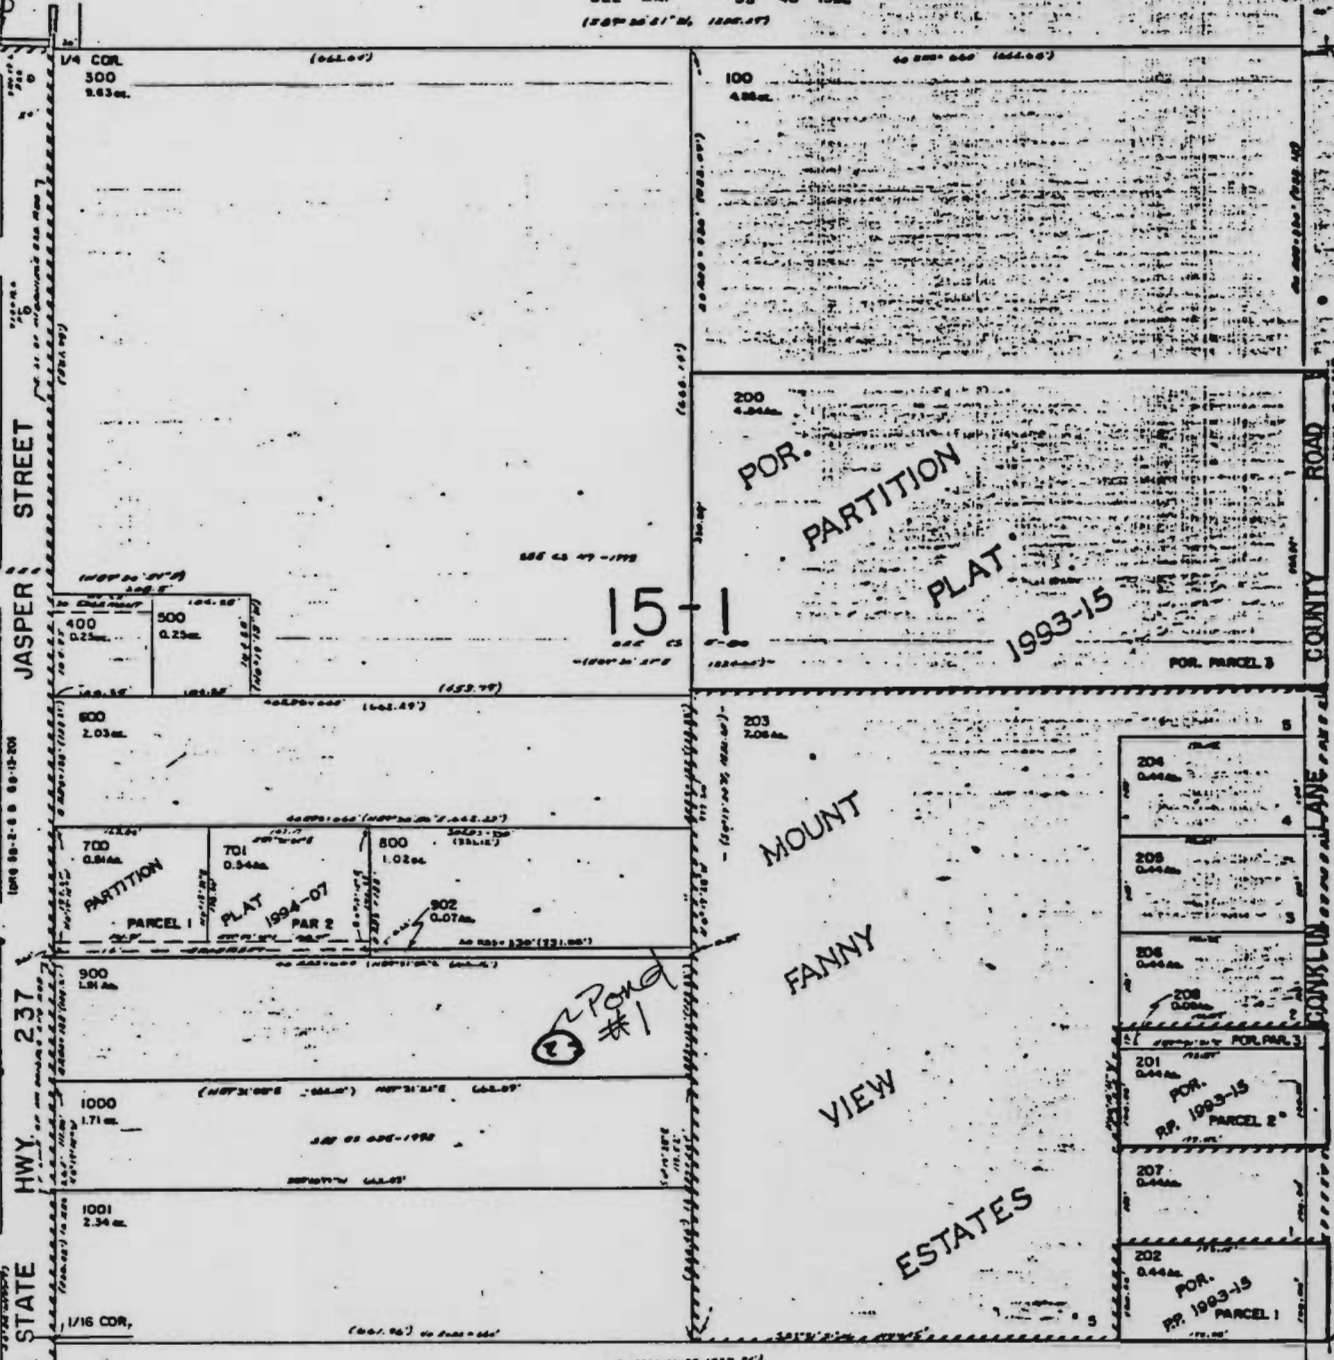

Ⓢ Pond #1

237

HWY

STATE

1/16 COR.

SEE MAP 38 40 15CB

COUNTY ROAD COUNTY ROAD

3S 40 15CB