


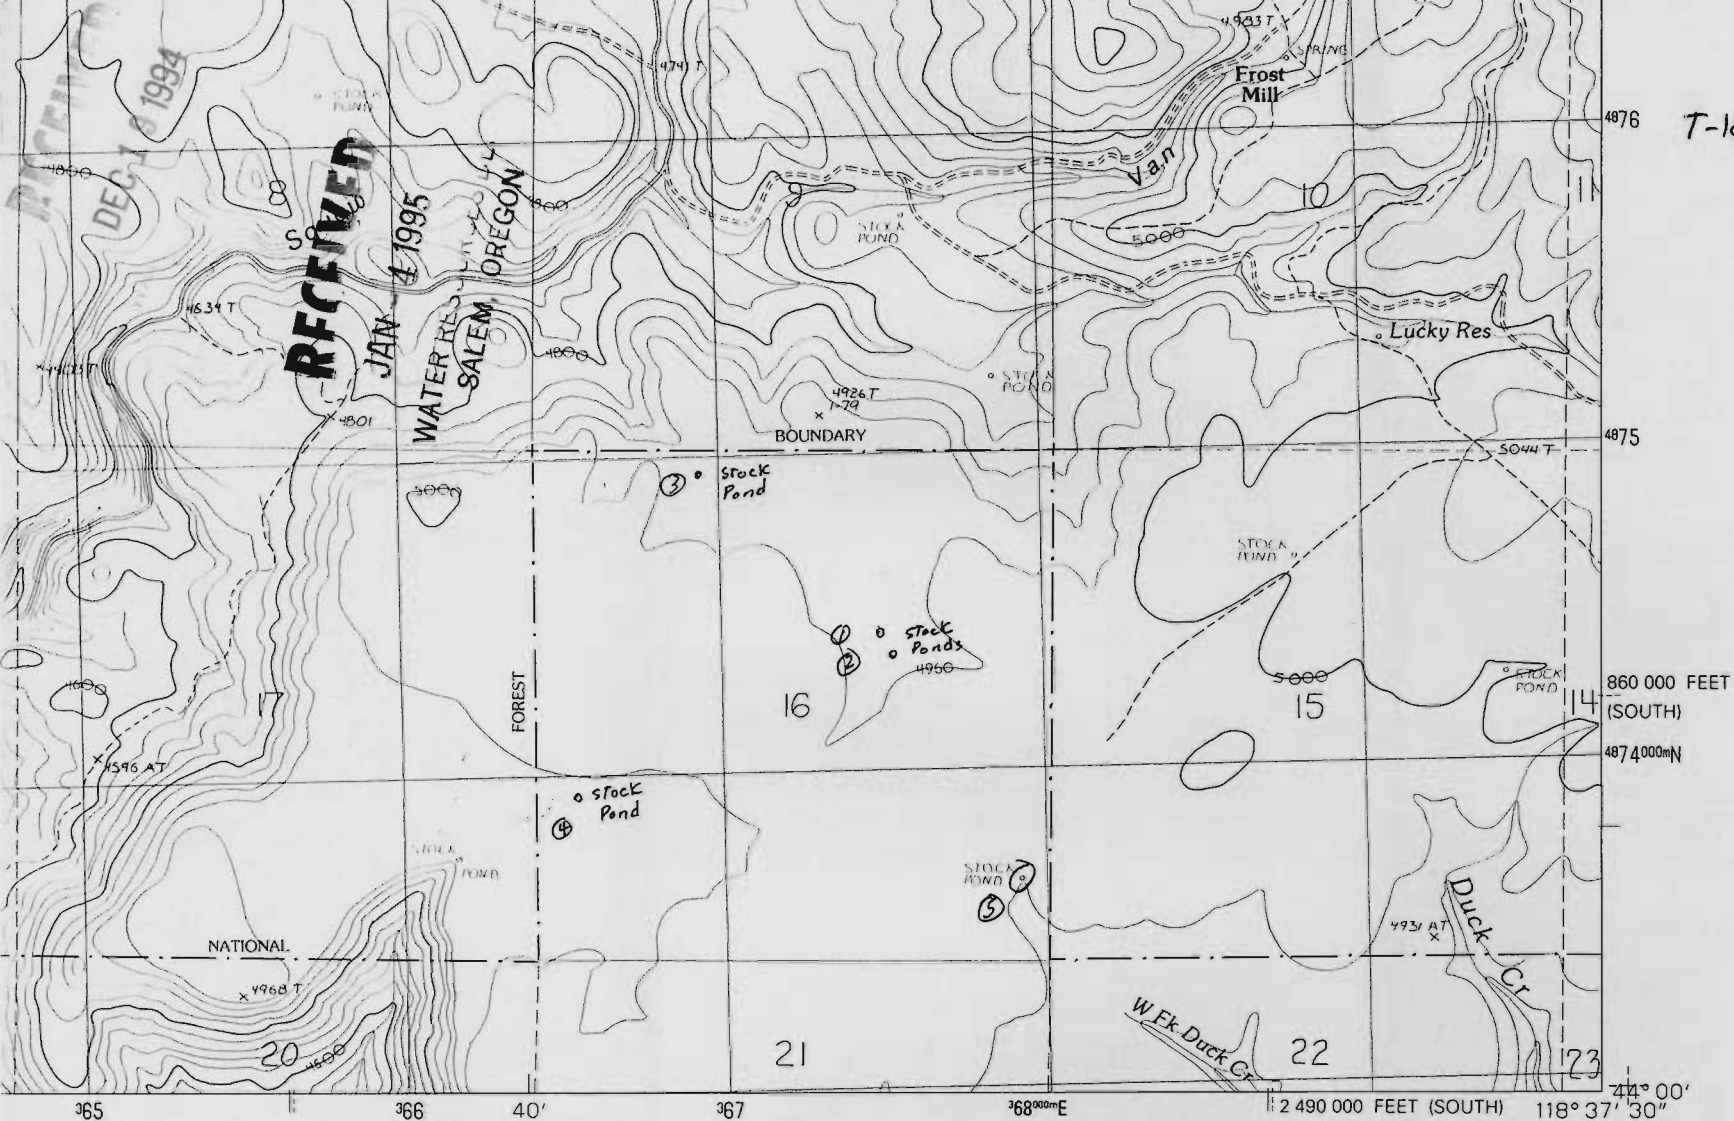


T-18-S R-33 1/2 -E

71777

Application No. P-80095
Permit No.

1:24 000

INTERIOR—GEOLOGICAL SURVEY, RESTON, VIRGINIA—1988

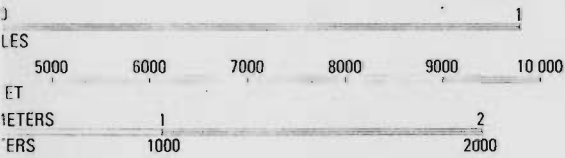

ROAD LEGEND

Improved Road
Unimproved Road
Trail

○ Interstate Route ○ U. S. Route ○ State Route

1	2	3	1 Canyon Meadows Lake
			2 Logan Valley West
			3 Logan Valley East
4		5	4 Jump-off Joe Mtn.
			5 Dollar Basin
			6 Calamity Butte
6	7	8	7 Van
			8 Moffit Table

MAGPIE TABLE, OREGON
PROVISIONAL EDITION 1988

A-16

NATIONAL MAP ACCURACY STANDARDS
GEOLOGICAL SURVEY
FOR RESTON, VIRGINIA 22092

ADJOINING 7.5 QUADRANGLE NAMES

44118-A6-TF-024

VAN QUADRANGLE
OREGON-HARNEY CO.
7.5 MINUTE SERIES (TOPOGRAPHIC)



Application No. R-80095
Permit No.

DISPATCH NO. 71777 77