




LED NOS  
200  
201  
thru  
206

**CROOK**  
1317

71778-76018 SCALE 1:48000

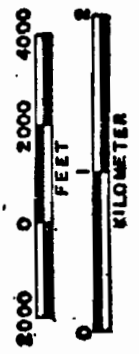

Application No. R-80046  
Permit No. 6

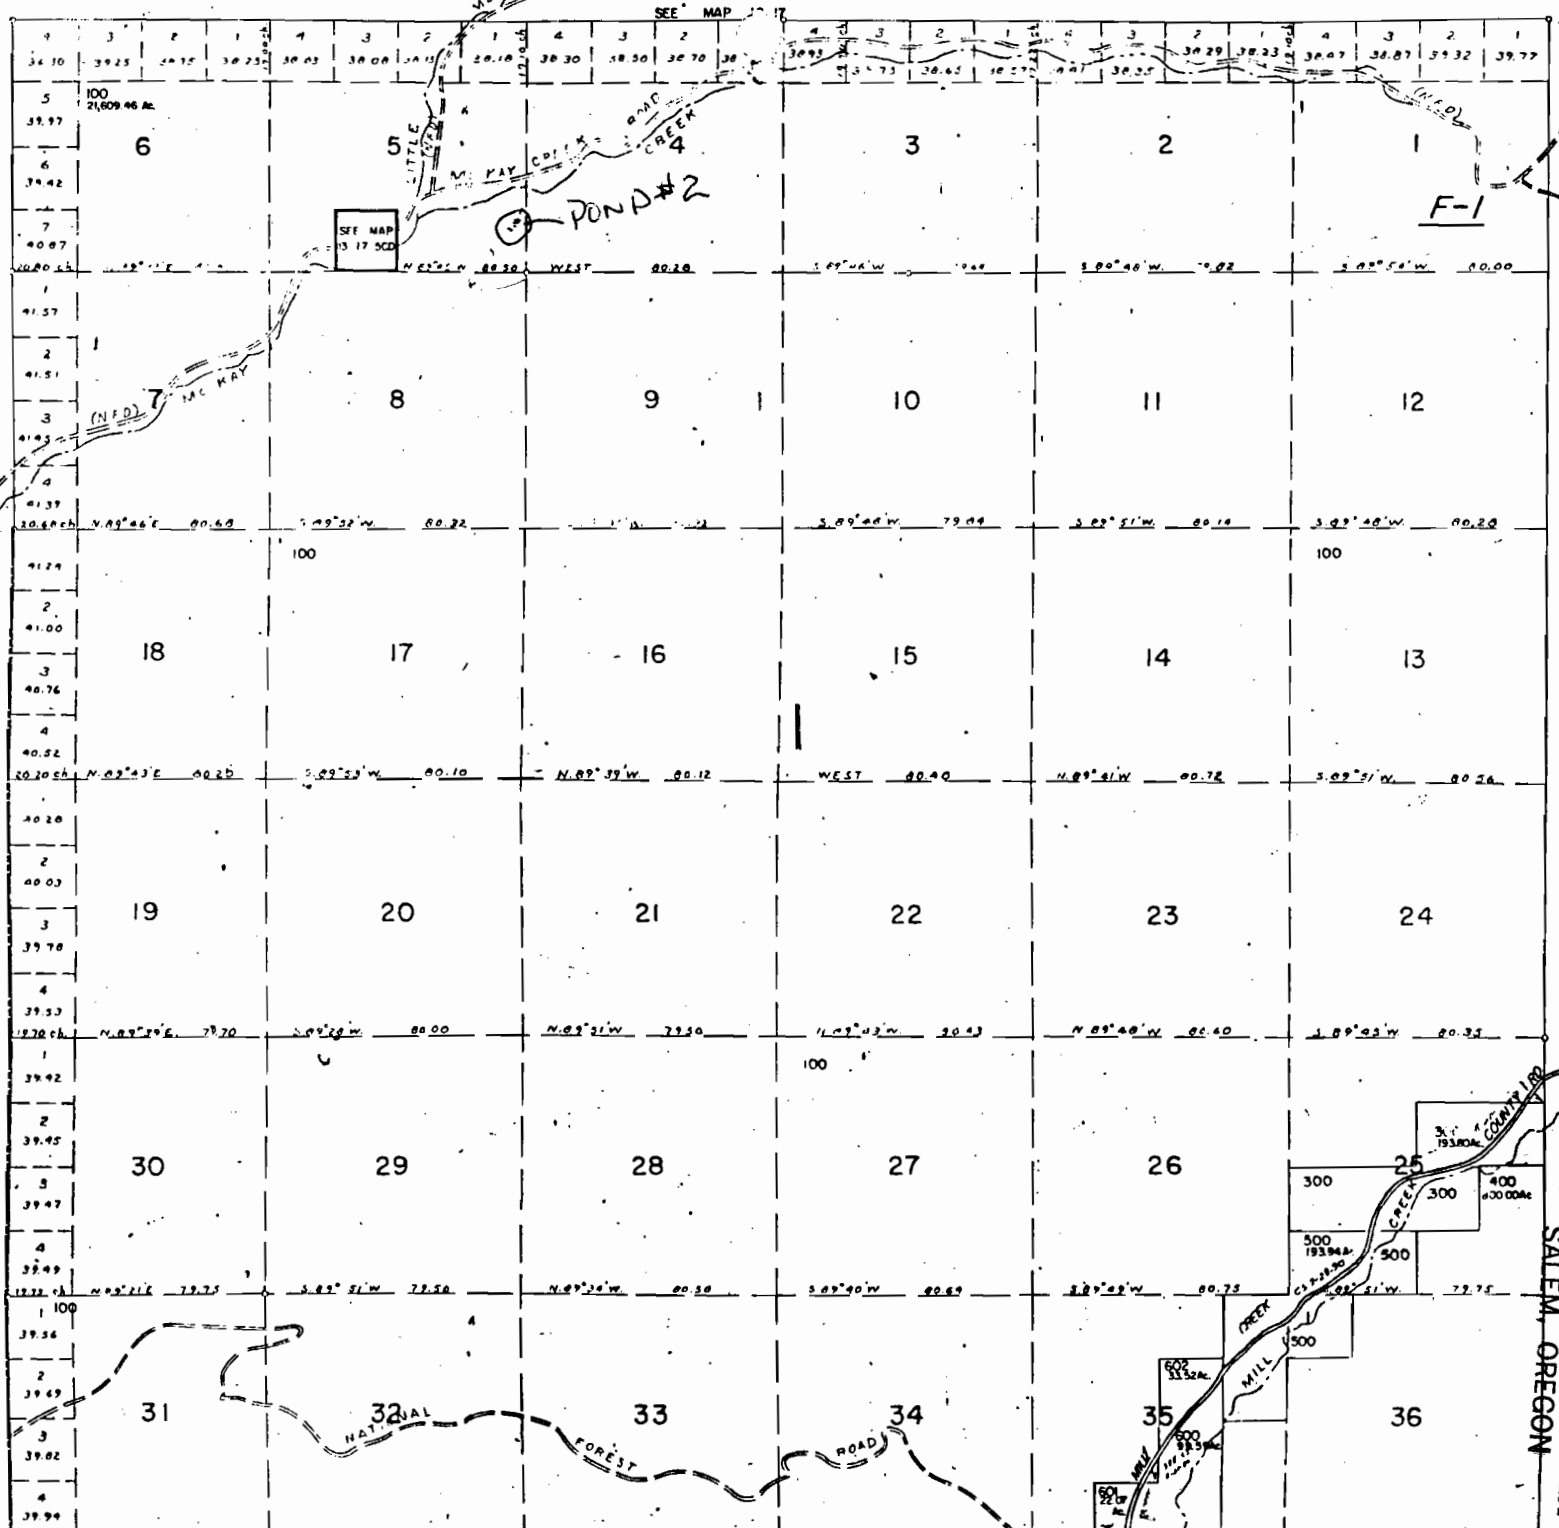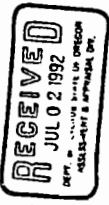

SEE MAP 13 18

WATER RESOURCES DEPT.  
SALEM, OREGON

JAN - 4 1995

**RECEIVED**



THIS MAP WAS PREPARED FOR  
ASSESSMENT PURPOSE ONLY

SE1/4 SW1/4 SEC. 5 T.13S. R.17E. W.M.  
CROOK COUNTY  
1" = 100'

13 11 300

CANCELLED NO.'S  
401

SCALE 1:2400

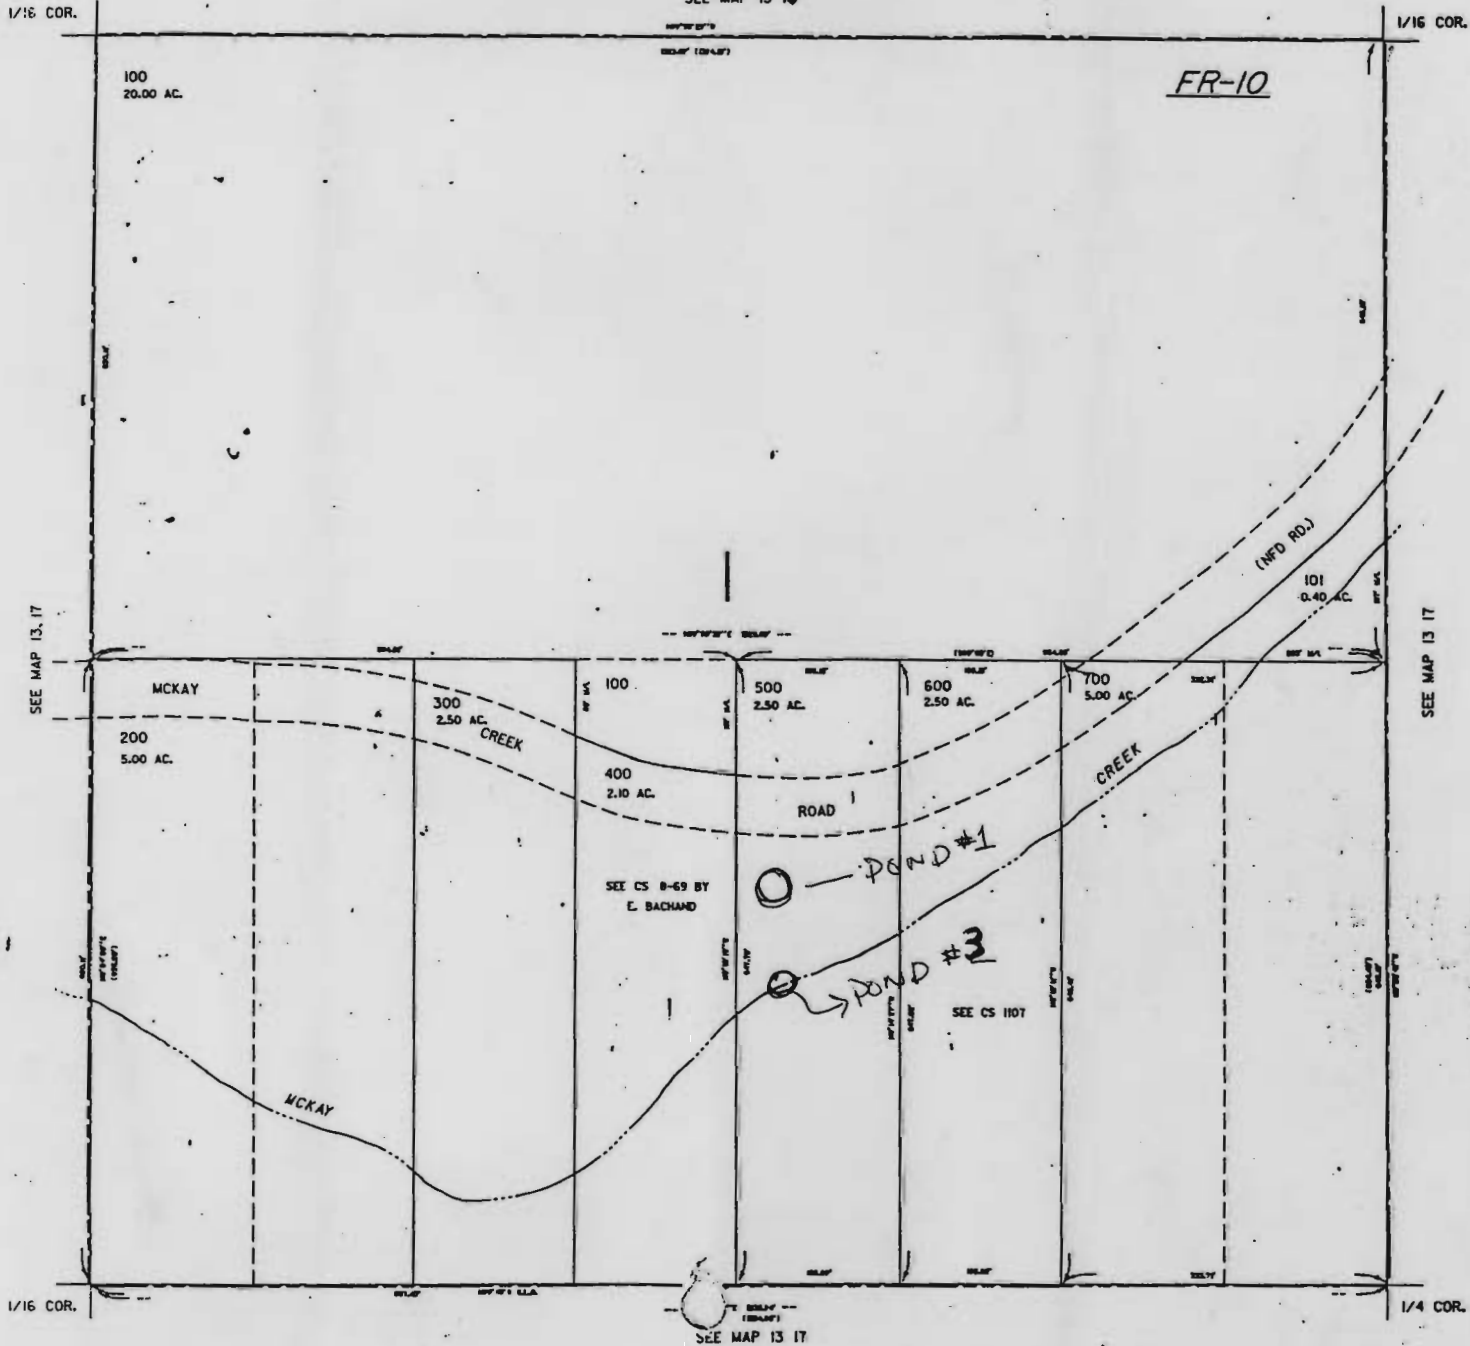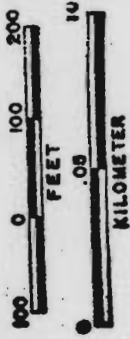

76018  
71778  
Application No. R-80096  
Permit No.

WATER RESOURCES DEPT.  
SALEM, OREGON

JAN - 4 1995

RECEIVED