


T.15S., R.1W., W.M.

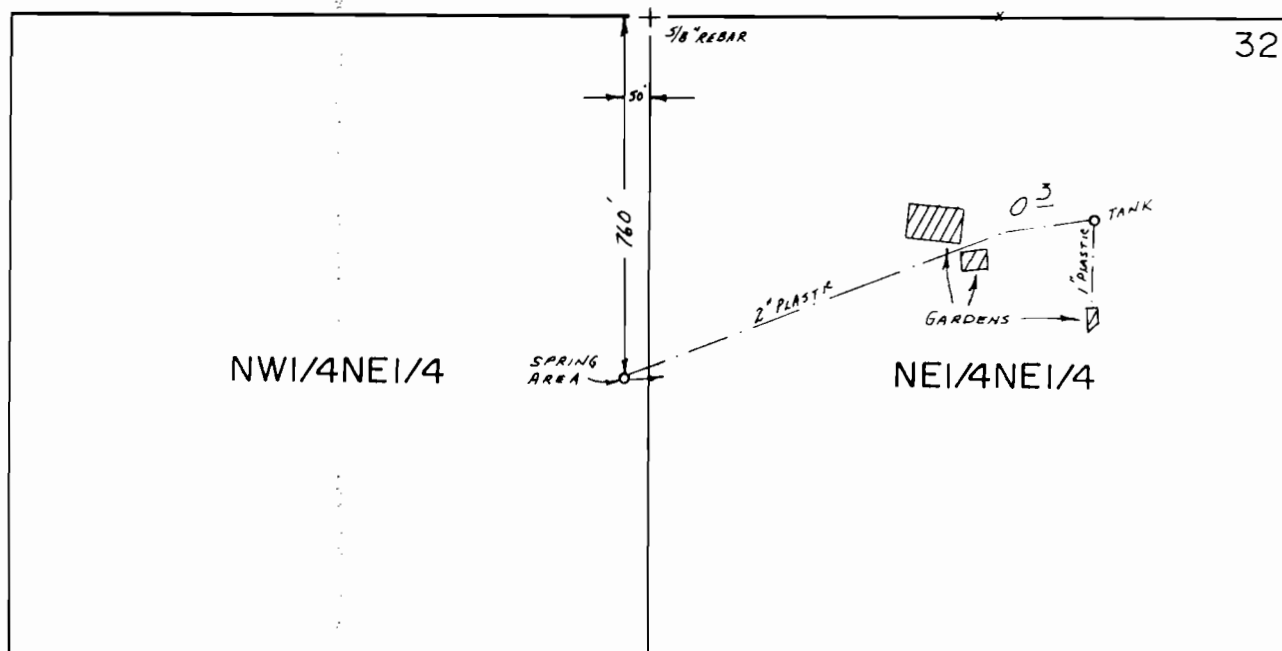

Application No. 2-80104
Permit No.

SCALE: 1" = 400'

71782

FINAL PROOF SURVEY
UNDER

Application No. 5947.7... Permit No. 44868.....
IN NAME OF

G. J. & ETHEL F. WOODS

Surveyed Oct. 6..... 19.86, by B.W. BISHOP.....