


*Pond  
Location  
Viewing  
Point  
1961  
Photorevised  
1976*

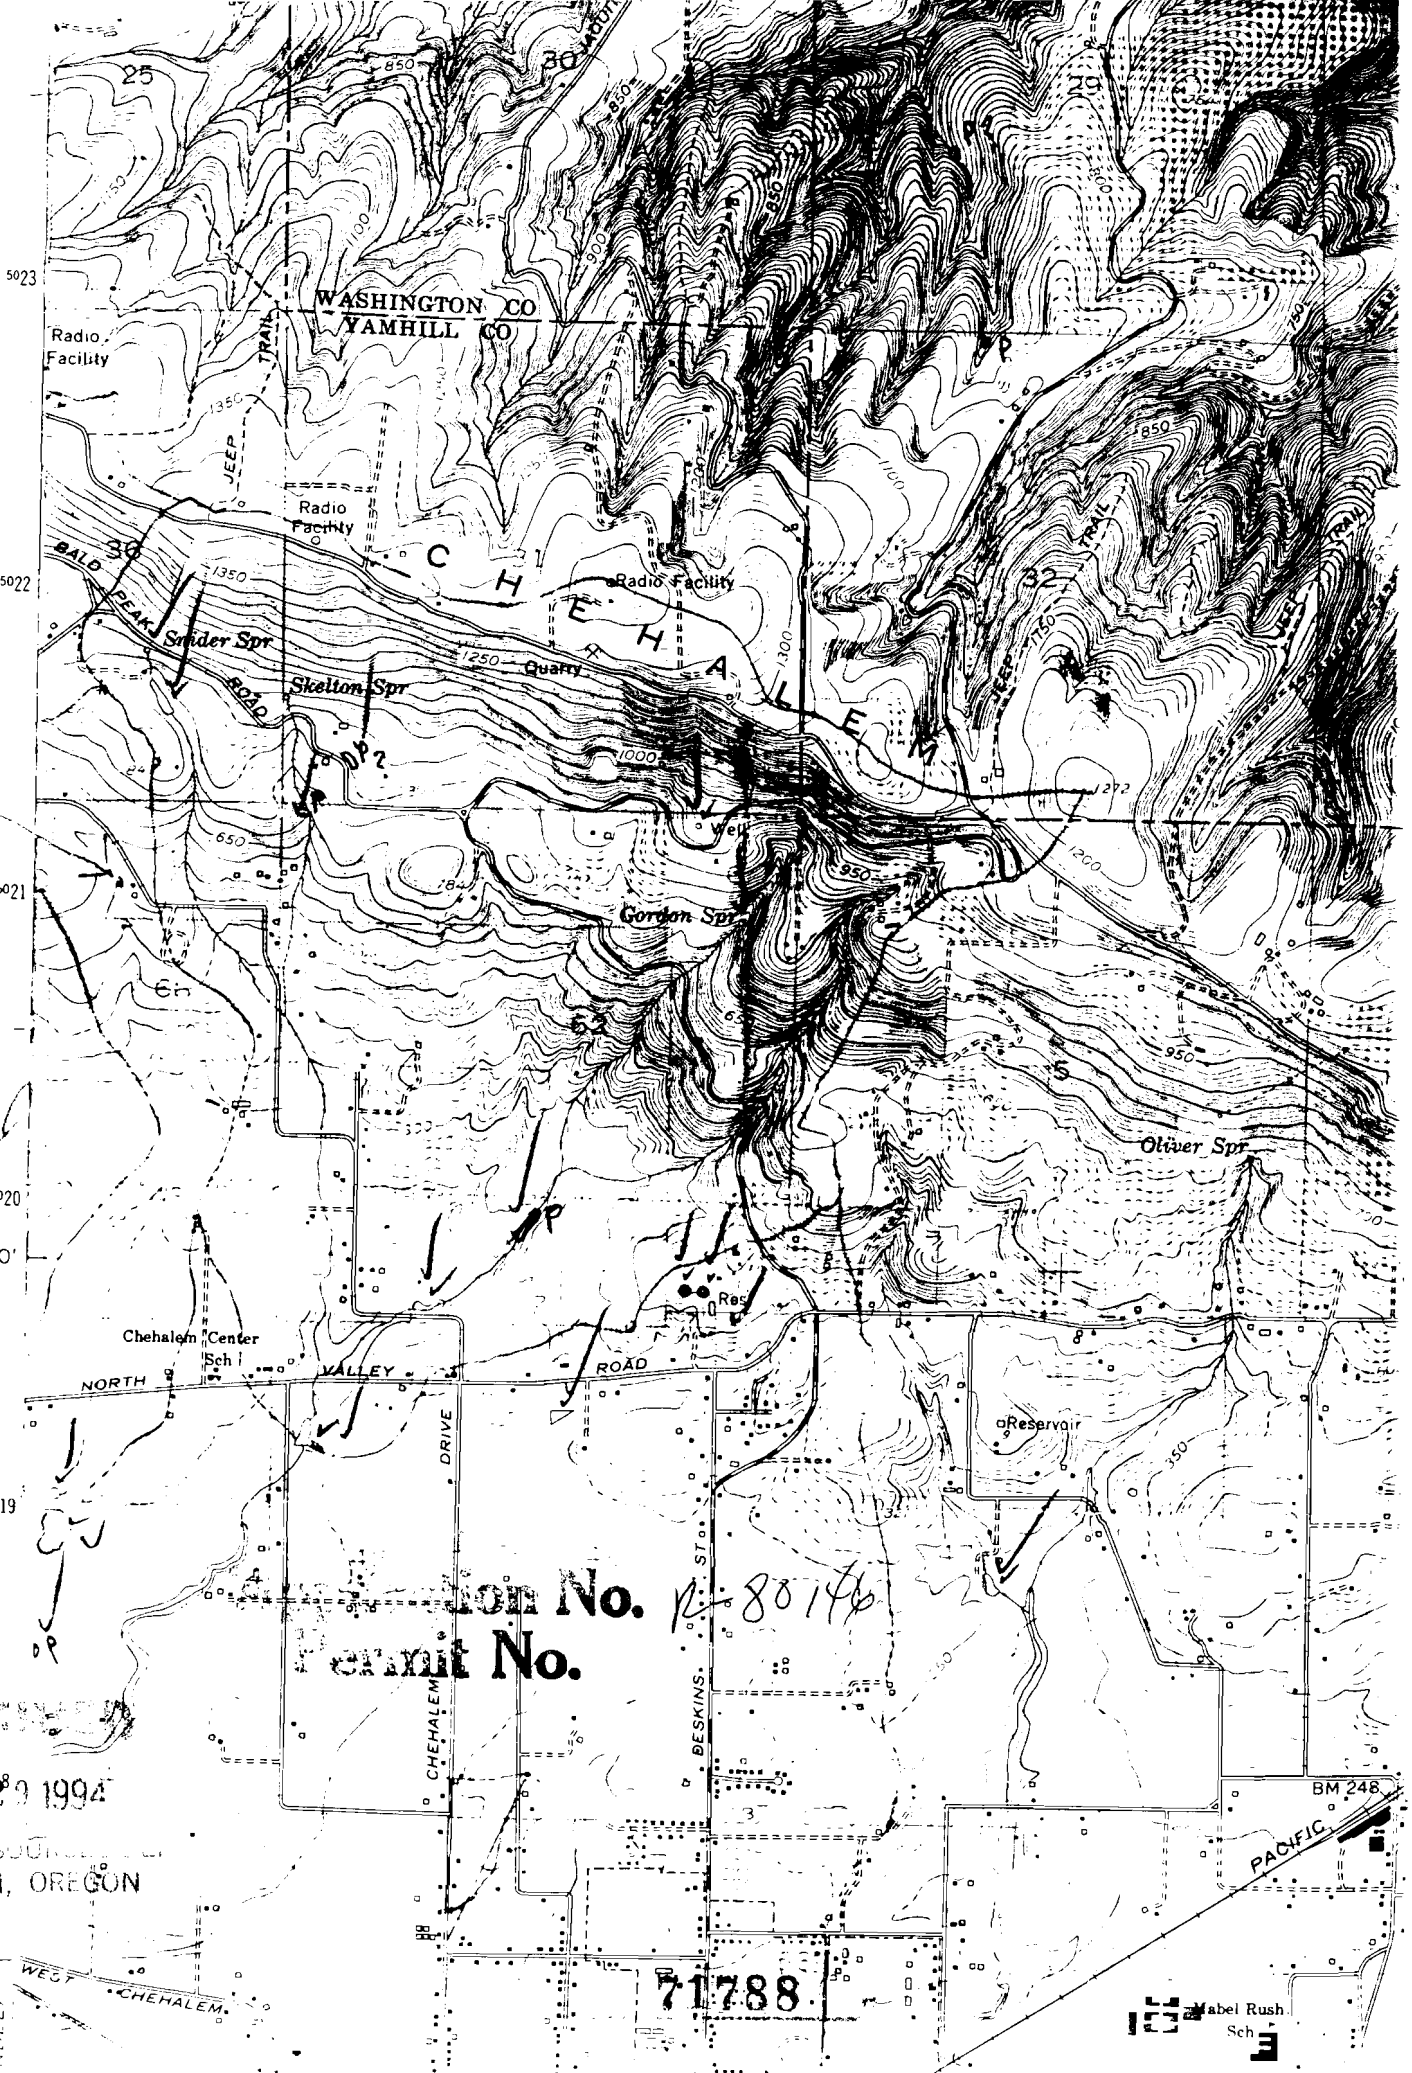

**Permit No.** *80146*

**RECEIVED**

DEC 29 1994

WATER RESOURCES DIVISION  
SALEM, OREGON

71788

Label Rush  
Sch