

Cottonwood Reservoir Quad

1990 Edition

T-19-S, R-35-E

NE SW
Sec 24

Application No. L-80184
Permit No.

MAP
2

UNCLASSIFIED

WATER RESOURCES DEPT.
SALEM, OREGON


DEC 23 1994

RECEIVED

71813

43° 52' 30"
118° 22' 30"

PRODUCED BY THE UNITED STATES GEOLOGICAL SURVEY
CONTROL BY USGS, NOS/NOAA
COMPILED FROM AERIAL PHOTOGRAPHS TAKEN 1967
FIELD CHECKED 1968
LIMITED REVISION FROM AERIAL PHOTOGRAPHS TAKEN 1985
FIELD CHECKED 1987 MAP EDITED 1990
PROJECTION LAMBERT CONFORMAL CONIC

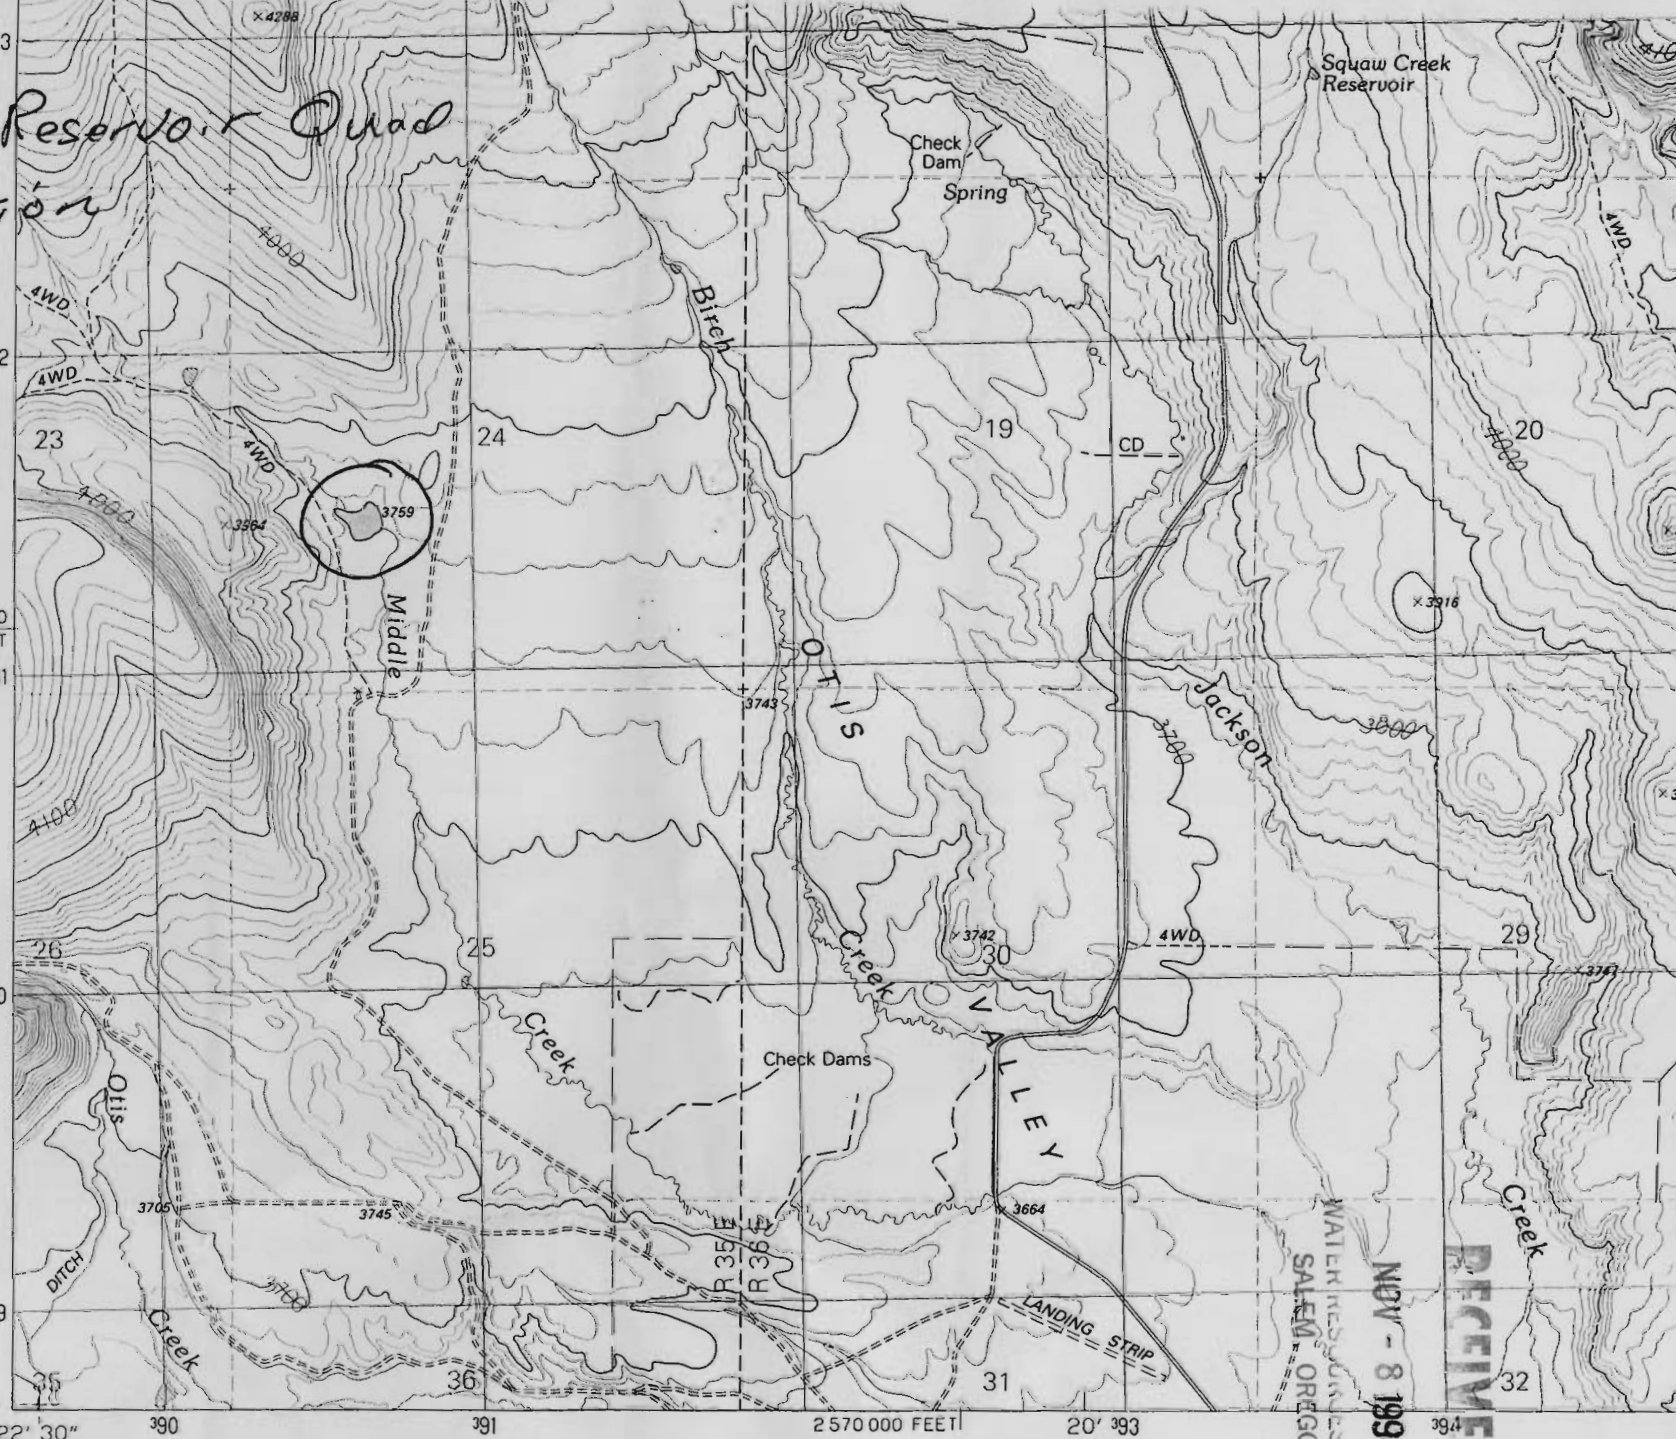

Squaw Creek Reservoir

Check Dam
Spring

CD

Birch

OTIS

Creek

Check Dams

VALLEY

LANDING STRIP

WATER RESOURCES DEPT.
SALEM, OREGON

NOV - 8 1994

RECEIVED

SCALE 1:24



GEOLOGICAL SURVEY

118° 22' 30" 3900000E 391 392 20' 393
43° 52' 30"

Drinking Water Pass Quad
1990 edition


T-20-S, R-36-E
NW SE
Sec 6

MAP
#1

71813

CERTIFICATE NO.

RECEIVED
NOV - 8 1994
WATER RESOURCES DEPT.
SALEM, OREGON

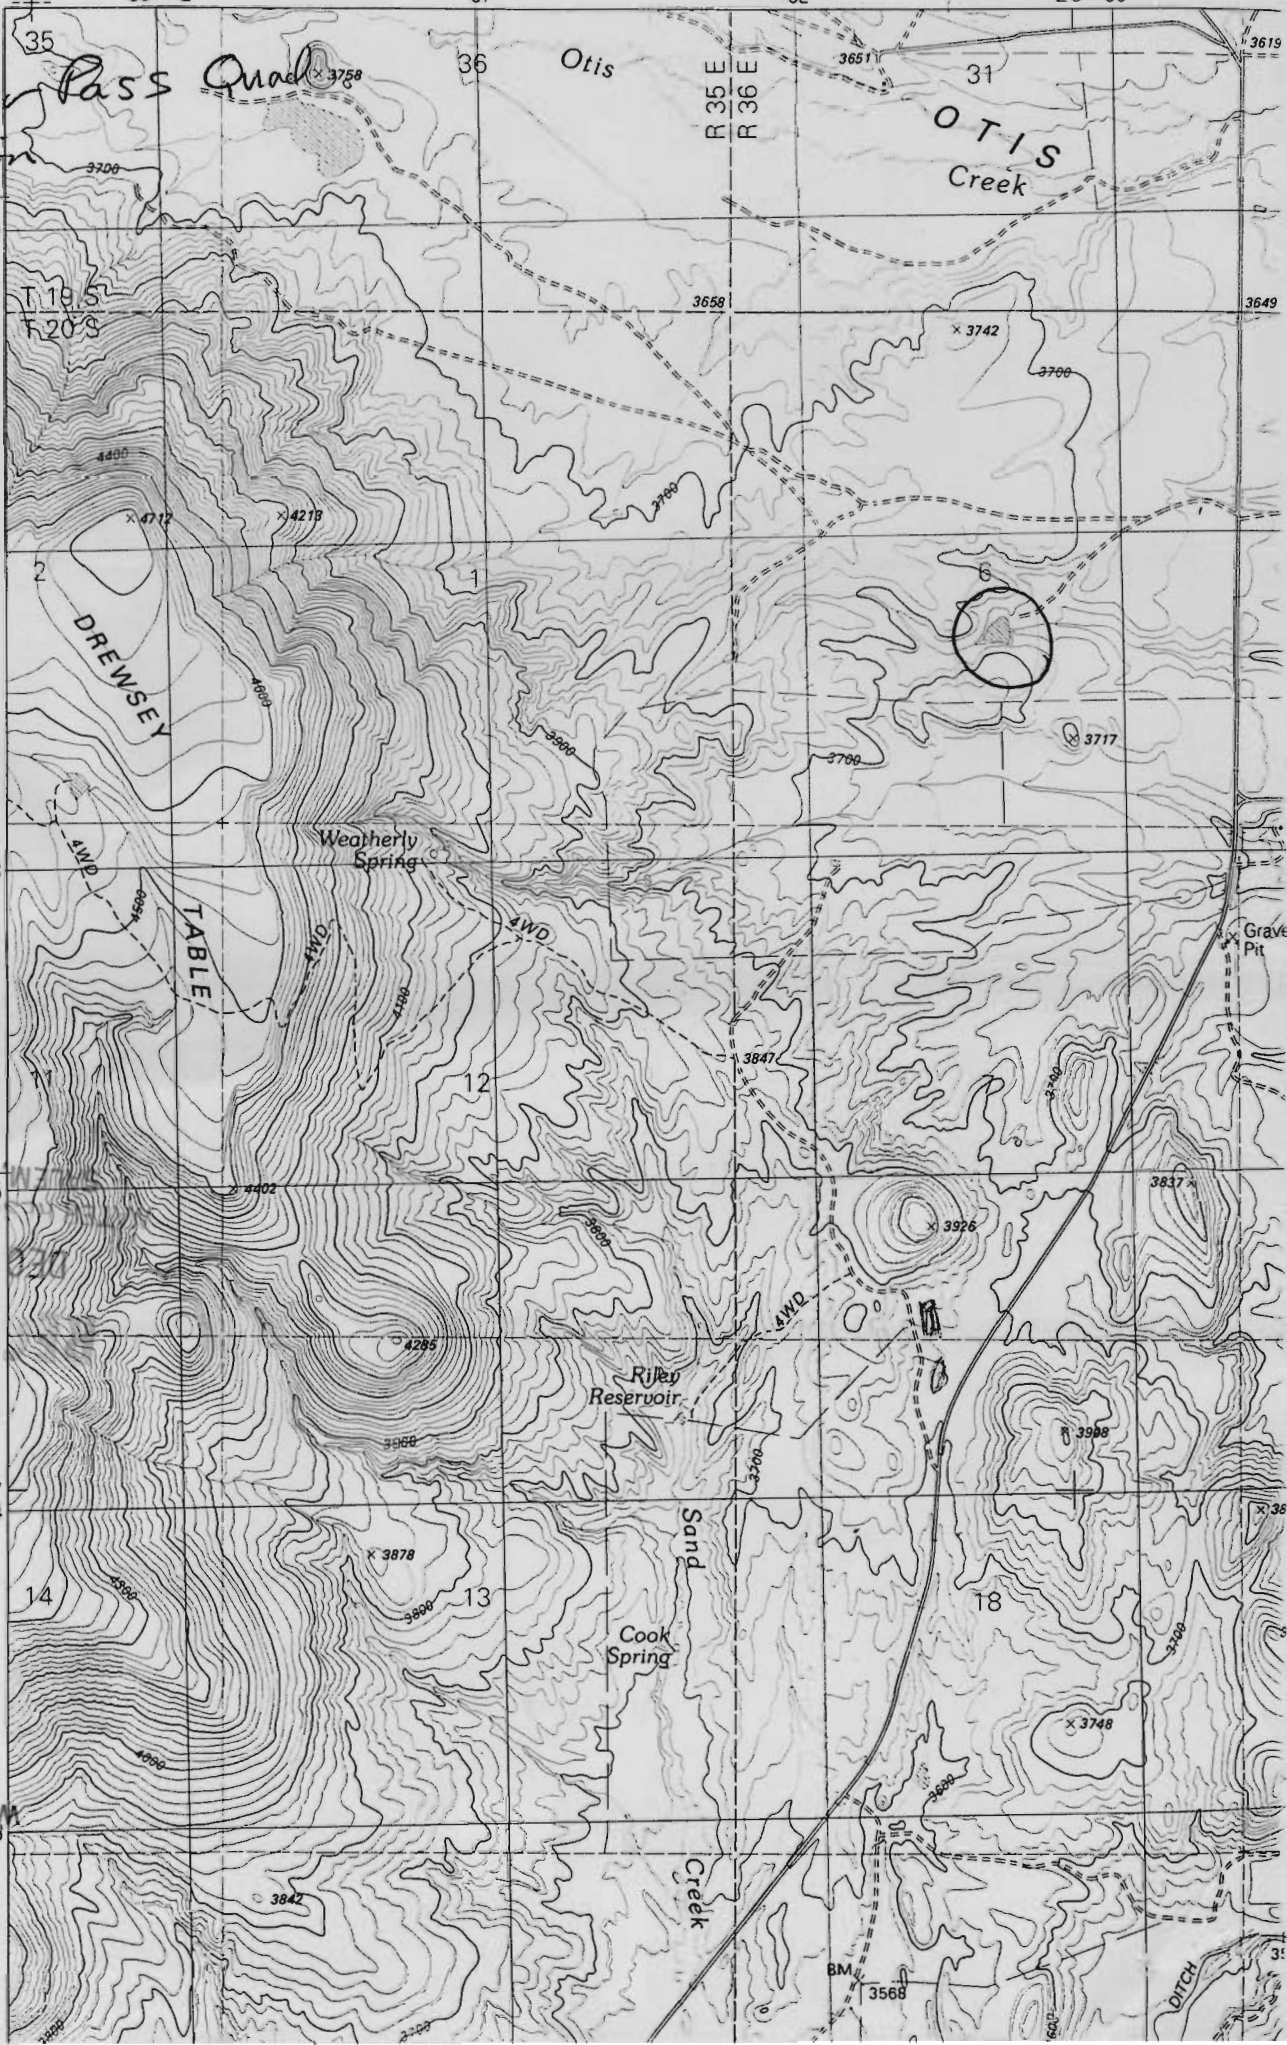

RECEIVED

NOV - 8 1994

WATER RESOURCES DEPT.

SALEM, OREGON