


NE 1/4, SECTION 2, T38S R3W W.M.

SCALE 1" = 200'

"CERTIFICATE NO. 71816"

38 3W 2A

SEE MAP 37 3W 35D

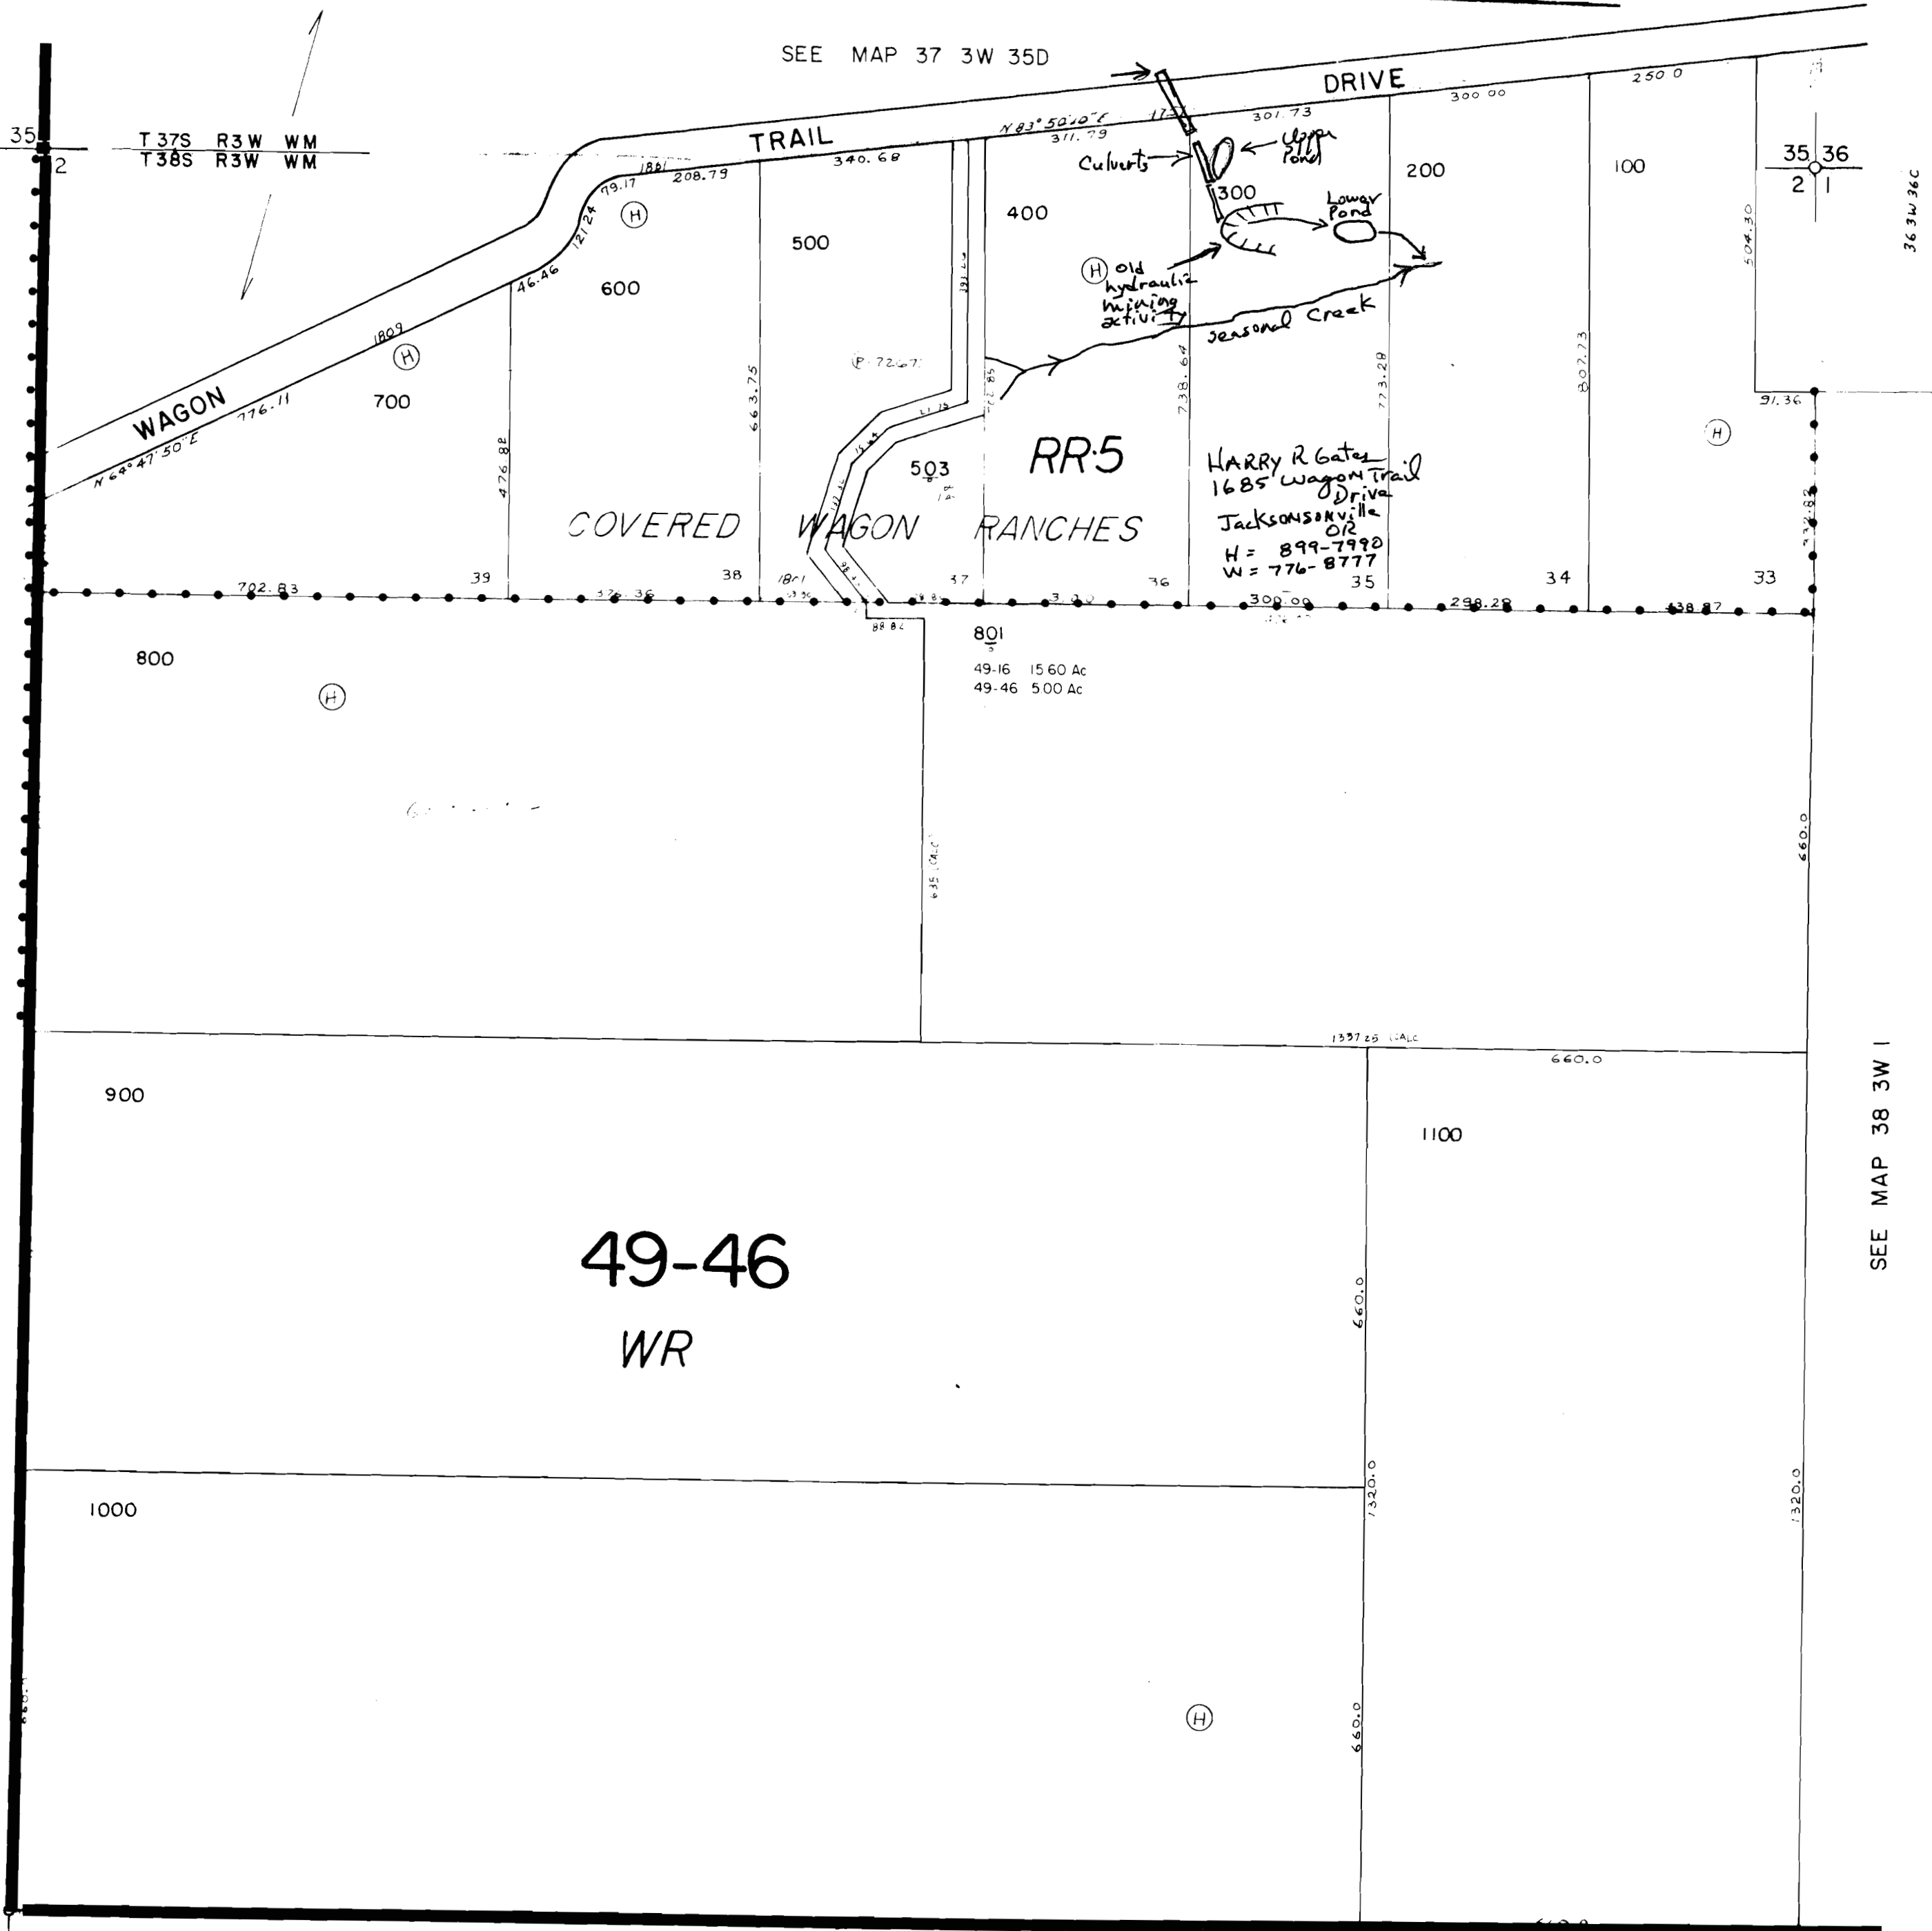

SEE MAP 38 3W 2

SEE MAP 38 3W 1

SEE MAP 38 3W 2

Application No. R-80188
Permit No.