


SECTION 15 T.25S. R.6W. W.M.
DOUGLAS COUNTY

REVISED ON
4-20-94

25 6 15

THIS MAP WAS PREPARED FOR
ASSESSMENT PURPOSE ONLY.

1"=400'

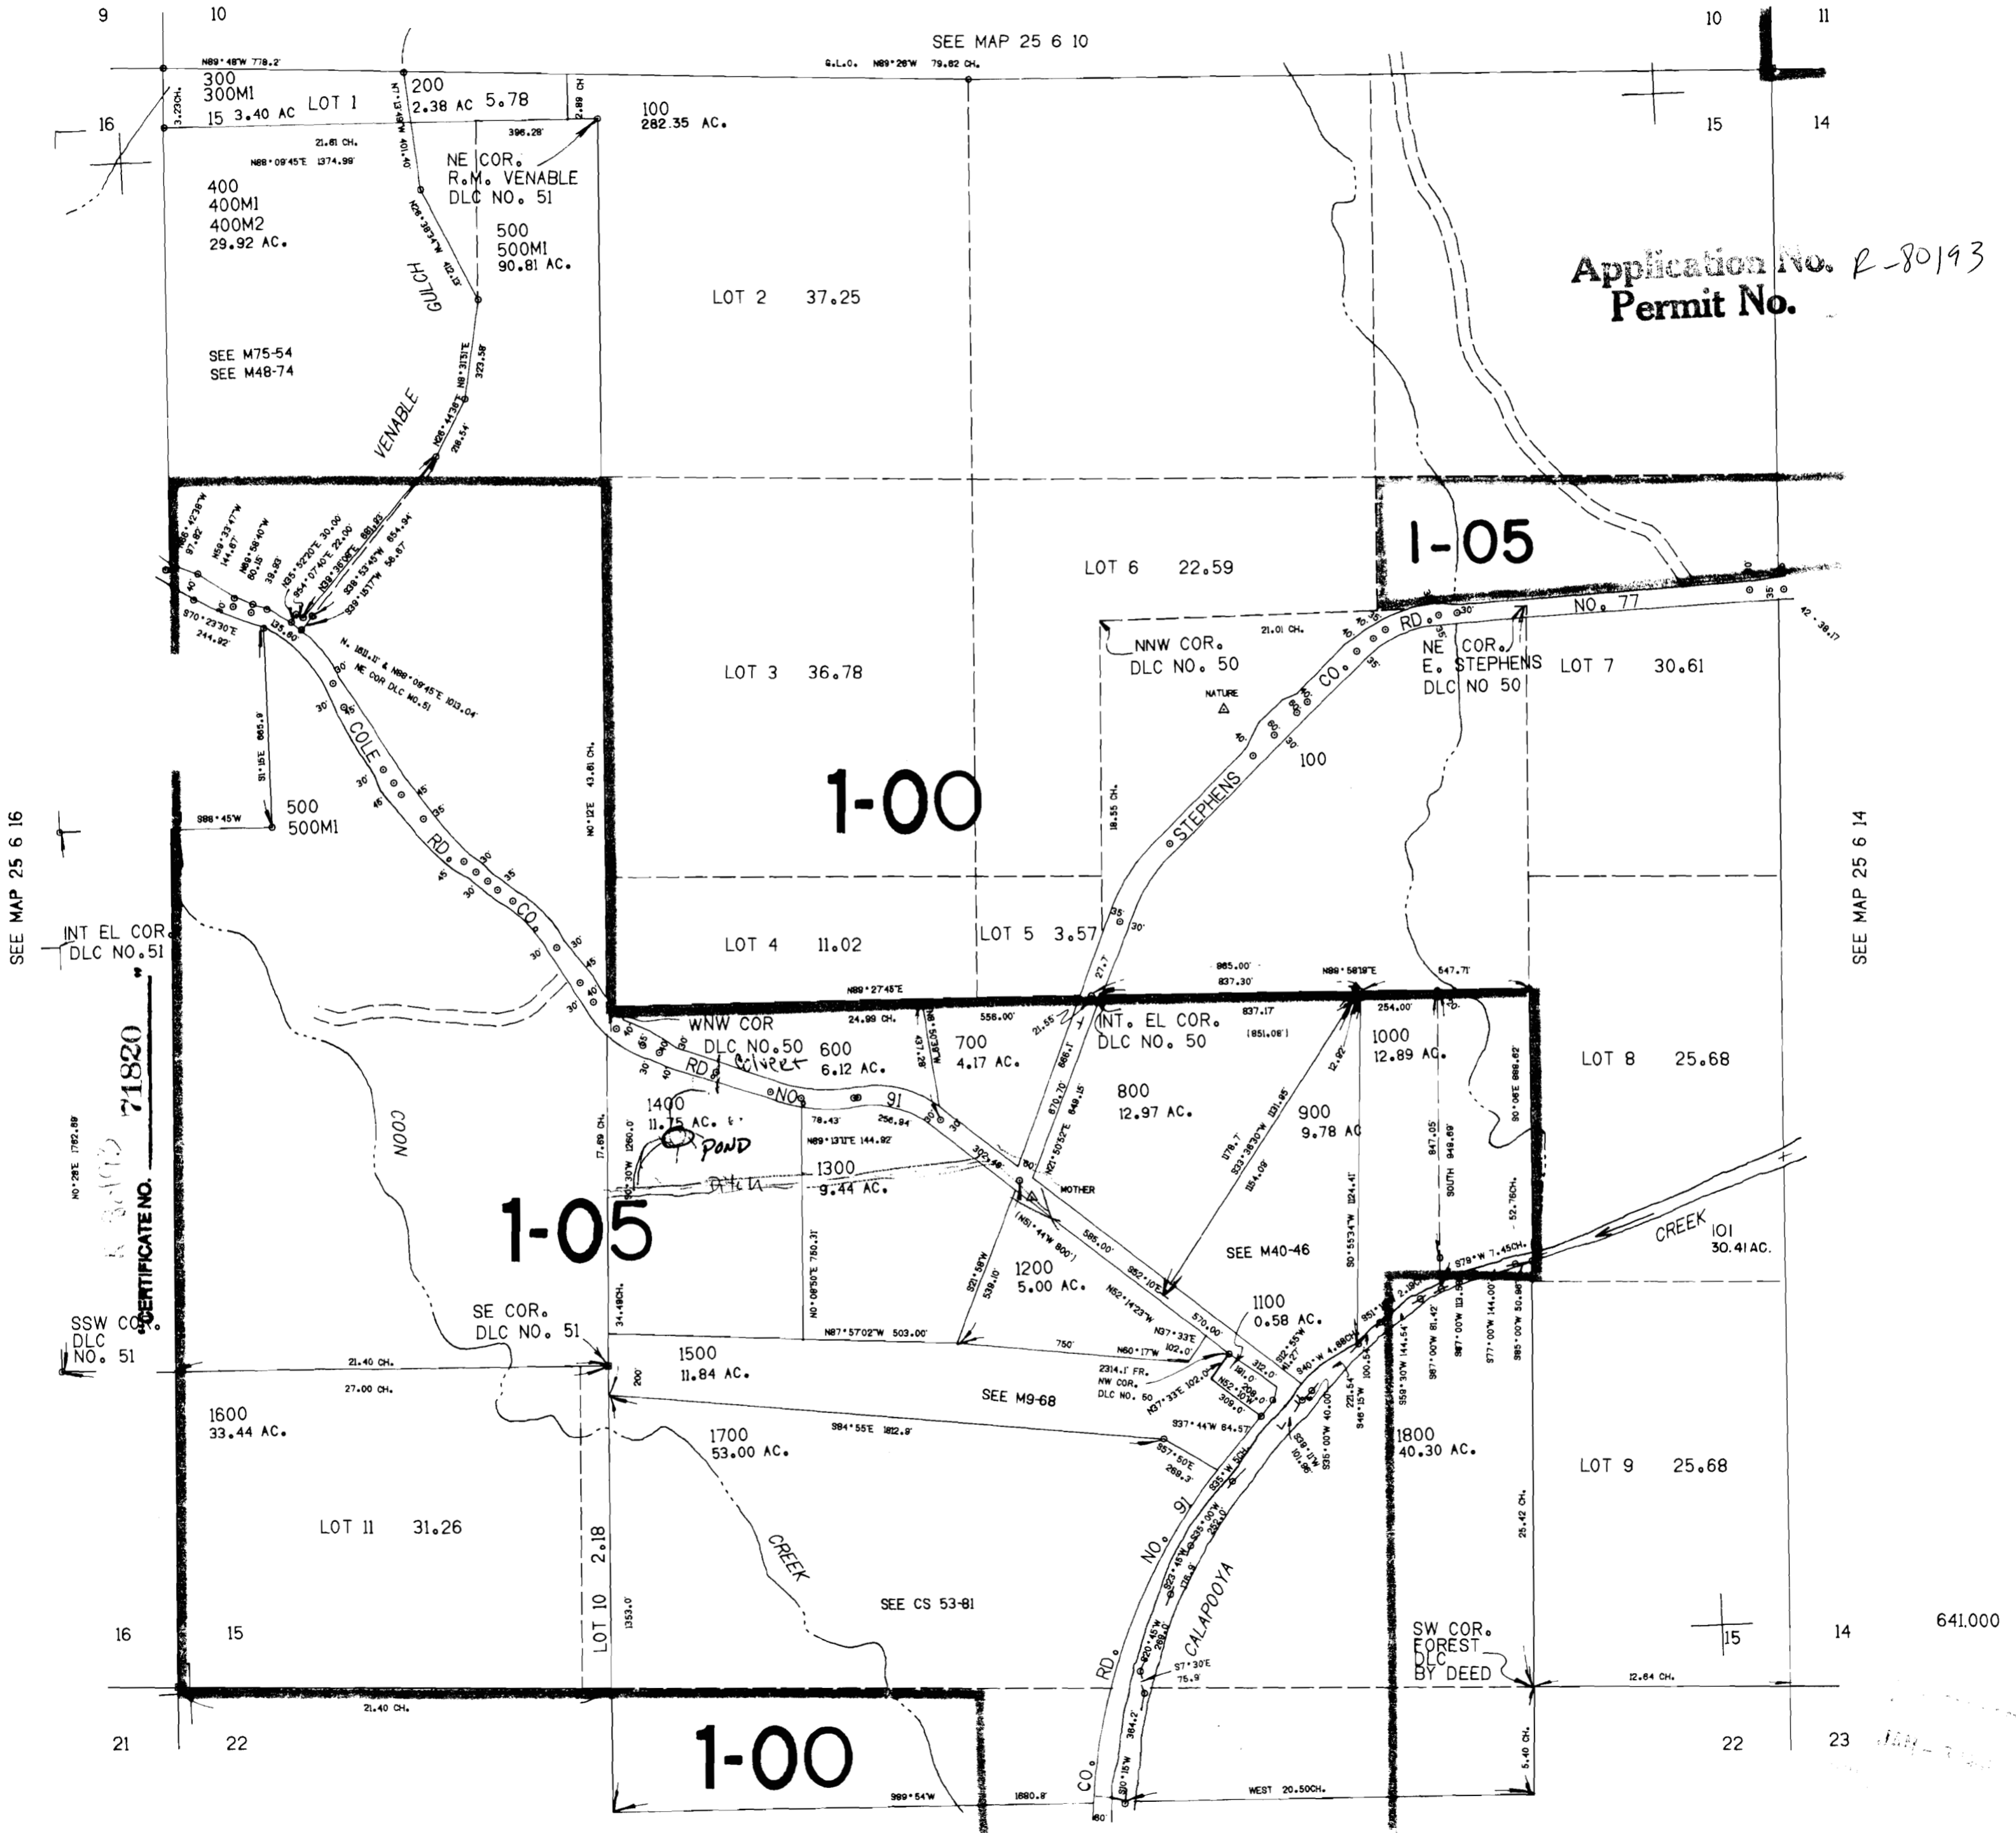

Application No. R-80193
Permit No.

SEE MAP 25 6 16

SEE MAP 25 6 14

SEE MAP 25 6 22

25 6 15

233.000