
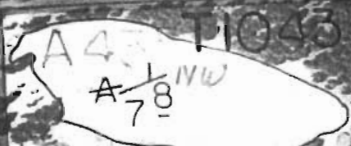


26 25

RECEIVED

JUN - 3 1995

WATER RESOURCES DEPT
SALMON, OREGON

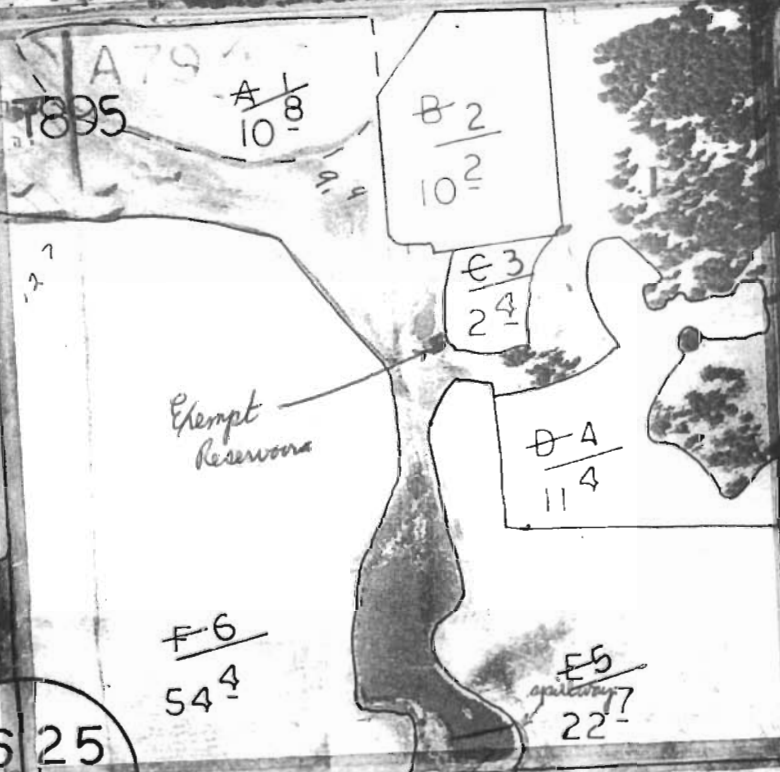

T1075

T1056

T1036

T1092

71824

CERTIFICATE NO.

Application No. R-8019

Permit No.

A 1 / 54 1

1994 aerial Photo

A 1 / 4 6 NW HEL

NW

