


SECTION 10 T.28S. R.7W. W.M.
DOUGLAS COUNTY

REVISED ON
5-24-94

28 7 10

1"=400'


SEE MAP 28 7 3

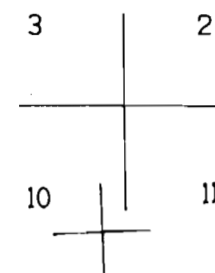

CANCELLED NOS
501

SEE MAP 28 7 11

THIS MAP WAS PREPARED FOR
ASSESSMENT PURPOSE ONLY.

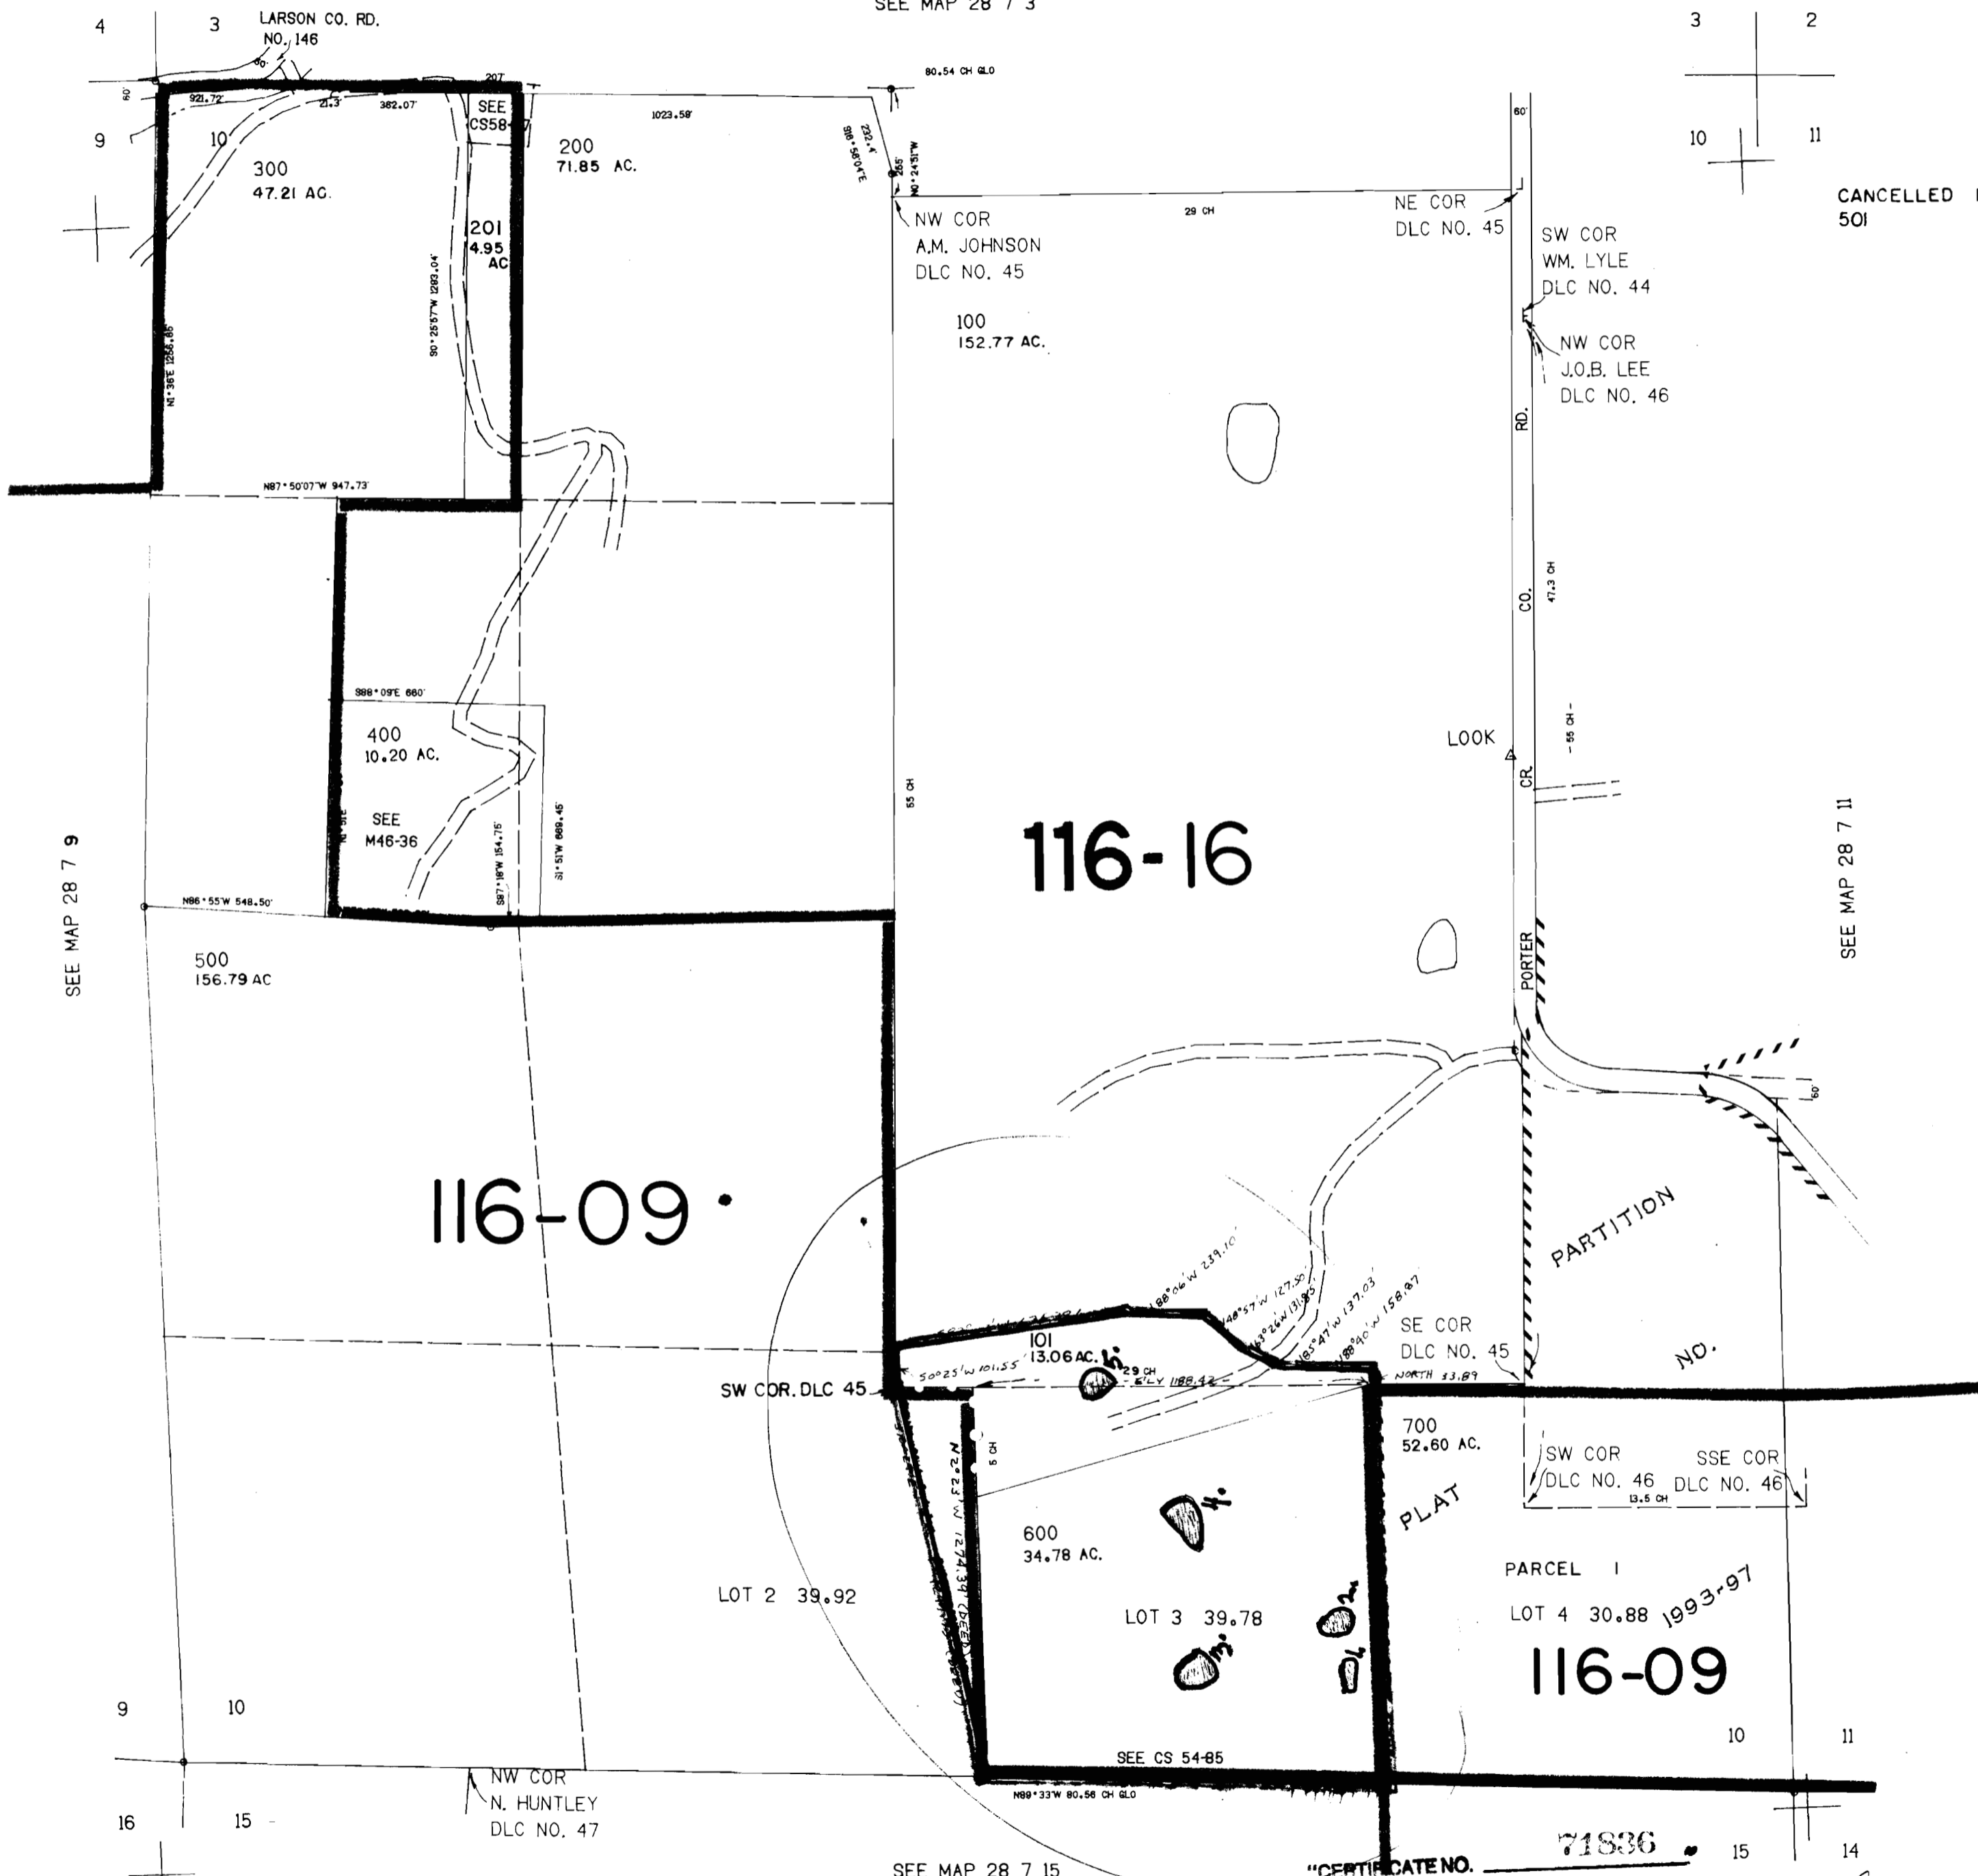

SEE MAP 28 7 9

116-09

116-16

PARTITION

PLAT

PARCEL 1
LOT 4 30.88 1993-97

116-09

CERTIFICATE NO. 71836

Application No. R-80229
Permit No.

SEE MAP 28 7 15

552.000

28 7 10