


K45 E

170 L

Map A

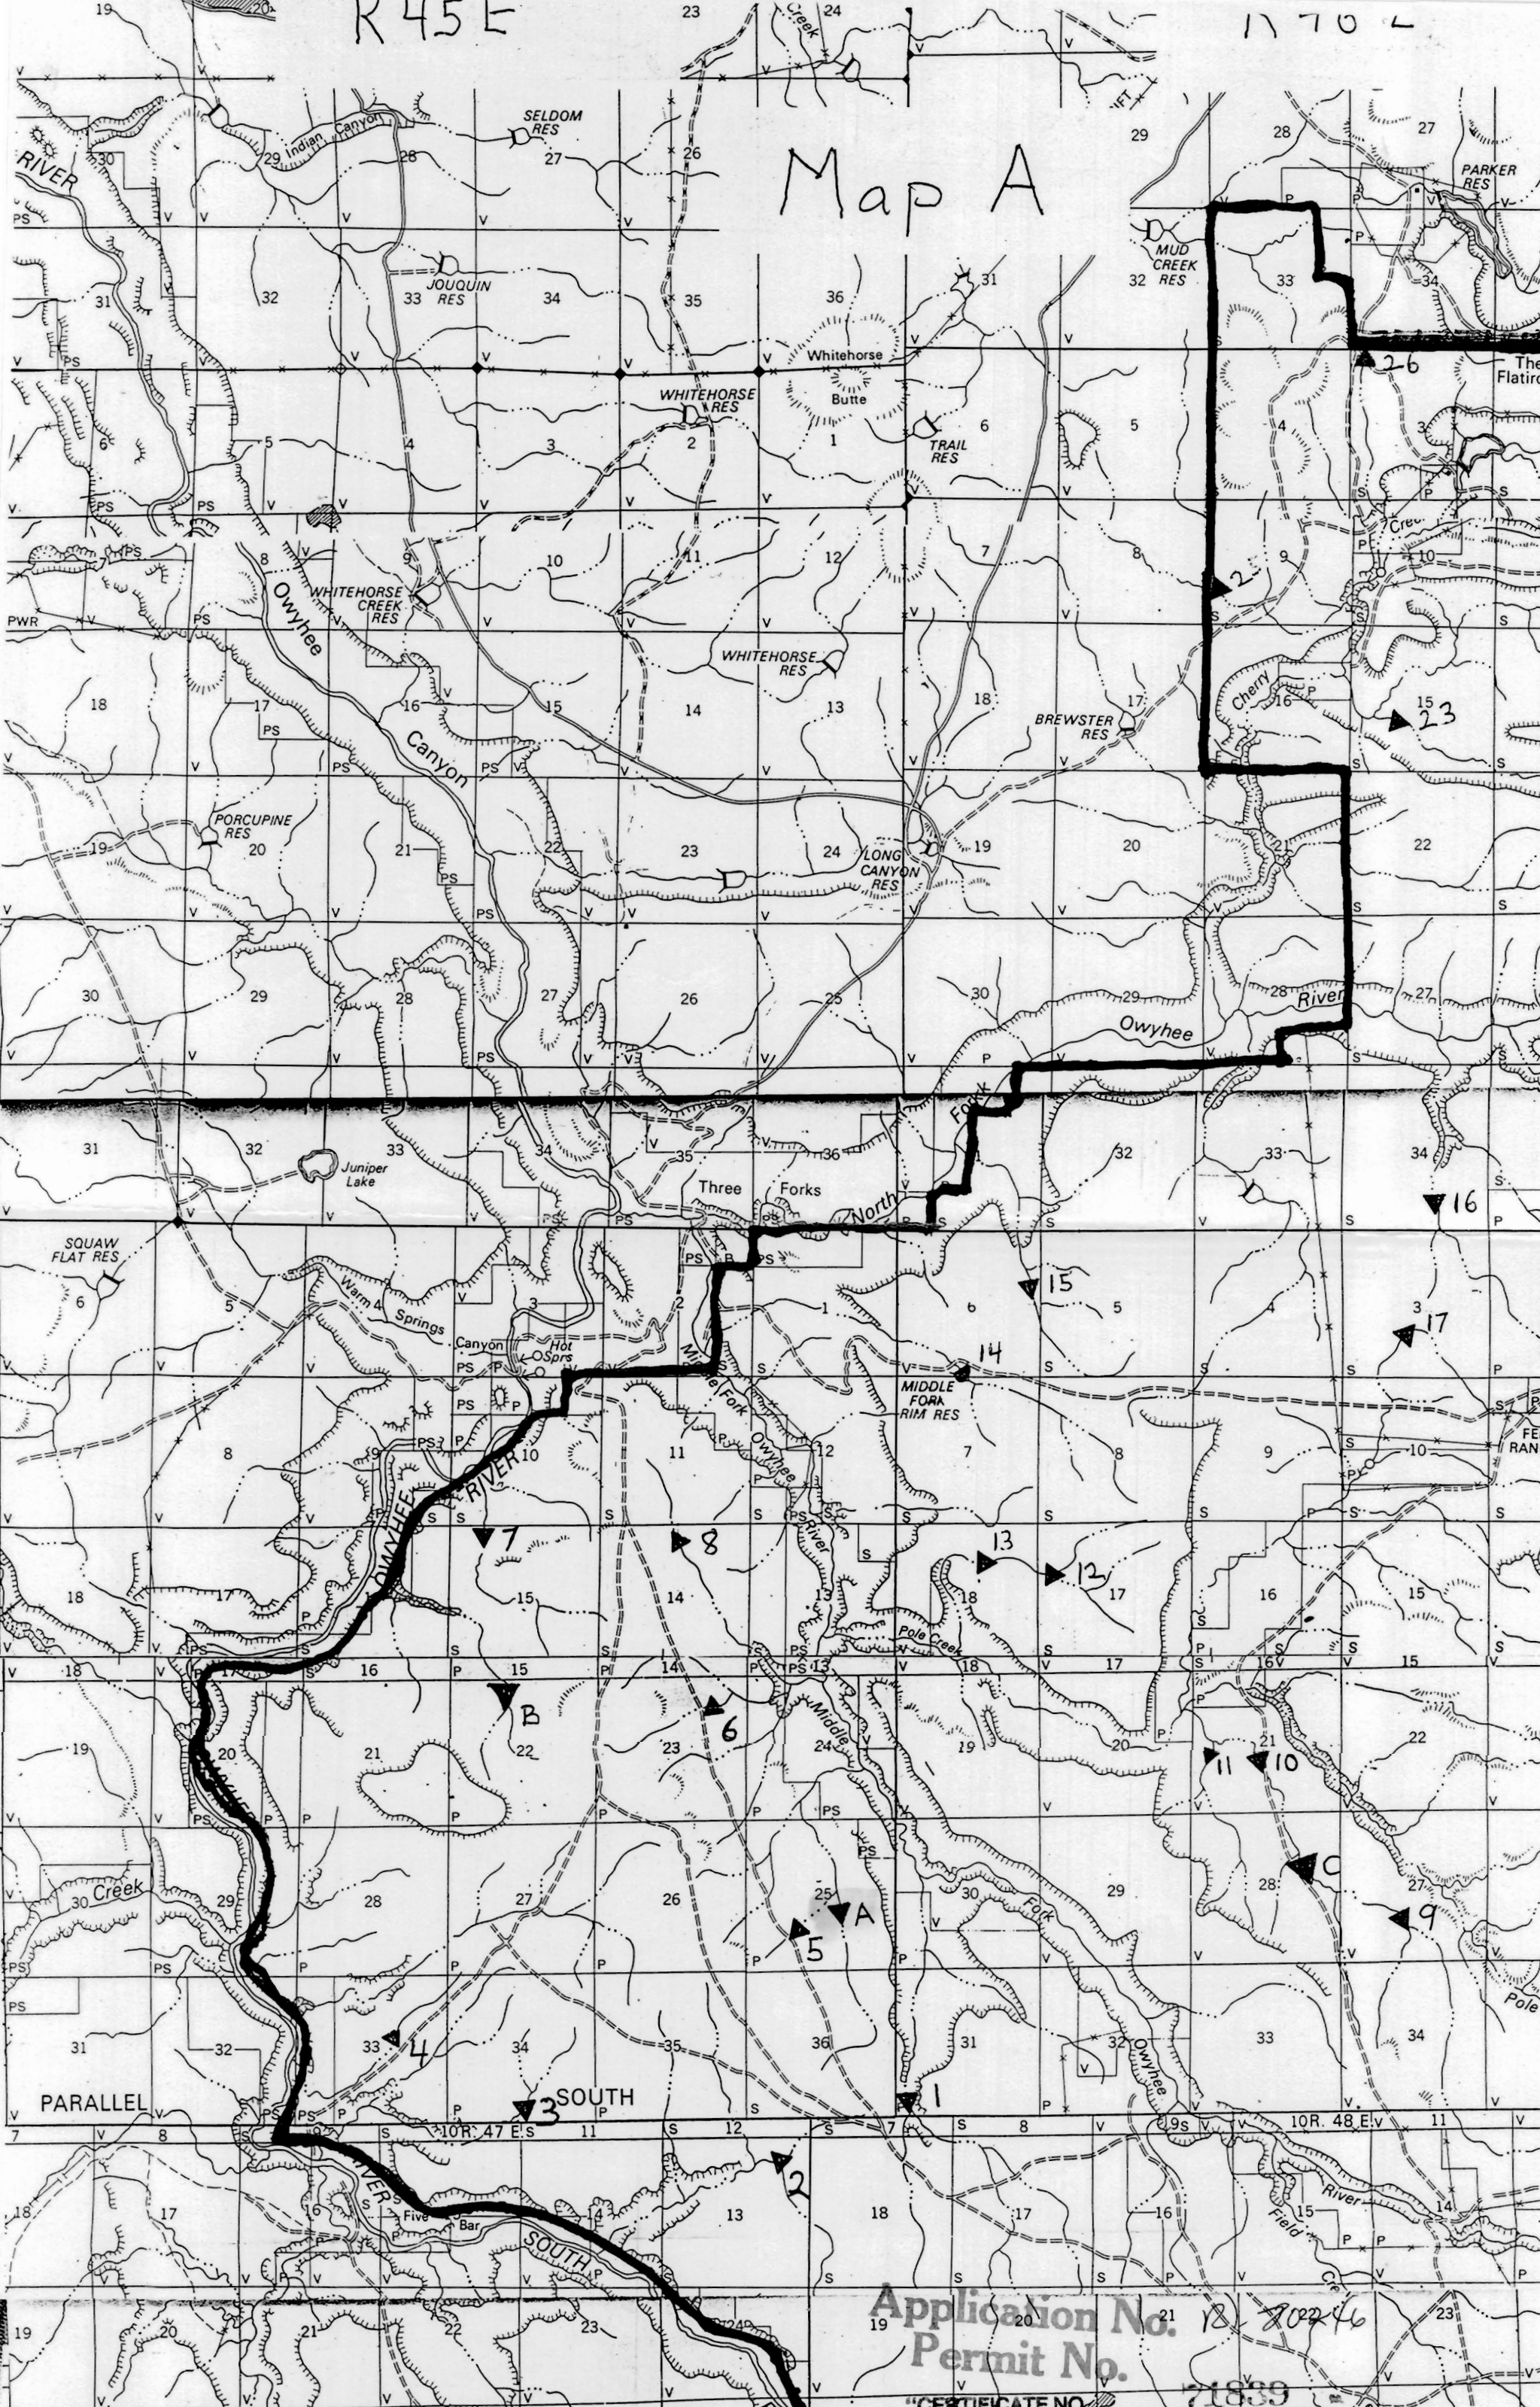

Application No. 18 20246
 Permit No. 71839
 "CERTIFICATE NO. 71839"