T.4N. R.41E. W.M.
WALLOWA COUNTY
1"= 2000'

POND LOCATIONS

"CERTIFICATE NO. 71843 "

Application No. R-80251
Permit No.

T.4N. R.42E. W.M.
WALLOWA COUNTY
1"= 2000'

SEE MAP 5N 41
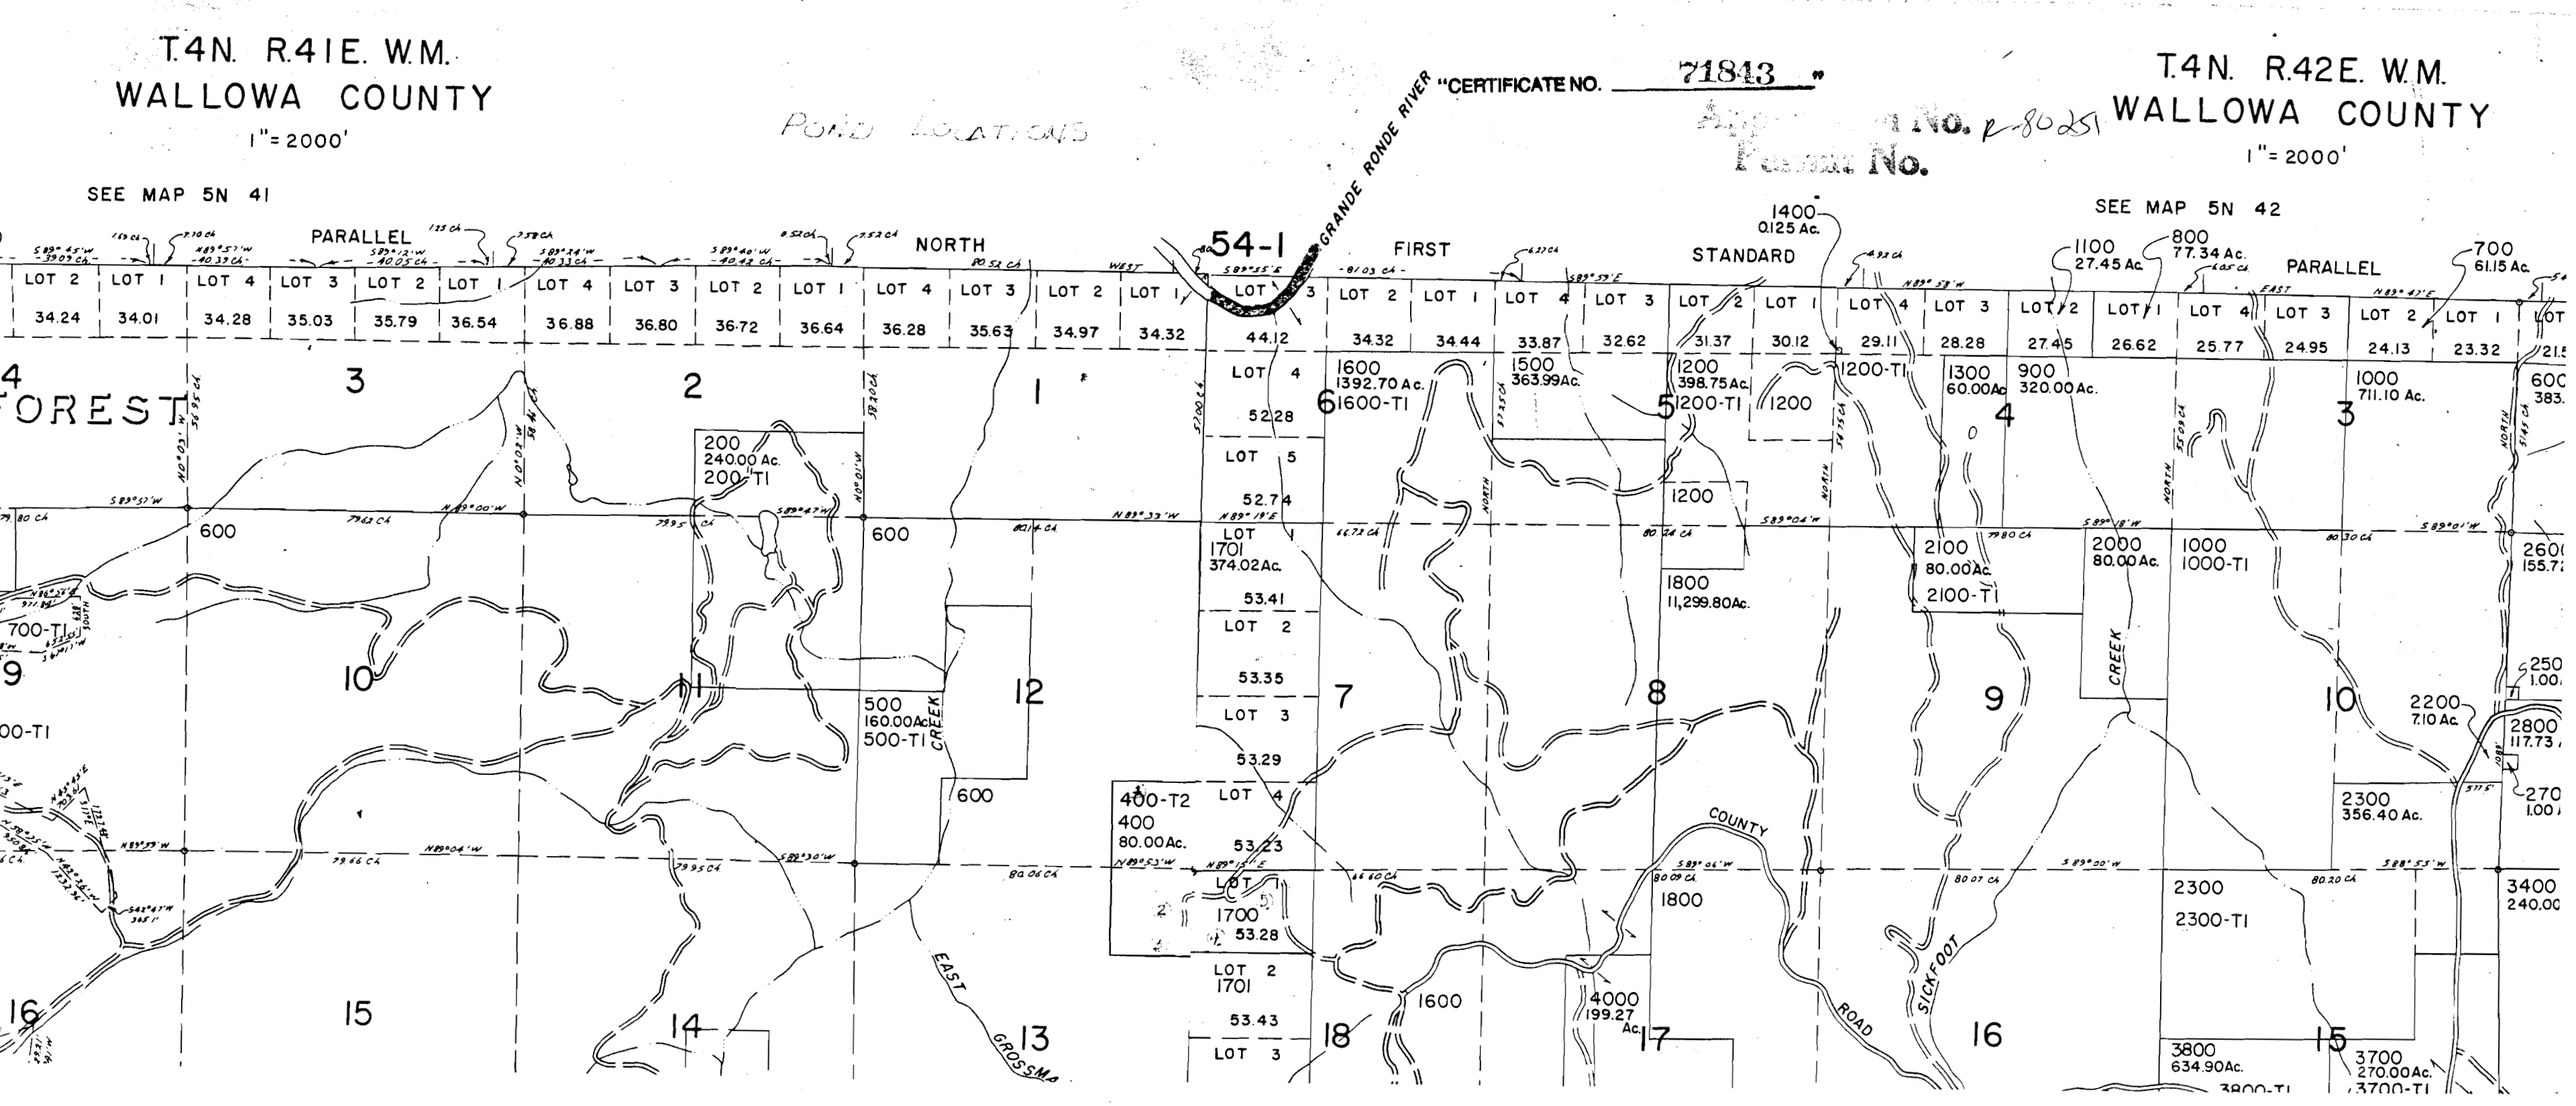
SEE MAP 5N 42