


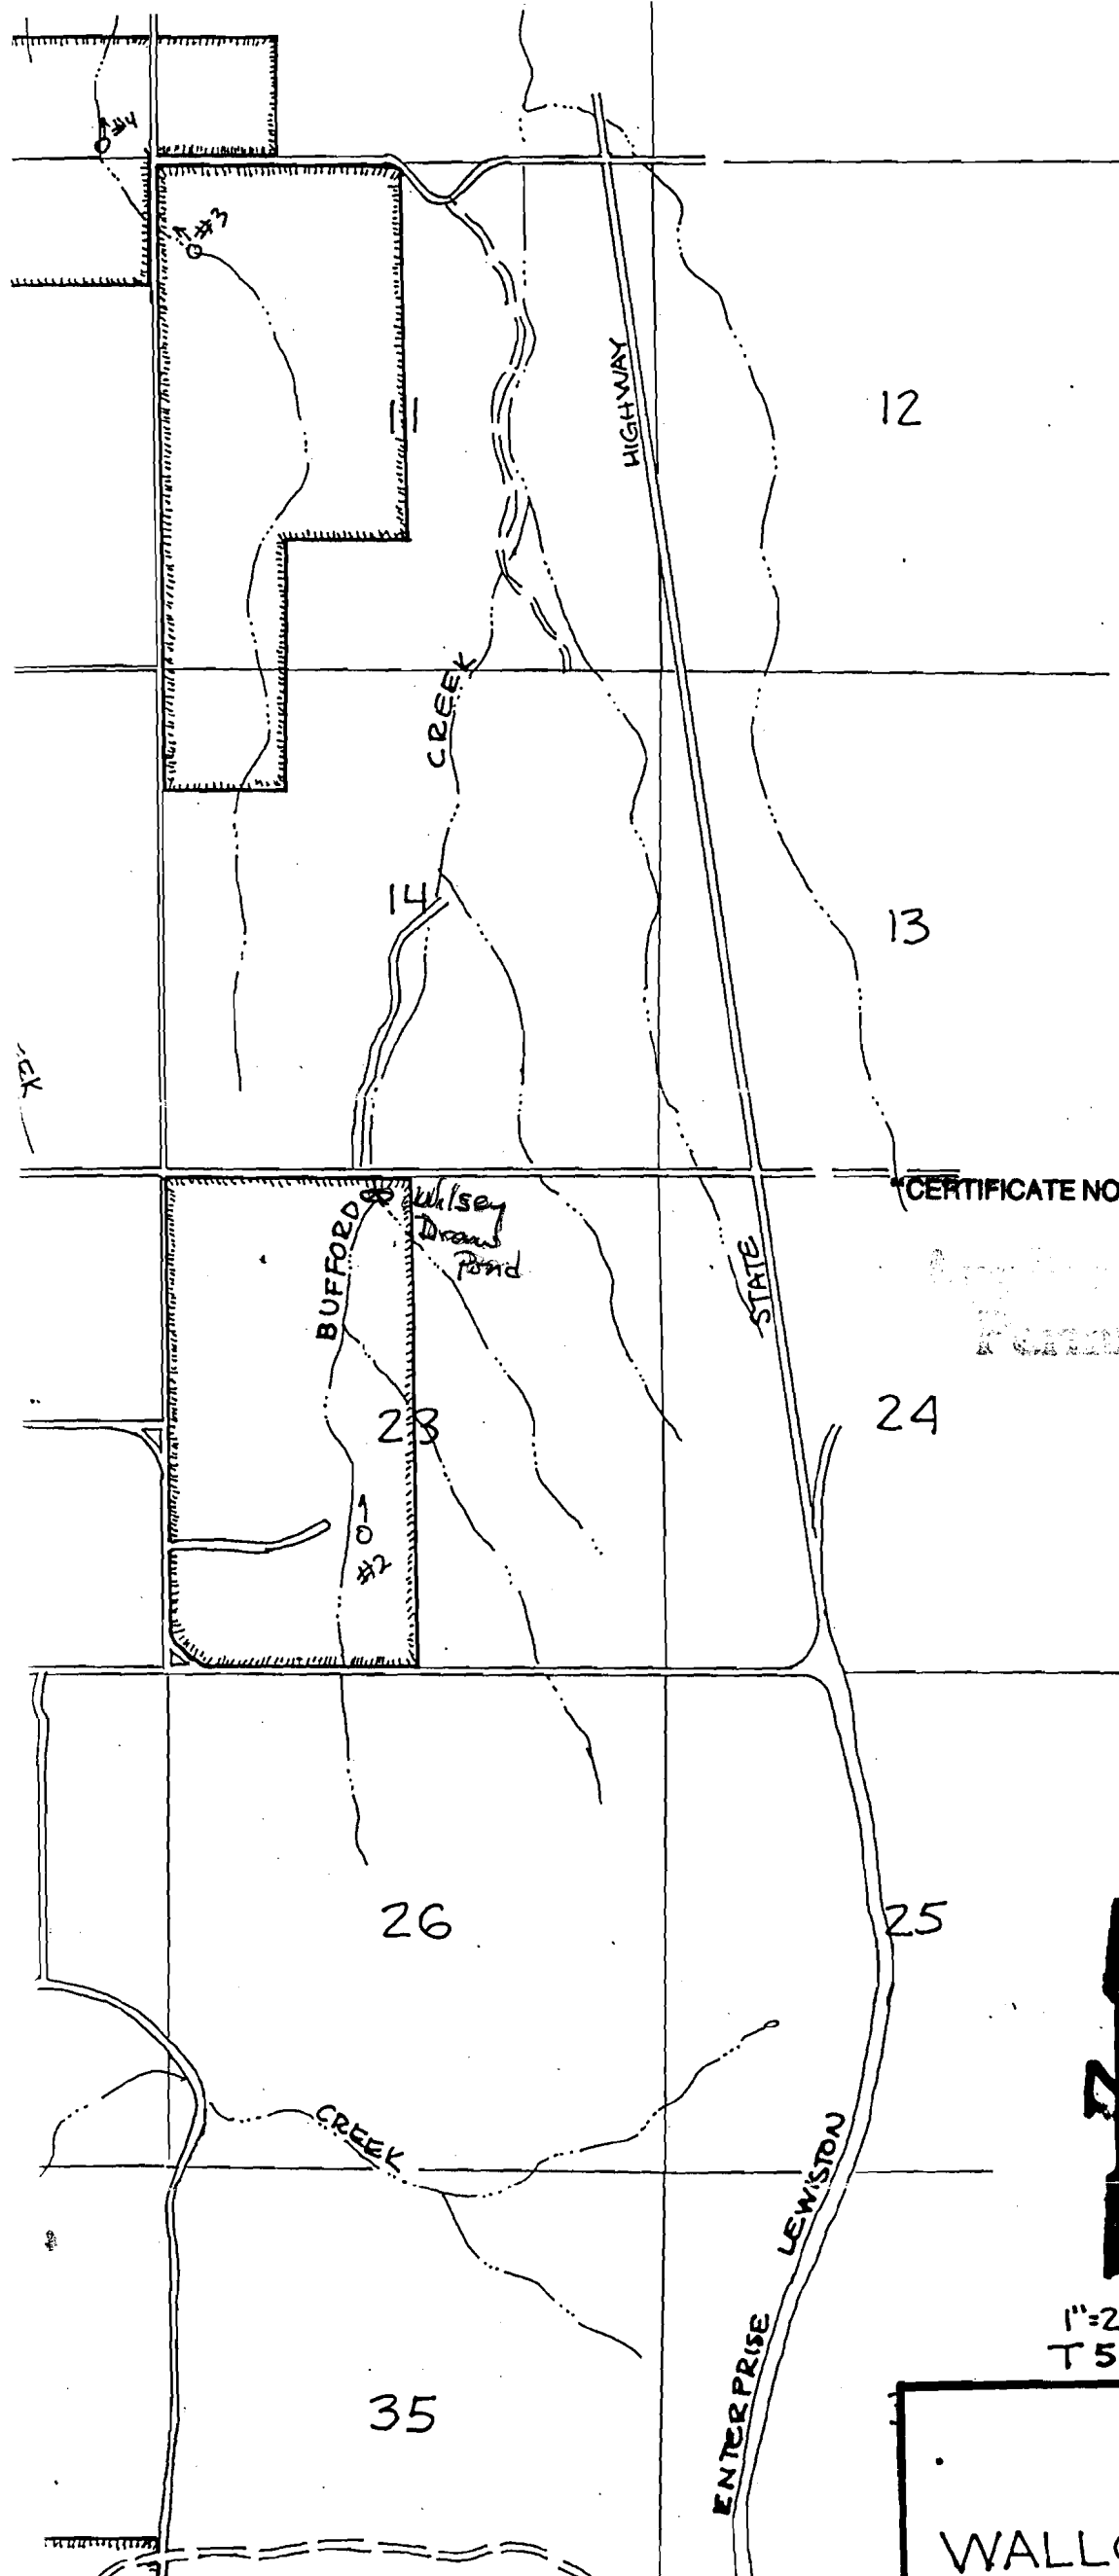

CERTIFICATE NO. 71814

Application No. P-80252
Permit No.



MAP BASED ON WALLOWA
COUNTY ASSESSOR MAP

1"=2000'
T5N, R44E

WALLOWA COUNTY