

SECTION 30 T.23S. R.5W. W.M.
DOUGLAS COUNTY


JAN 25 1996

REVISED ON
1-30-95

23 5 30

THIS MAP WAS PREPARED FOR
ASSESSMENT PURPOSE ONLY.

1"=400'

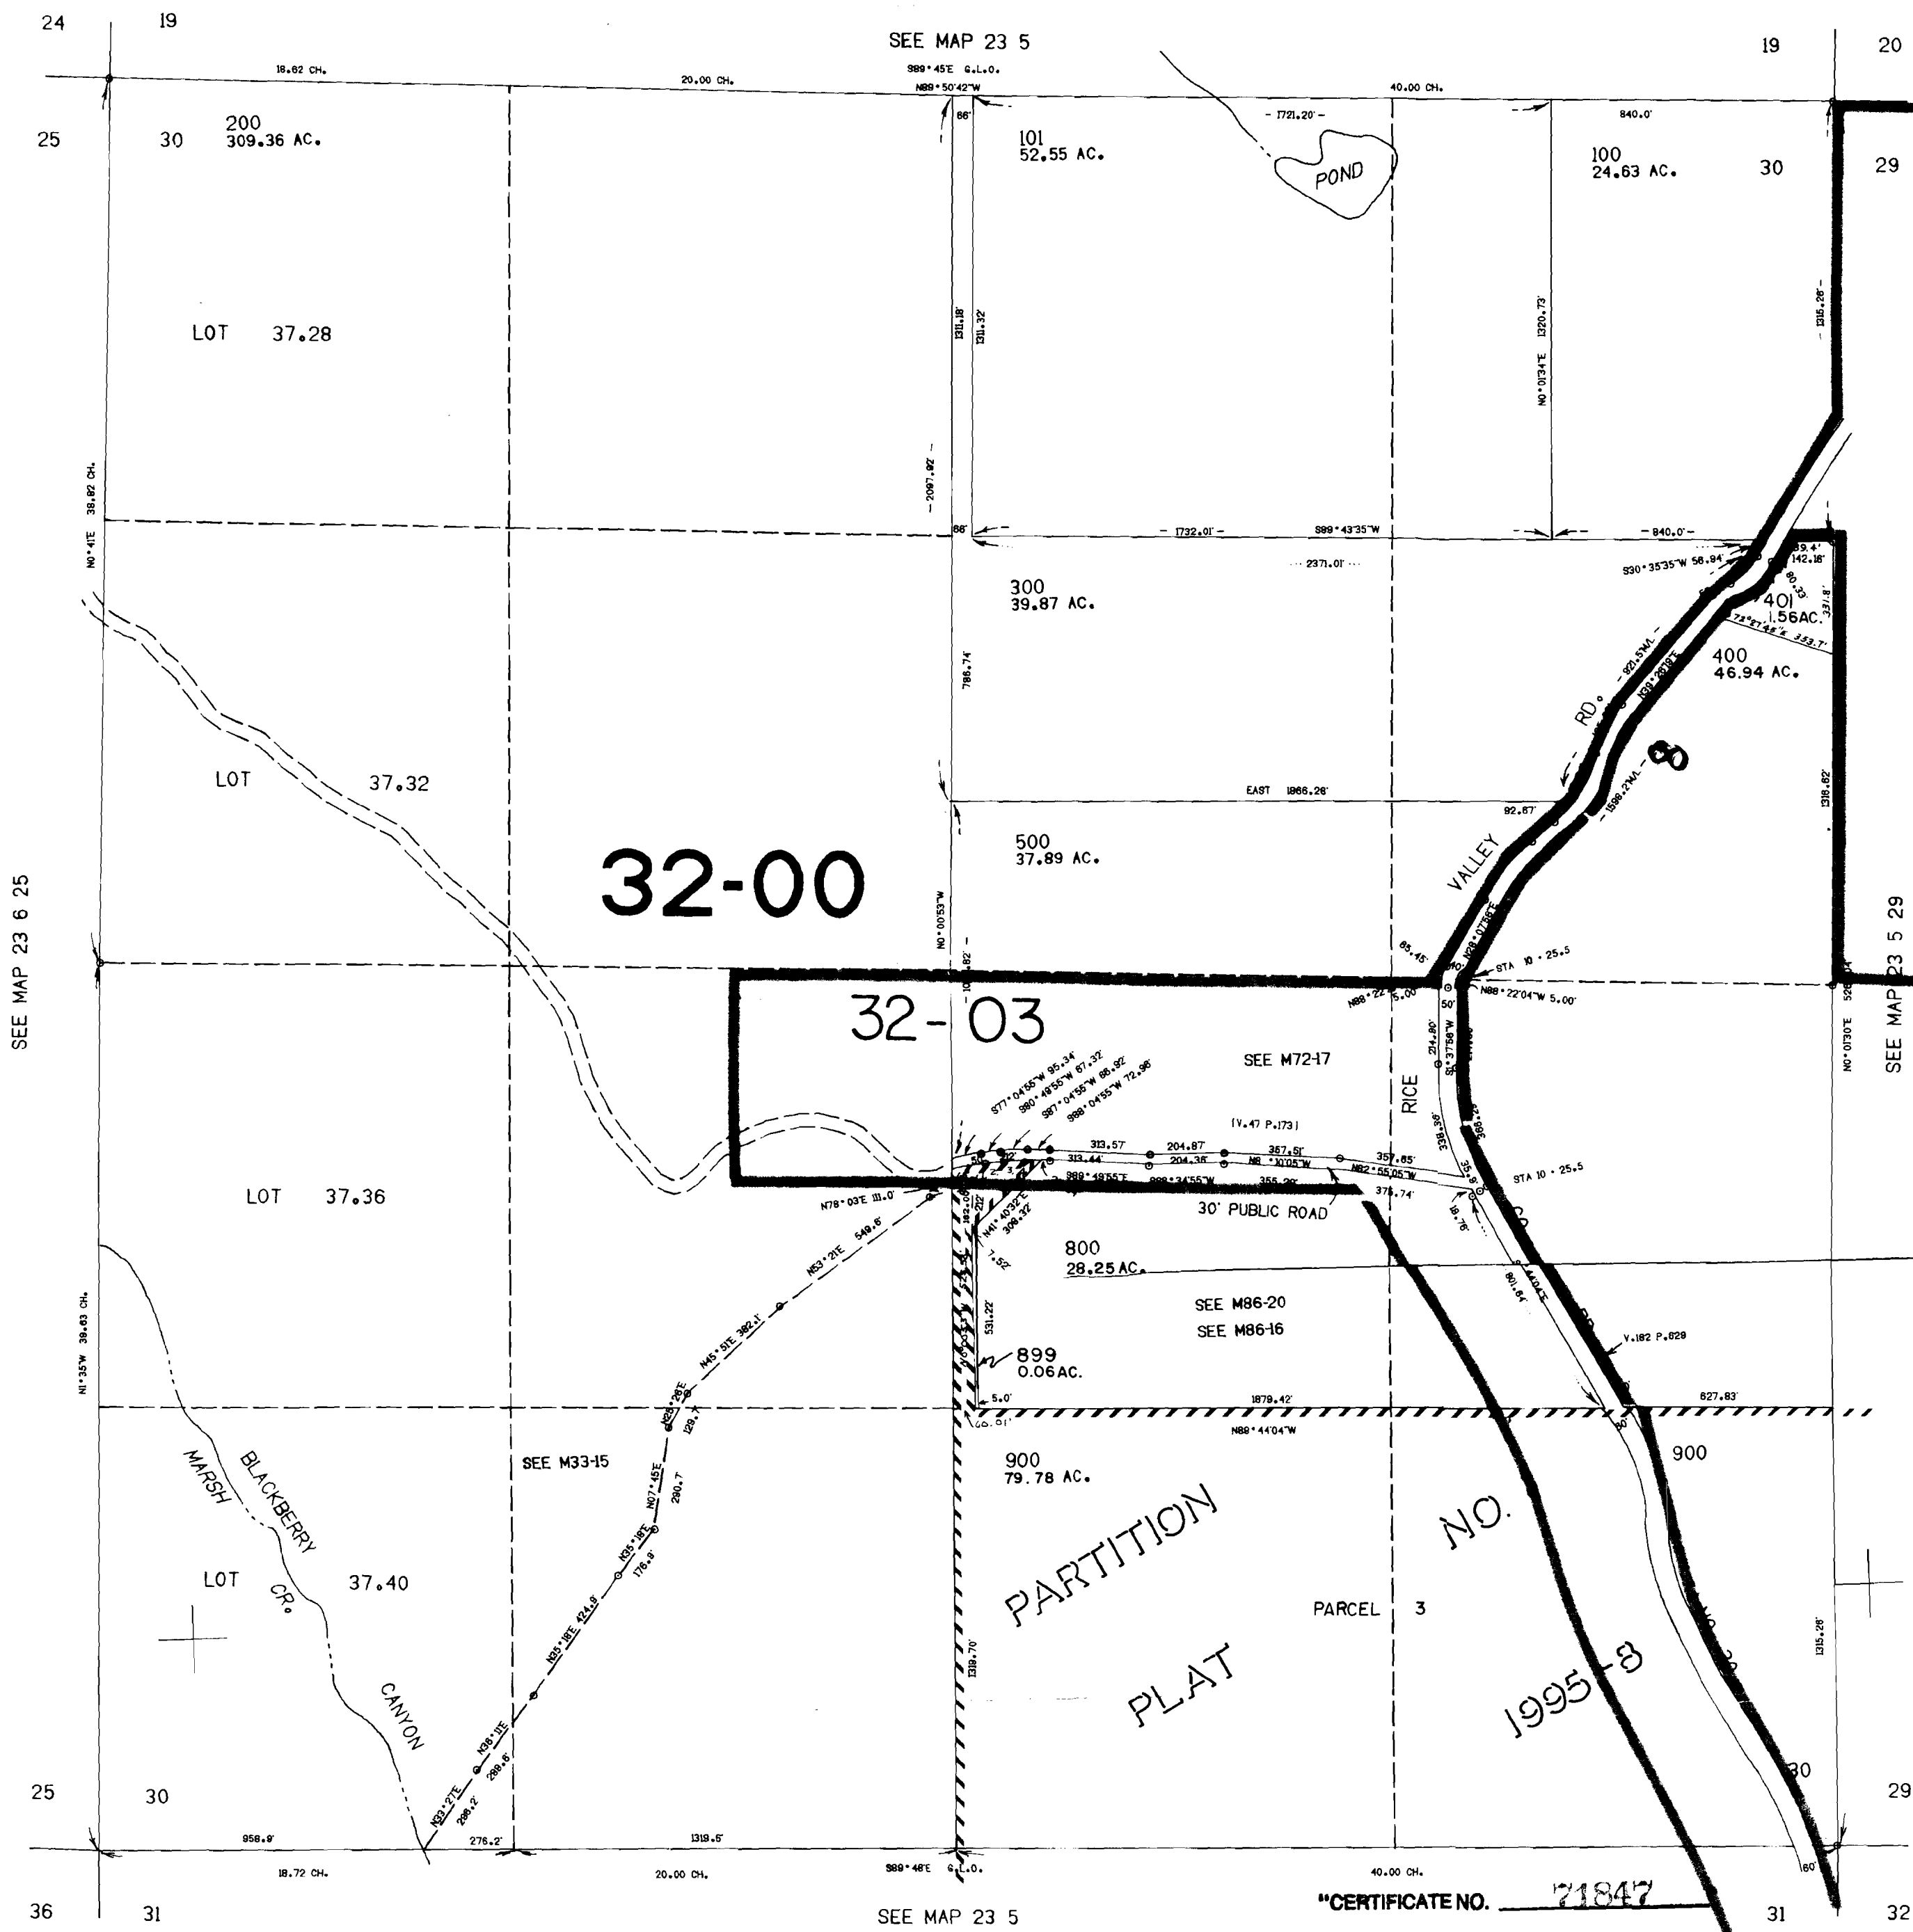

CANCELLED NO'S
600 700

PARCEL 900
1. N38°54'44"E 77.77'
2. N80°48'55"E 54.31'
3. N87°04'55"E 85.23'
4. N88°04'55"E 42.46'

694.000


Application No. R-80256
Permit No.

23 5 30