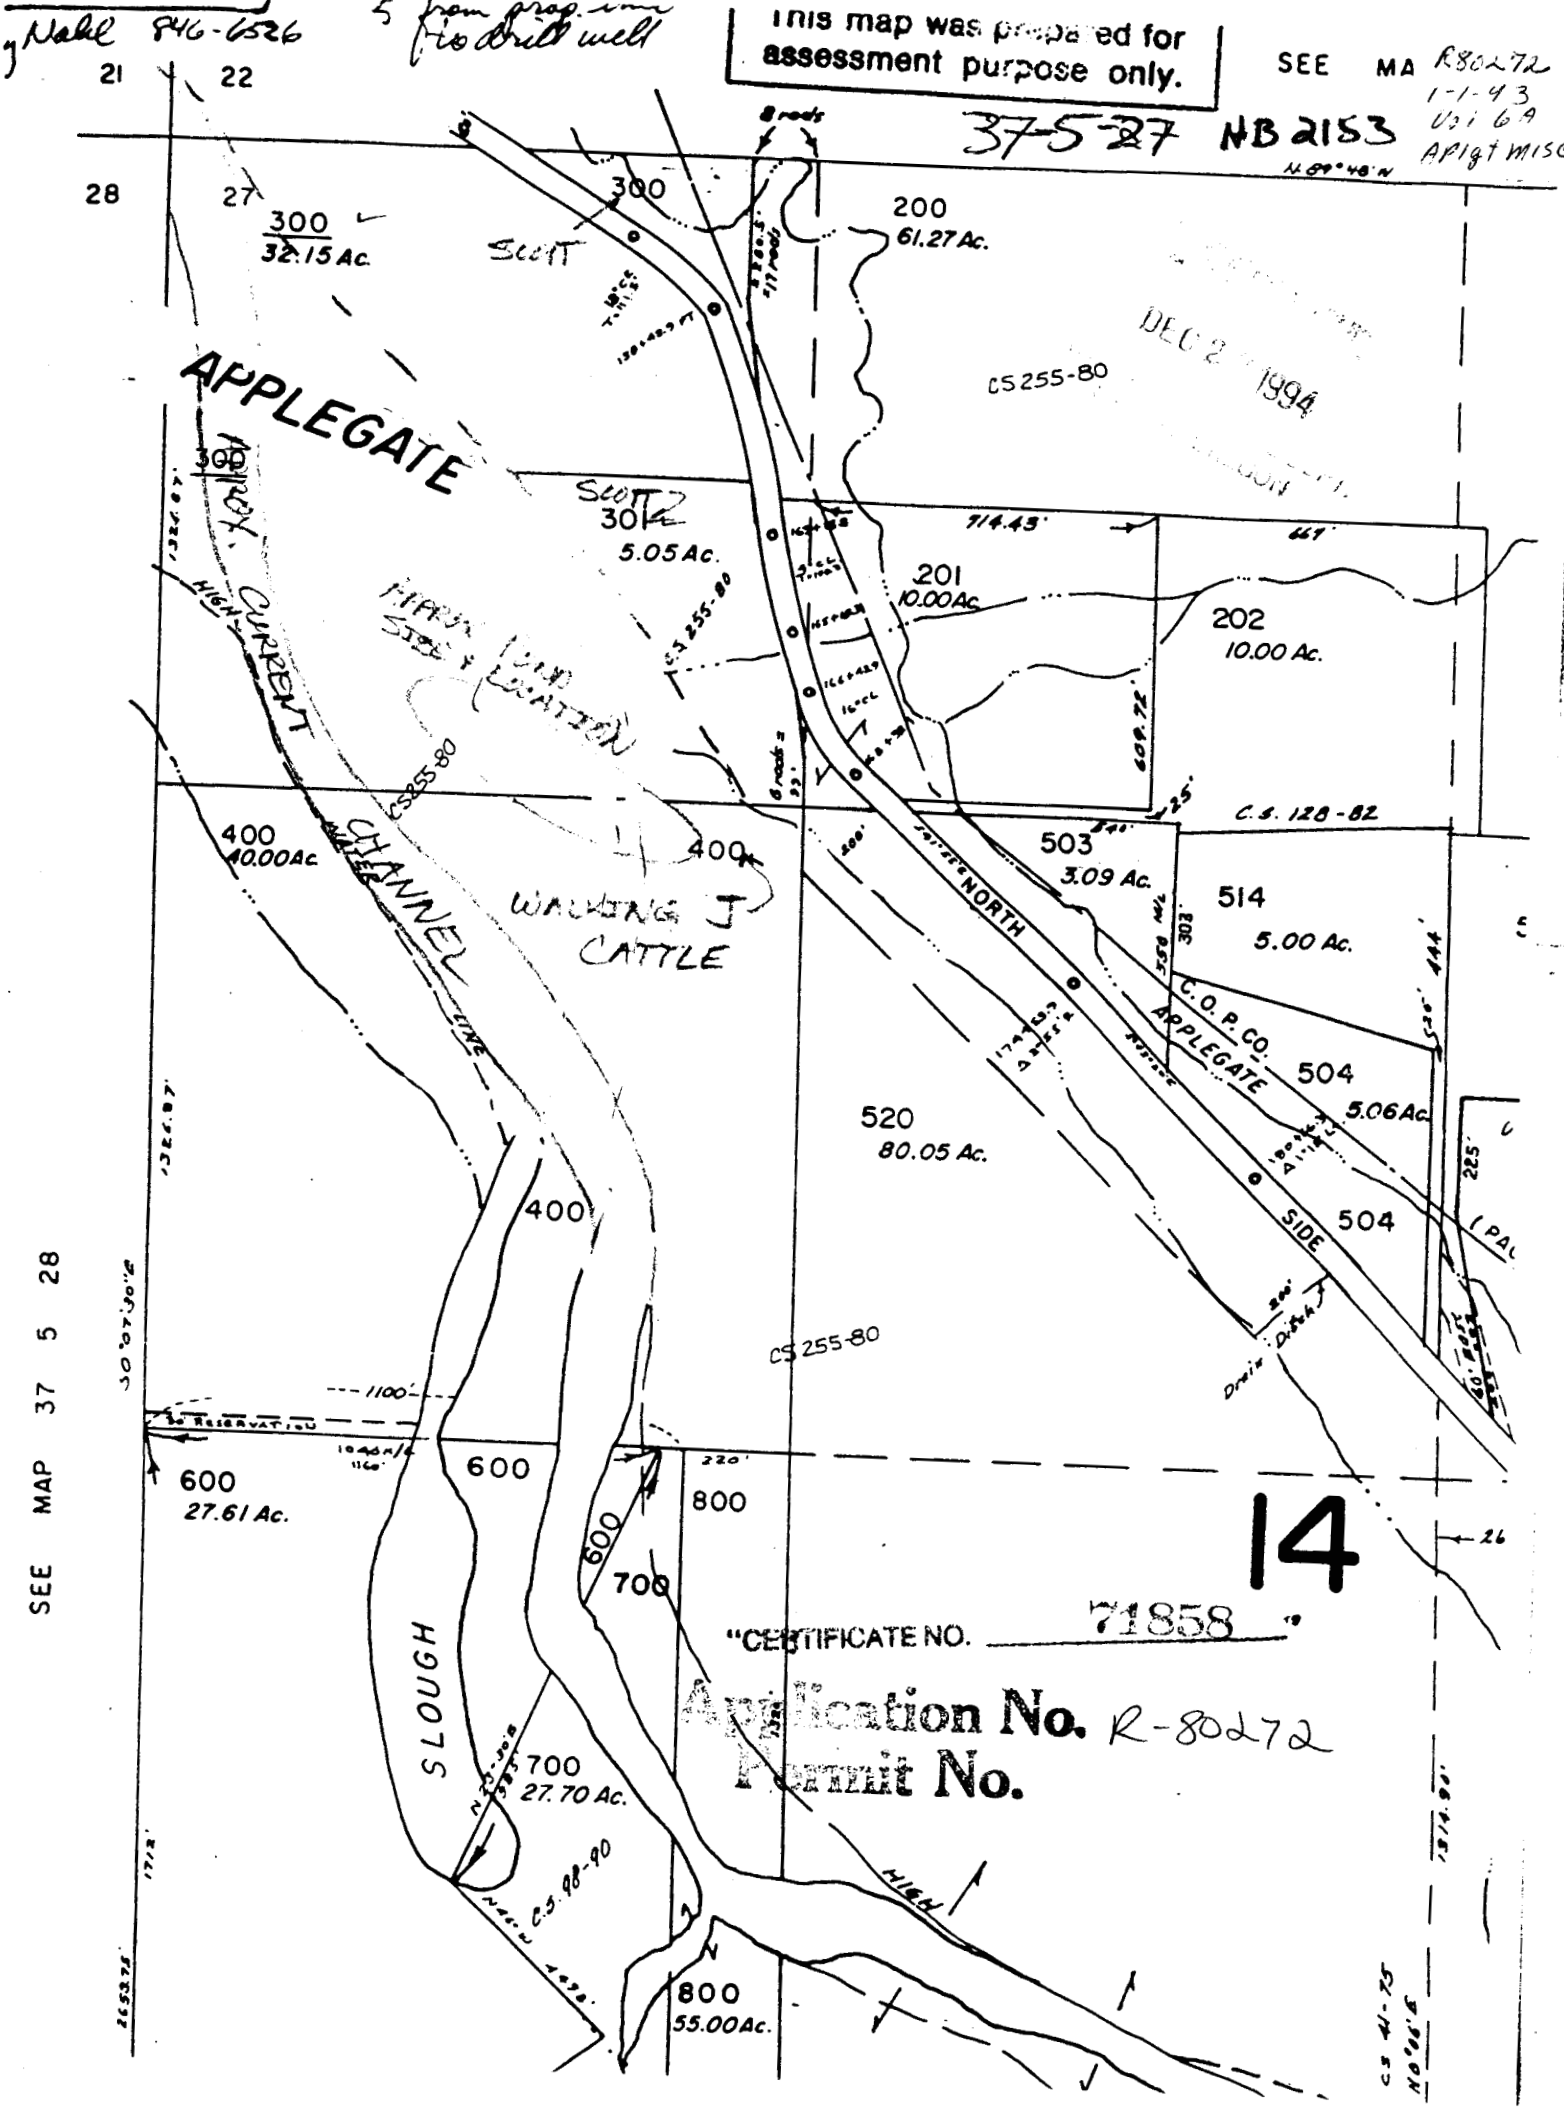
This map was prepared for assessment purpose only.
37-5-27 NB 2153
SEE MA
R80272
1-1-93
Vol 69
Aplgt Misc
DEC 2 1994
APPLEGATE
SCOTT
CURRENT CREEK
CHANNEL
WALKING J CATTLE
SLOUGH
SIDE
NORTH
APPLEGATE
C.O.P. CO.
C.S. 128-82
CS 255-80
CS 98-90
HIGH
21
22
28
27
SEE MAP 37 5 28
300
32.15 Ac.
200
61.27 Ac.
301
5.05 Ac.
201
10.00 Ac.
202
10.00 Ac.
400
40.00 Ac.
503
3.09 Ac.
514
5.00 Ac.
504
5.06 Ac.
520
80.05 Ac.
600
27.61 Ac.
700
27.70 Ac.
800
55.00 Ac.
14
"CERTIFICATE NO. 71858"
Application No. R-80272
Permit No.