


Survey No. R-80275
Parcel No.

DEC 21 1994
WATER RESOURCES DIVISION
SALEM, OREGON

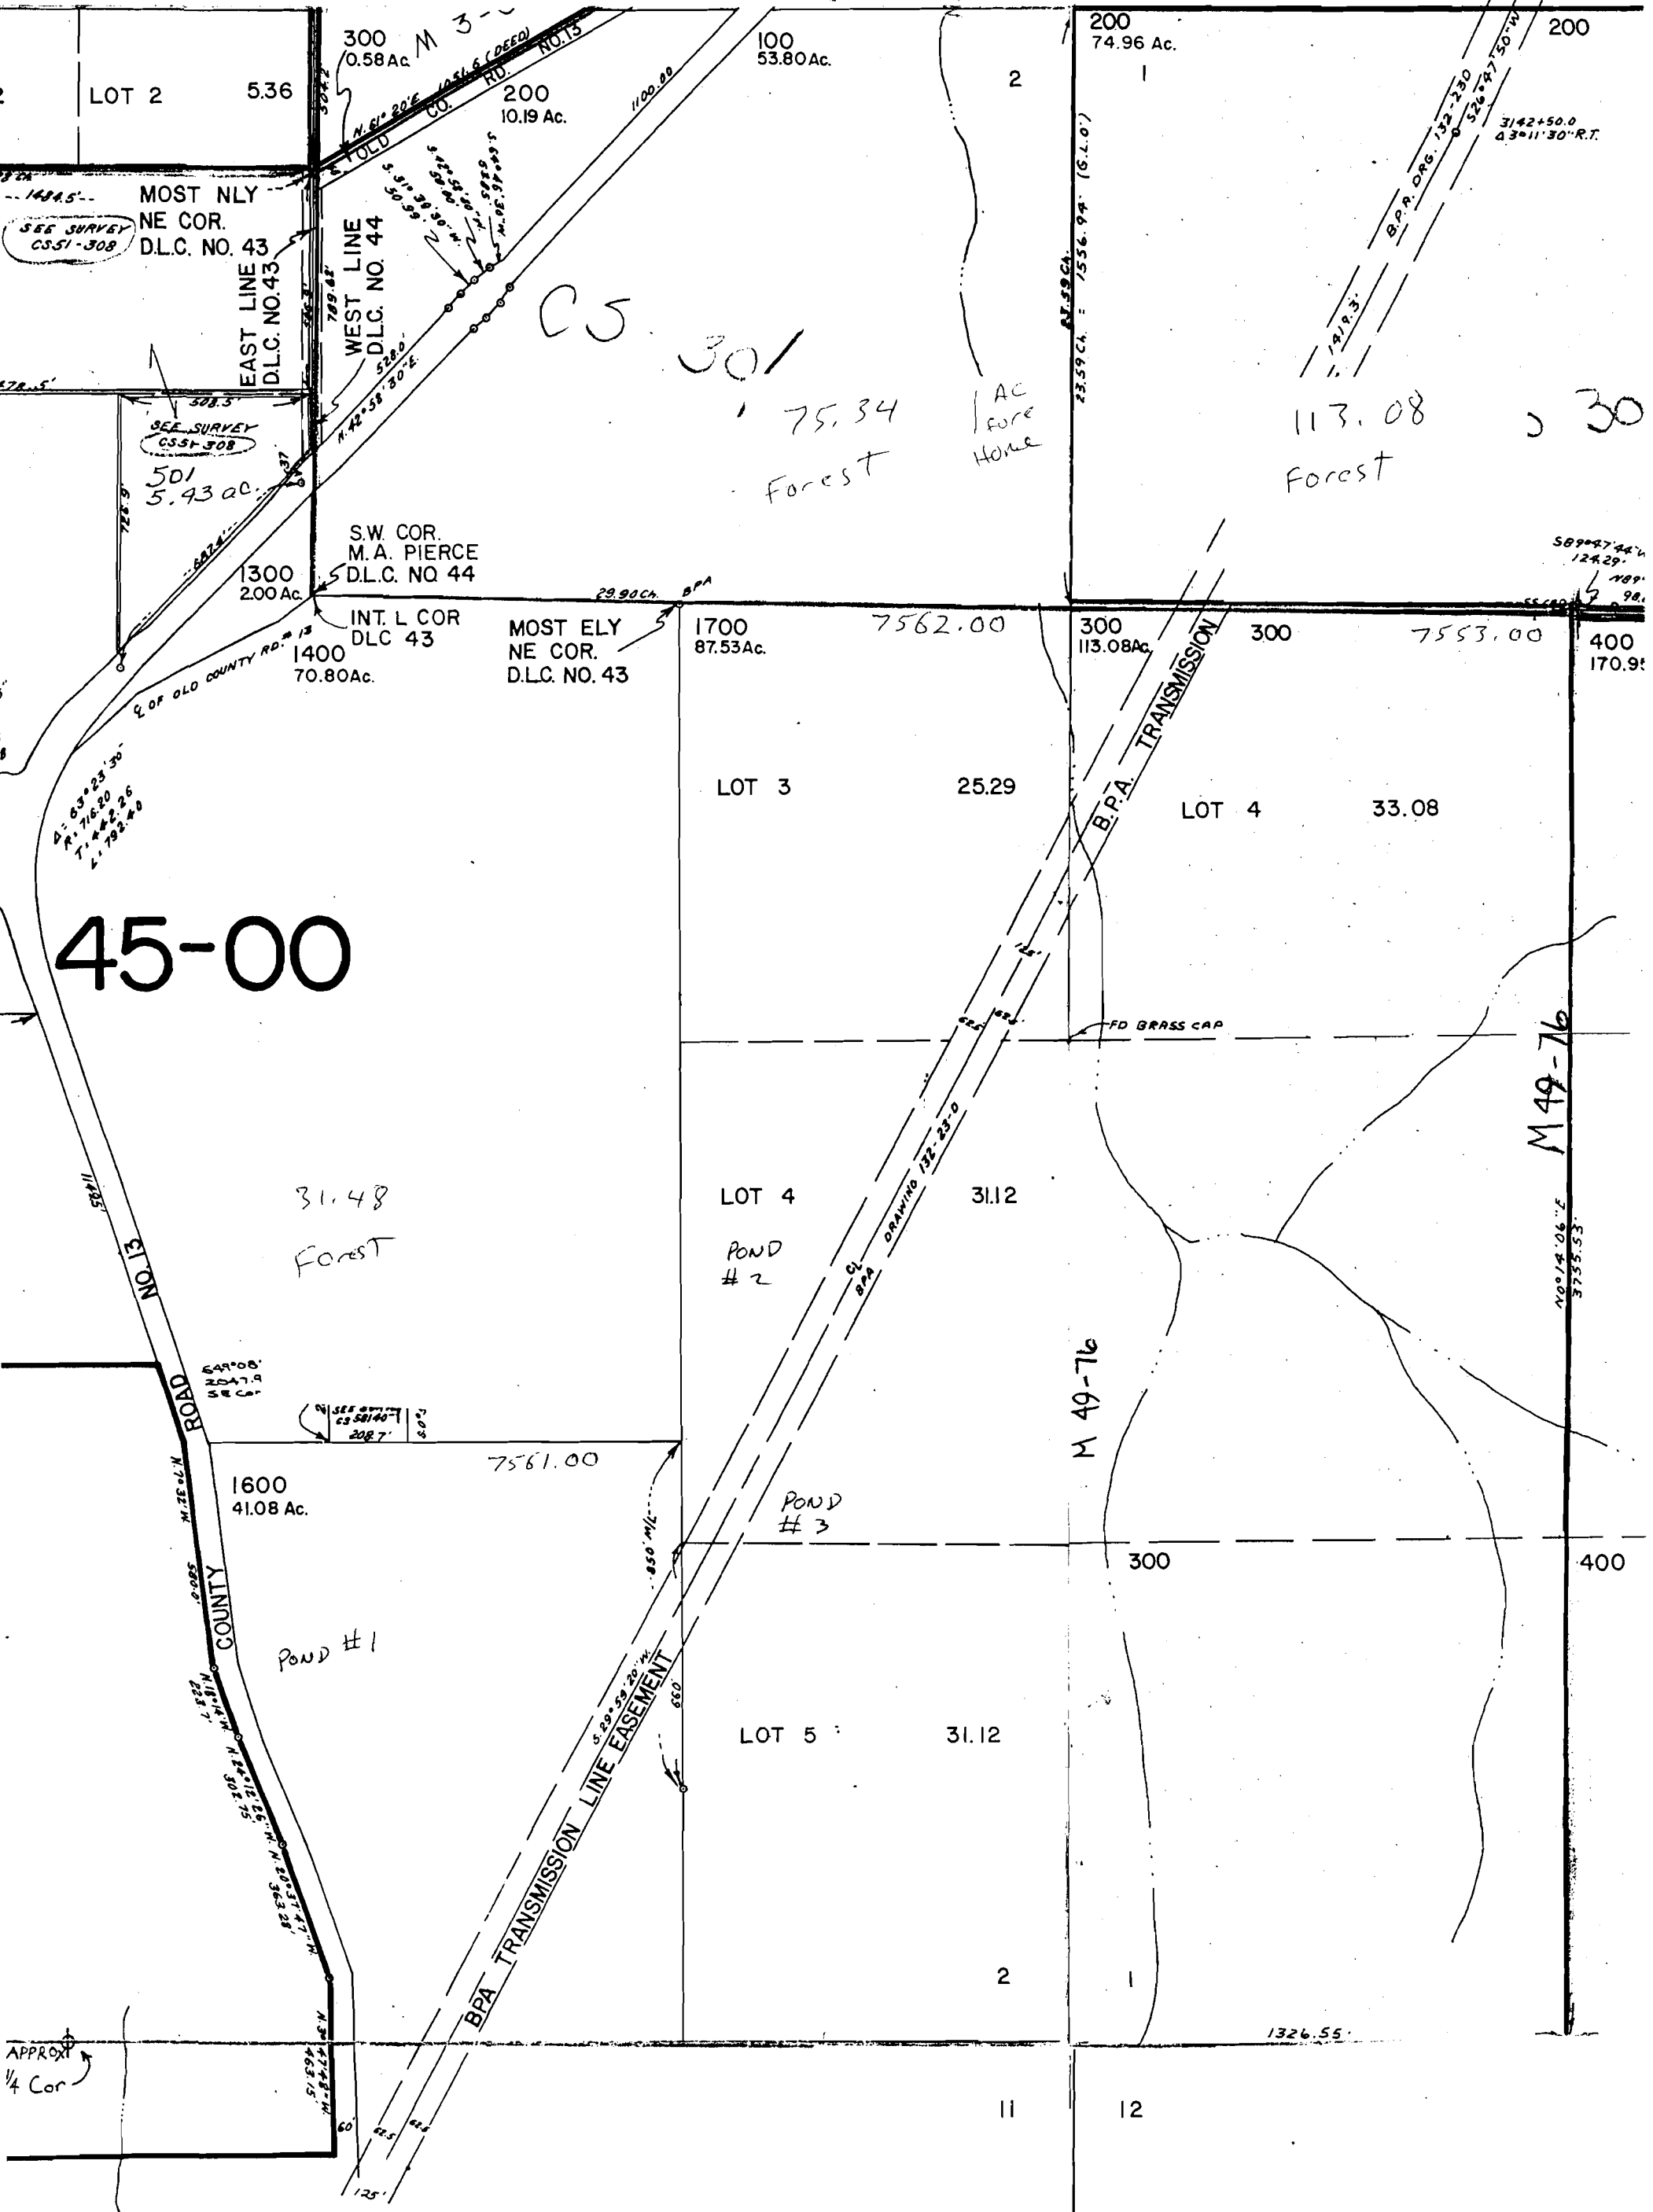

45-00

M 49-76