


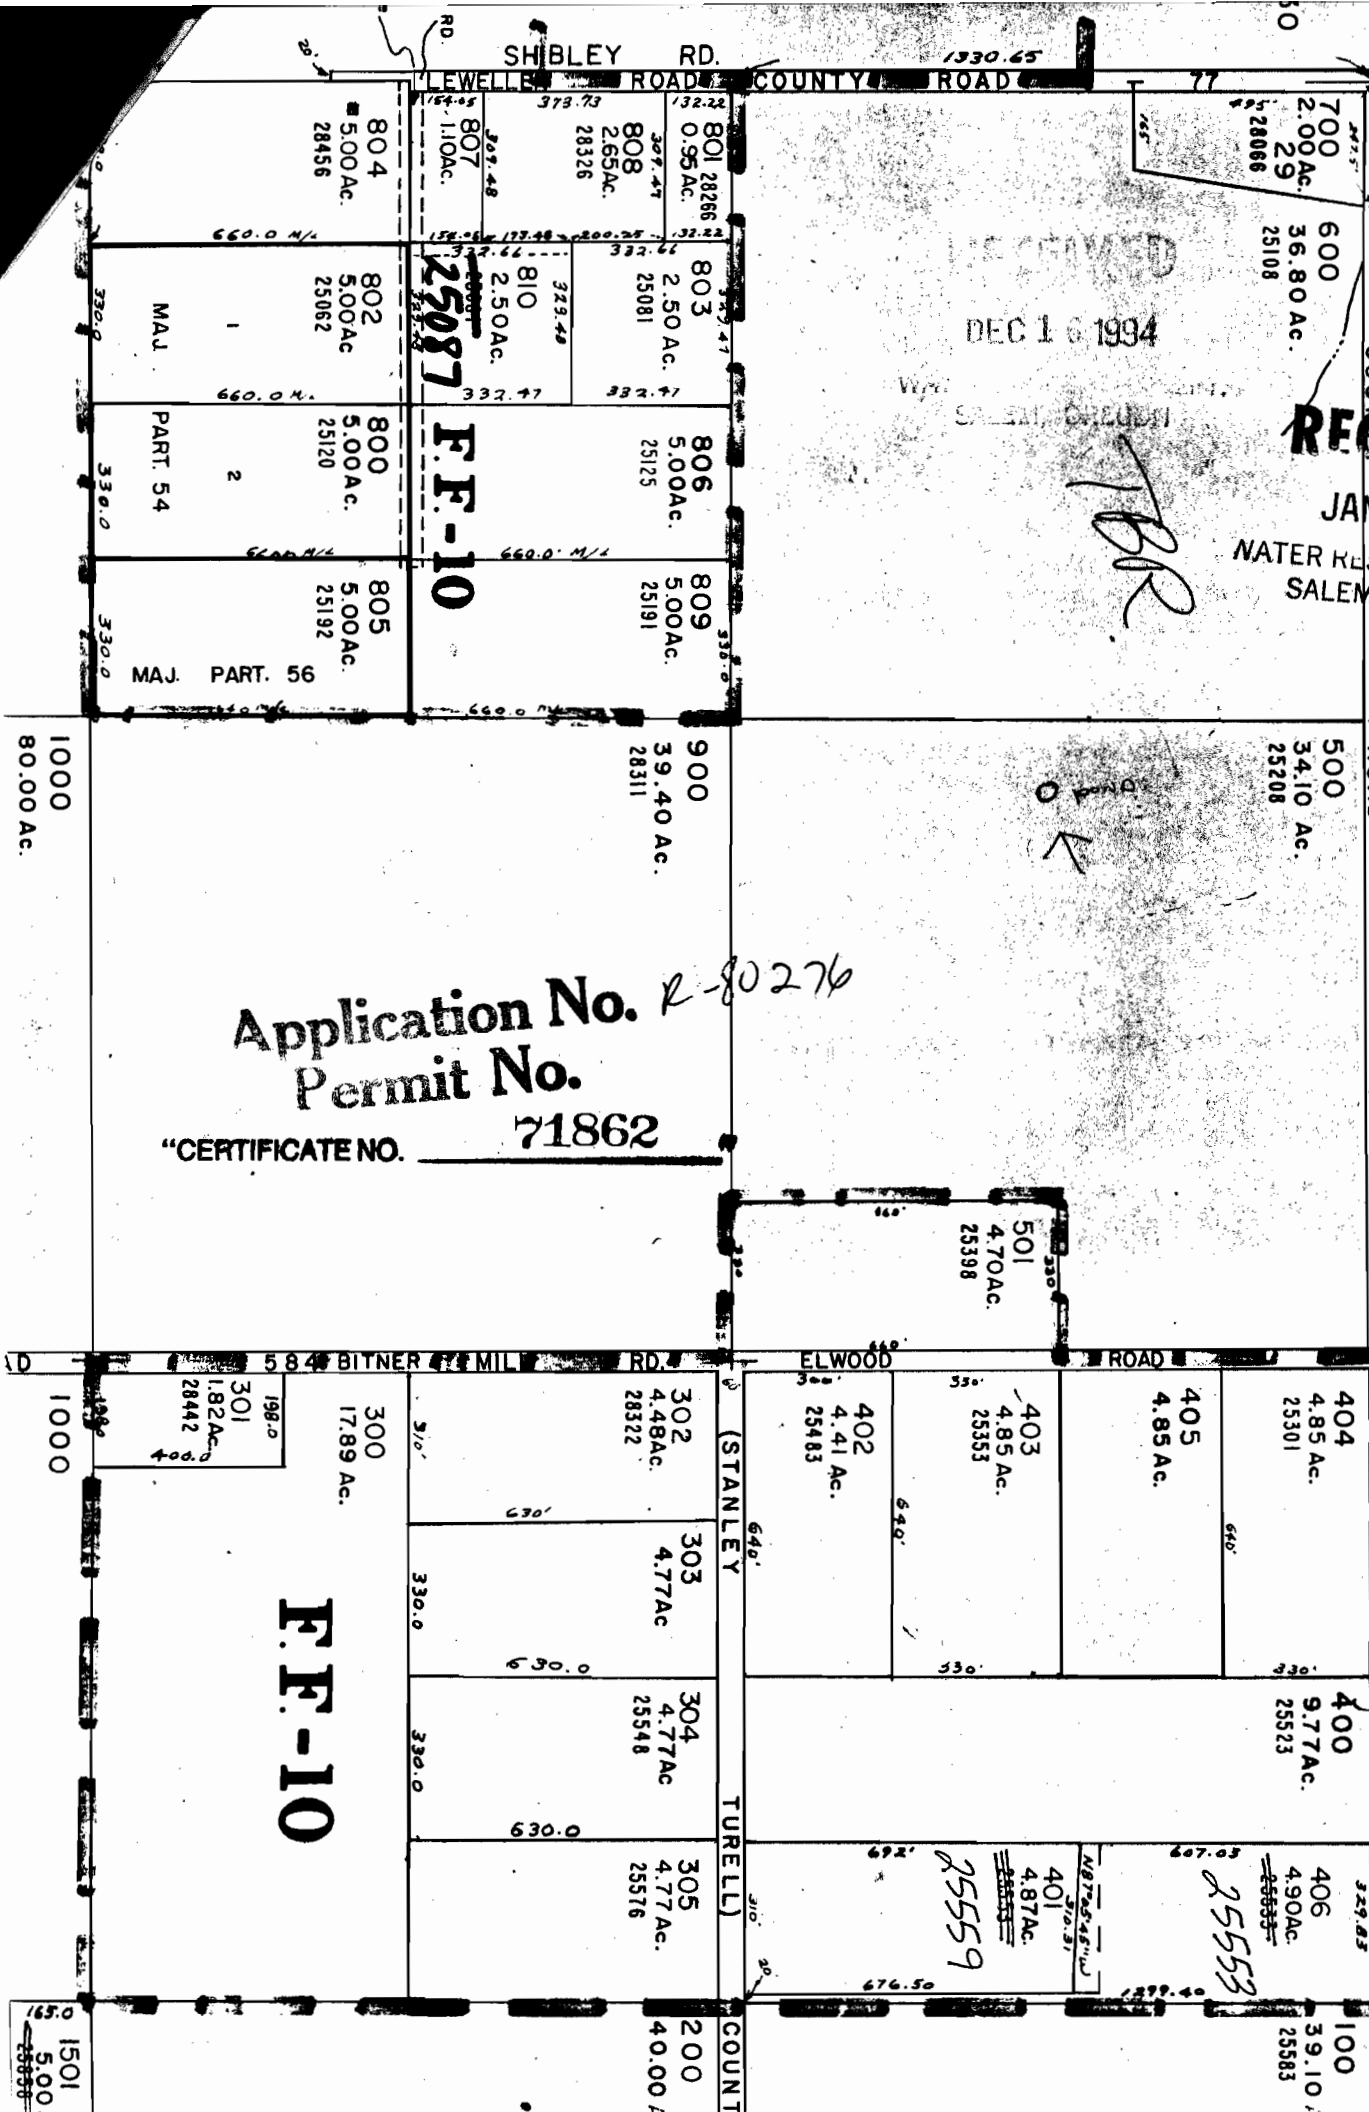

Application No. R-80276
"CERTIFICATE NO. 71862"

F.F.-10

RECEIVED
JAN 3 1995

SEE MAP 4 4E 20