

R 80x92  
1-1-93  
1615  
Jumpoff LP  
CR

5 T35S R5W W.M.

35 5 5

dated 6-22-86


JOSEPHINE COUNTY

HB 2153

DEC 27 1994

1" = 400

SEE MAP 34 5

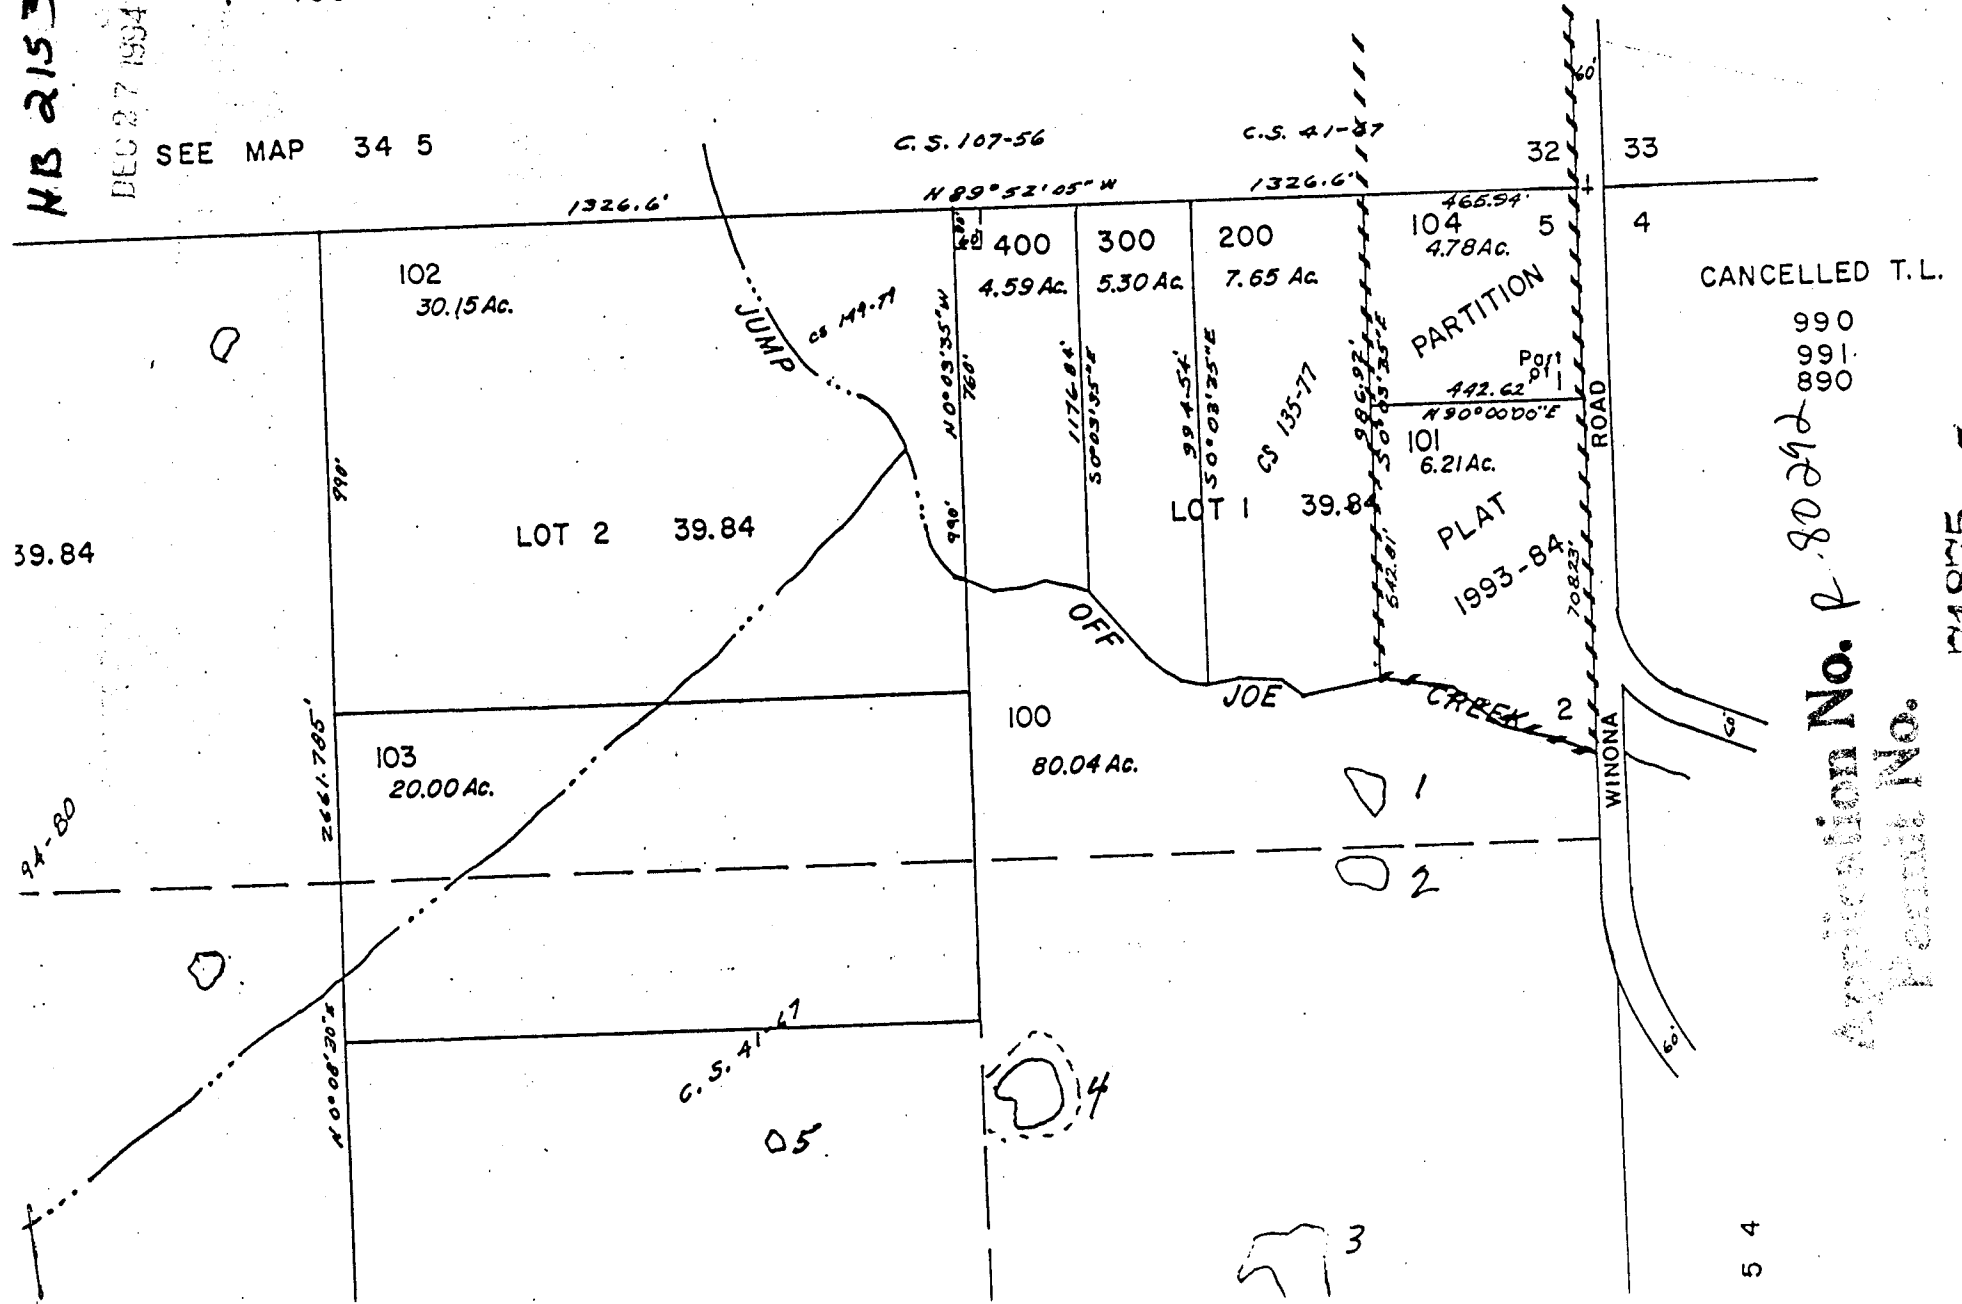

CANCELLED T.L.  
990  
991  
890

Application No. P-80292  
Permit No.

CERTIFICATE NO. 71875

5 4