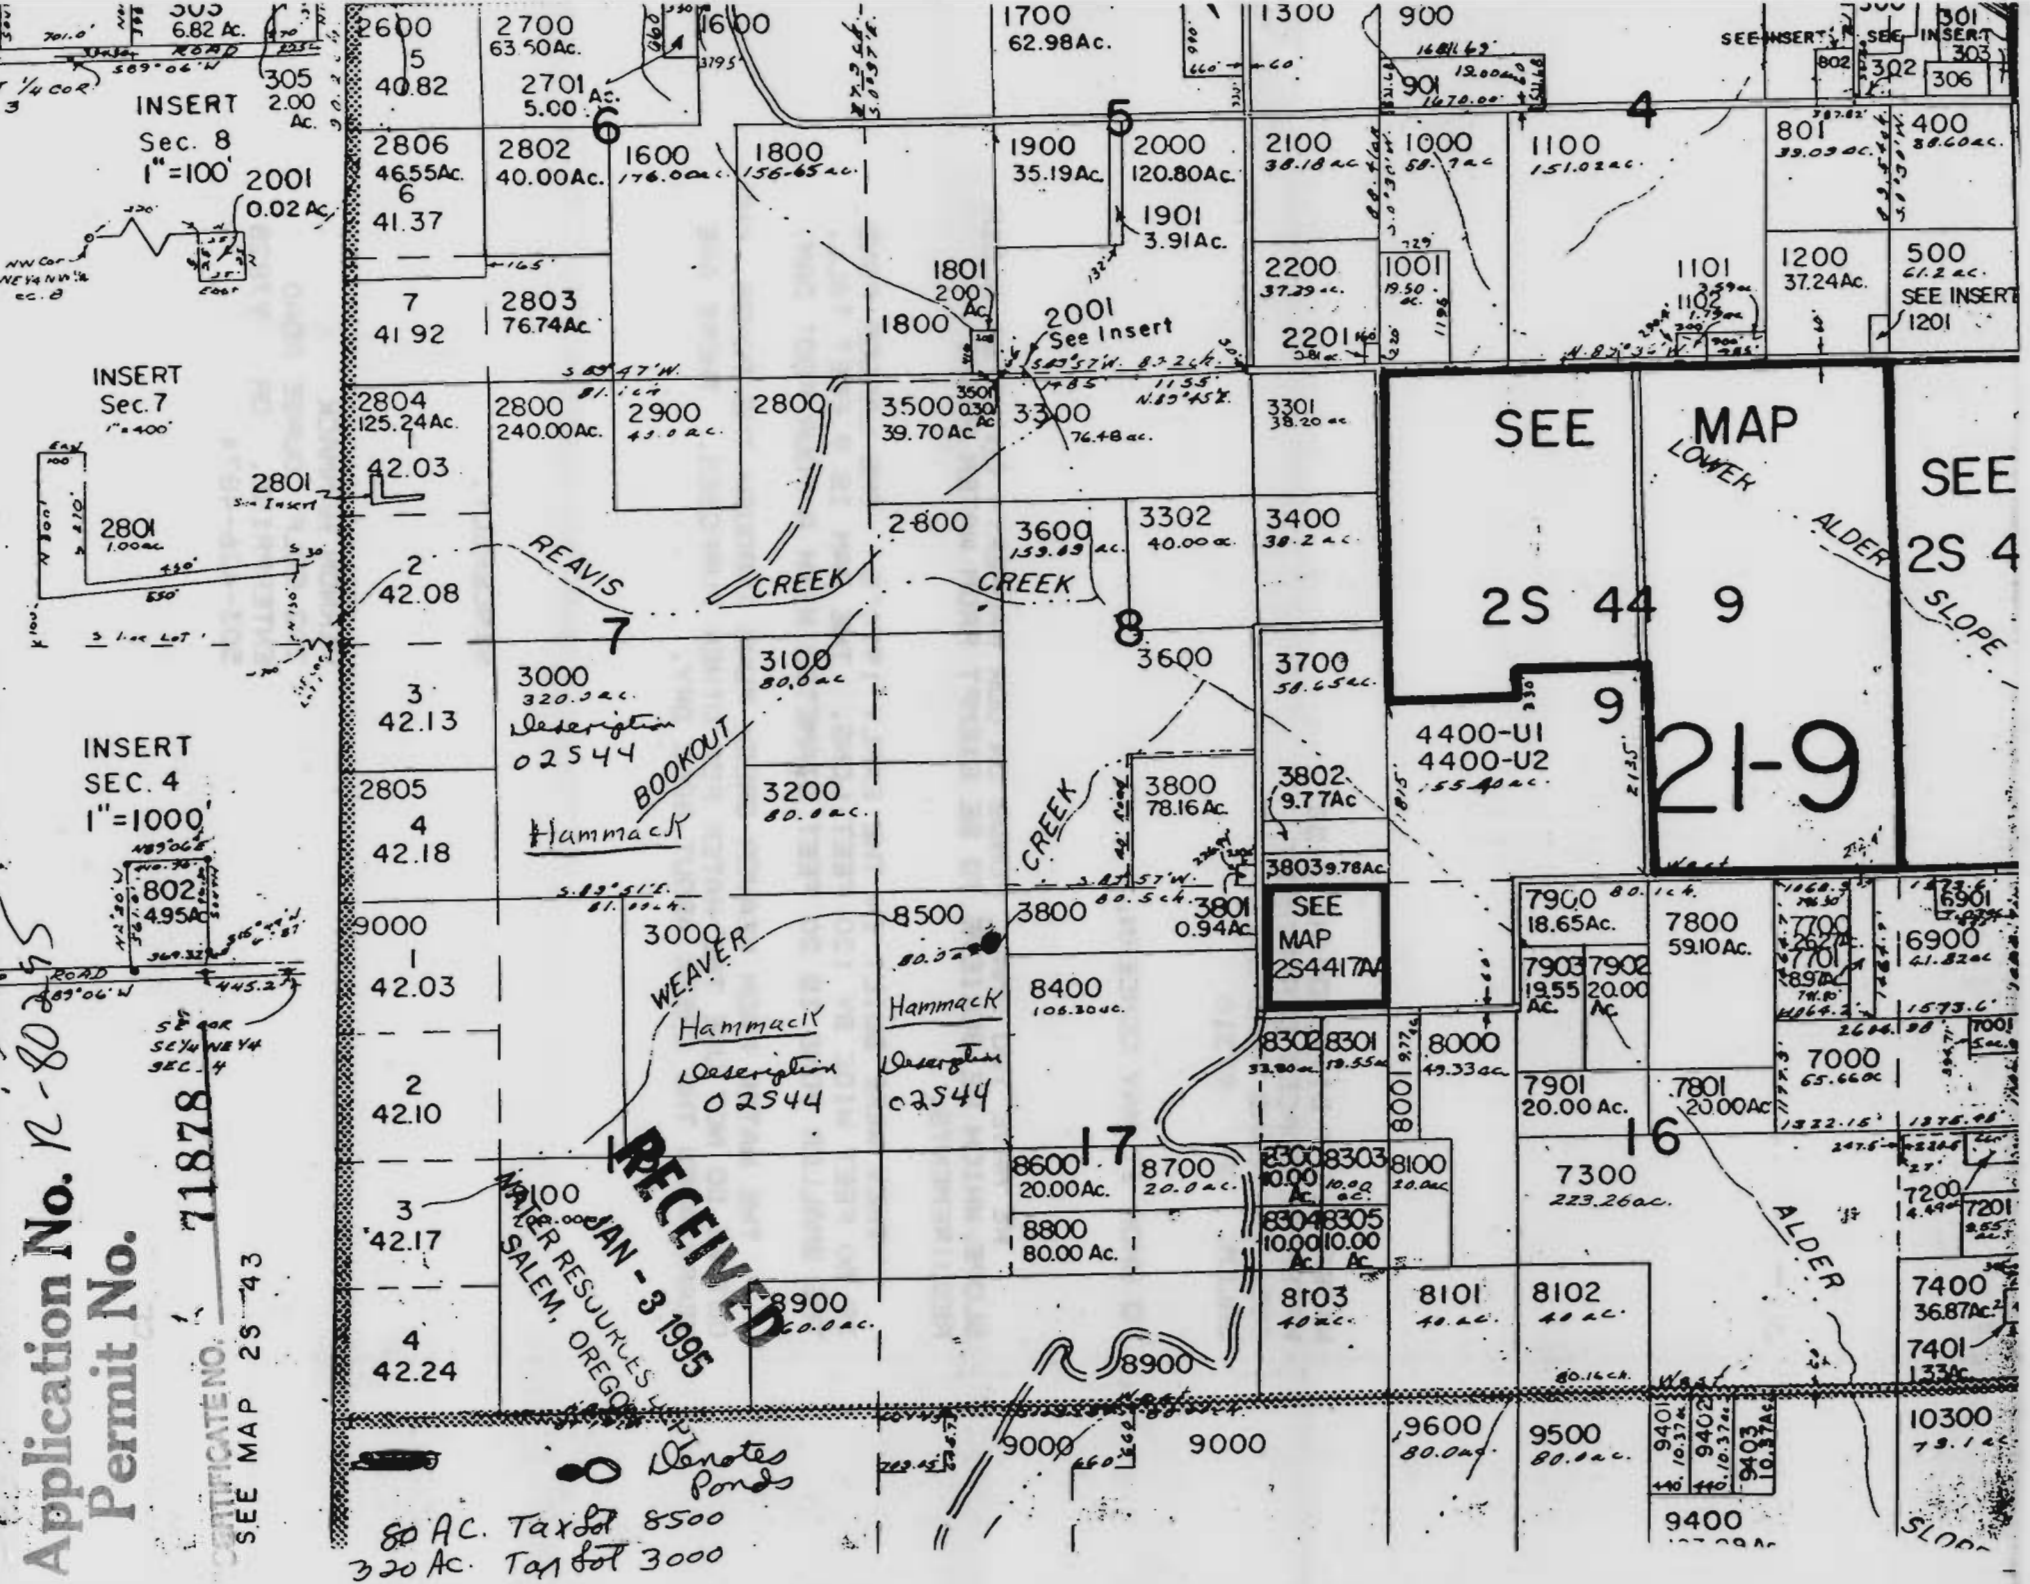

INSERT
Sec. 8
1"=100'
INSERT
Sec. 7
1"=400'
INSERT
SEC. 4
1"=1000'
SEE MAP 2S 4 3
SEE MAP 2S 4 4 9
SEE MAP 2S4417AA
SEE MAP LOWER ALDER SLOPE
2S 4
21-9
REAVIS CREEK
BOOKOUT CREEK
WEAVER CREEK
ALDER SLOPE
Hammack
Description 02544
RECEIVED
JAN - 3 1995
WATER RESOURCES
SALEM, OREGON
Denotes Ponds
80 Ac. Tax Lot 8500
320 Ac. Tax Lot 3000
Application No. 12-80365
Permit No. 71878
CERTIFICATE NO.