


T-145 R-32 E W.M. SEC. 5 (CORRECTION SECTION)

NE

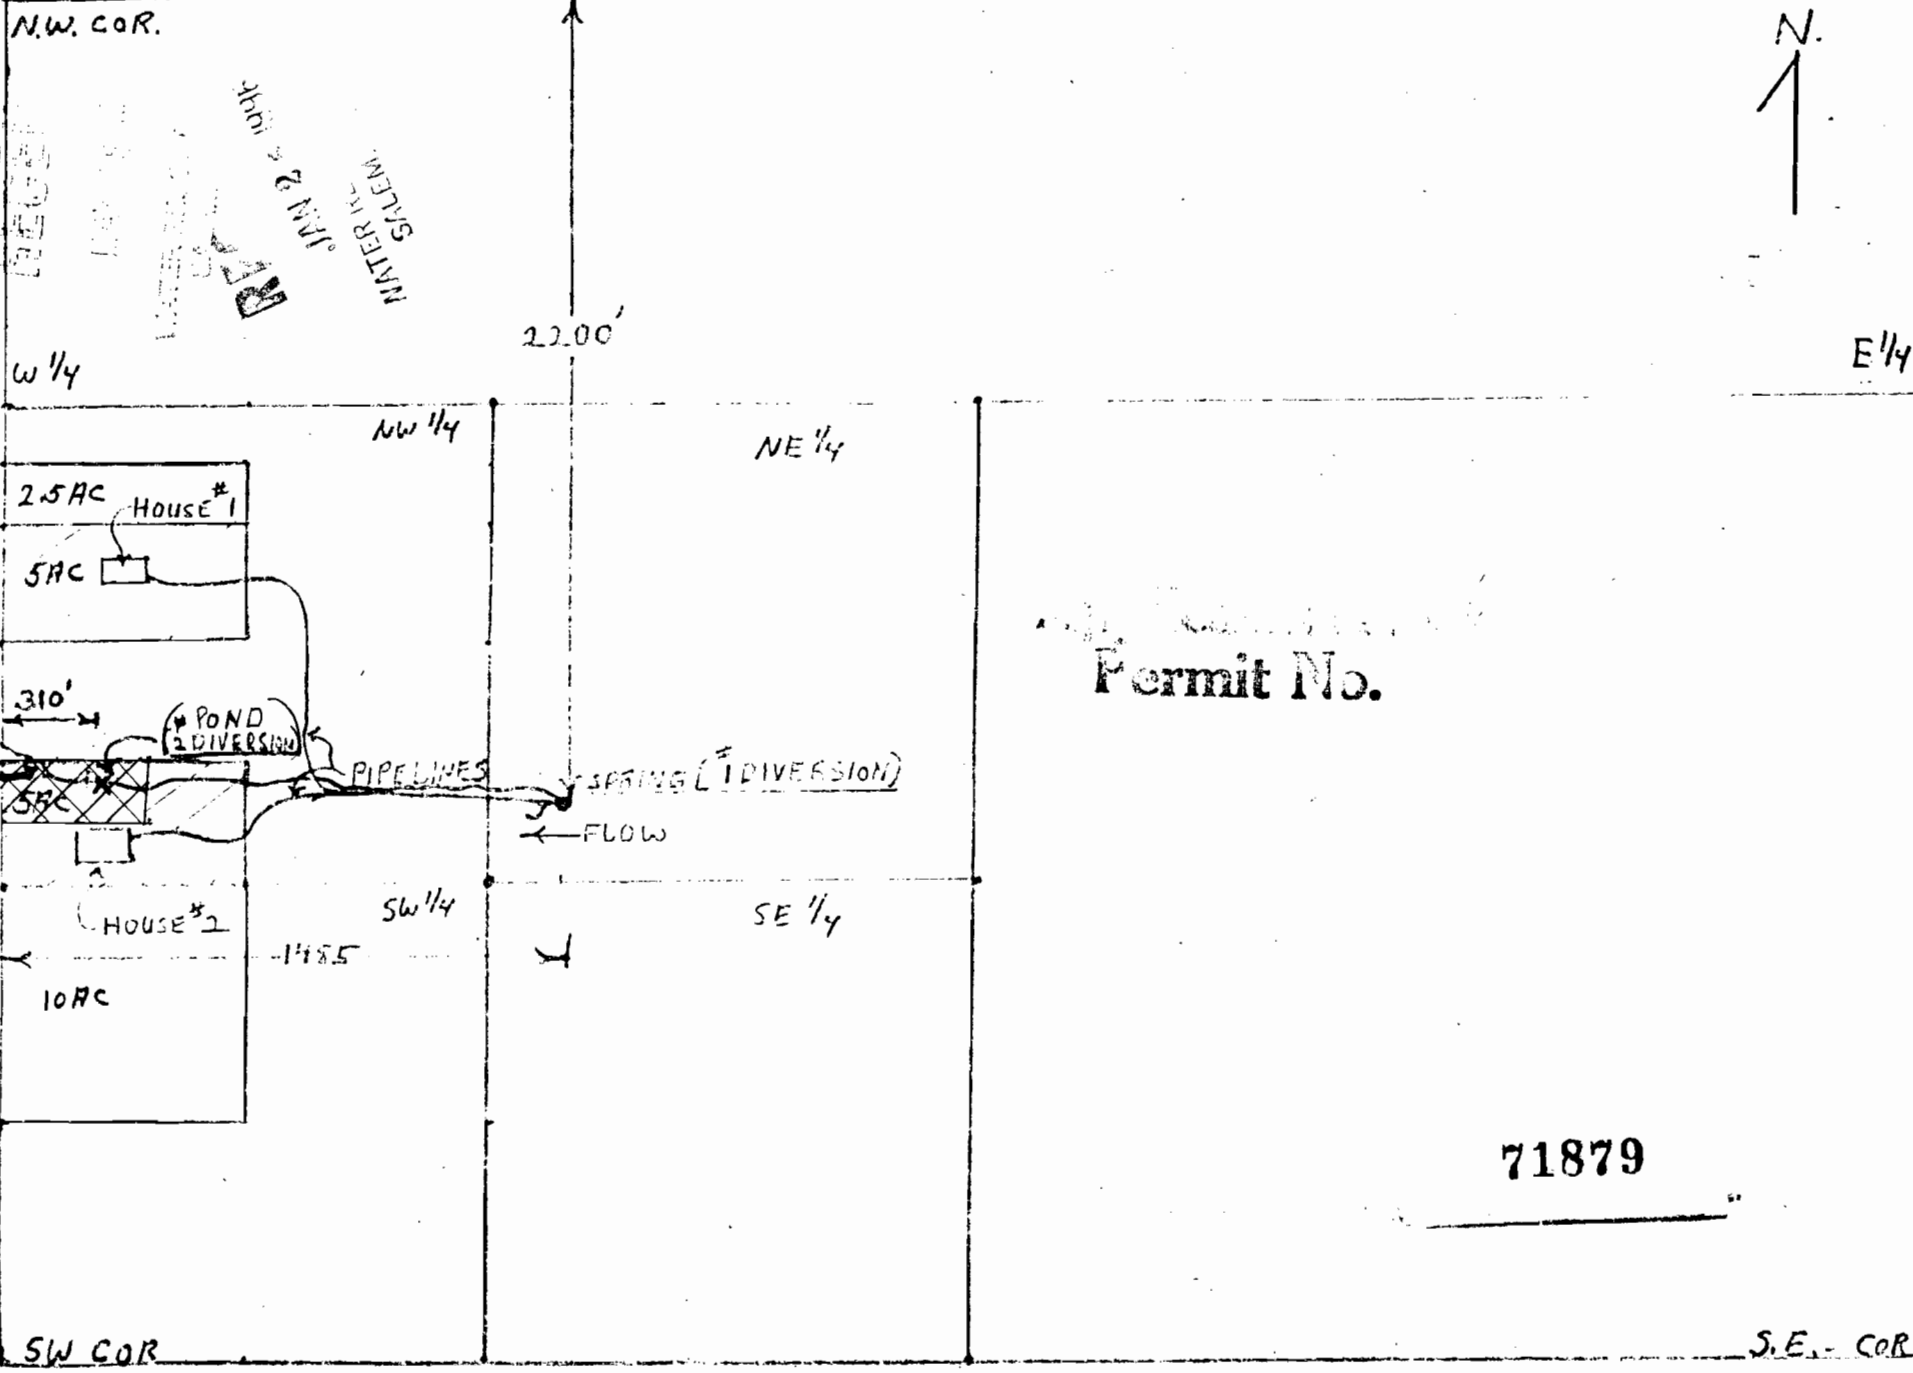

DEEDED SPING ACCESS RECORDED GRANT CO. BOOK 133, PGS. 993 + 994

SCALE: 10" = 1 ML

CROSS HATCH = IRRIGATED PARCELS