

Jimbrown
USGS Quad


R 454

Application No. E-80308
Permit No. _____

N
A
T
I
O

RECEIVED
FEB 2 1994
WATER RESOURCES
SALEM, OREGON

RECEIVED
FEB 14 1996
WATER RESOURCES
SALEM, OREGON

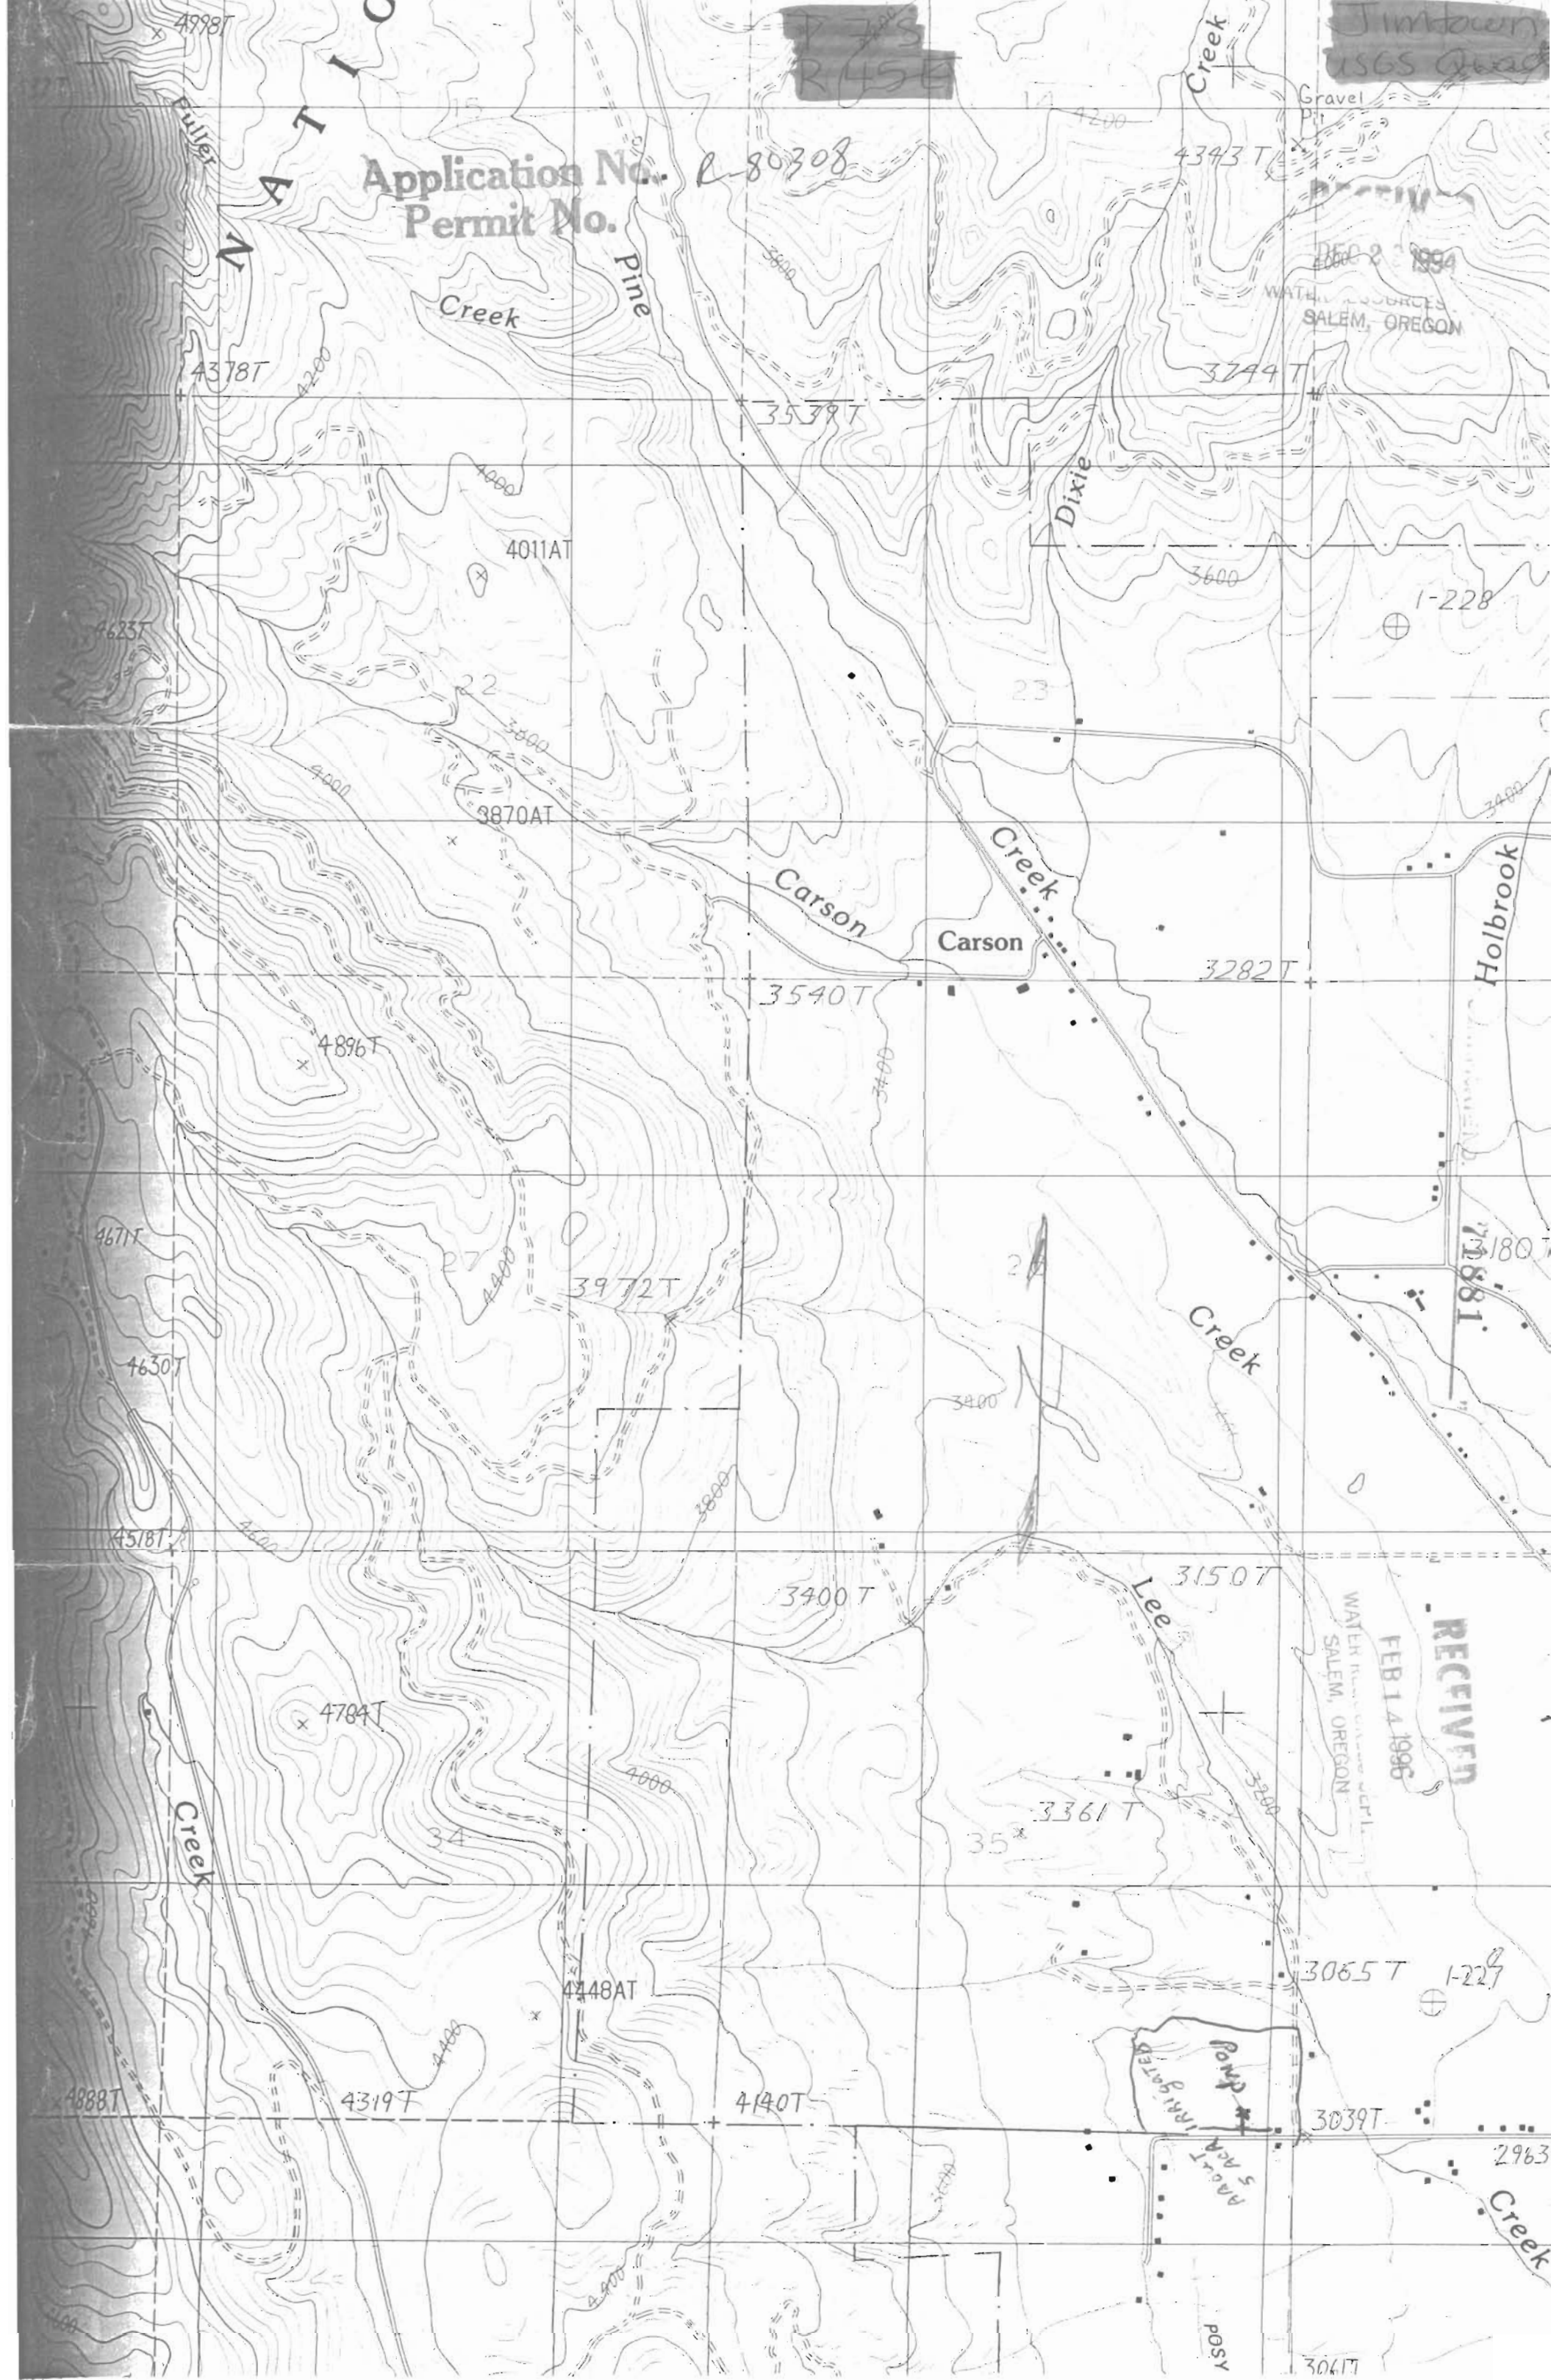

Holbrook

7188.1

1-227

2963

POSS

3041T

POSS
NORTH
DIXIE

Creek