


SCALE 1:5000

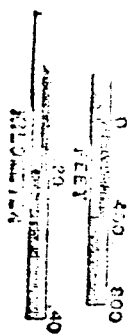

Application No. R-80309
Permit No.

"CERTIFICATE NO. 71882"


JOSEPHINE COUNTY

1"=400'

SEE MAP 34 6 17

SEE MAP 34 6 9

SEE MAP 34 6 15

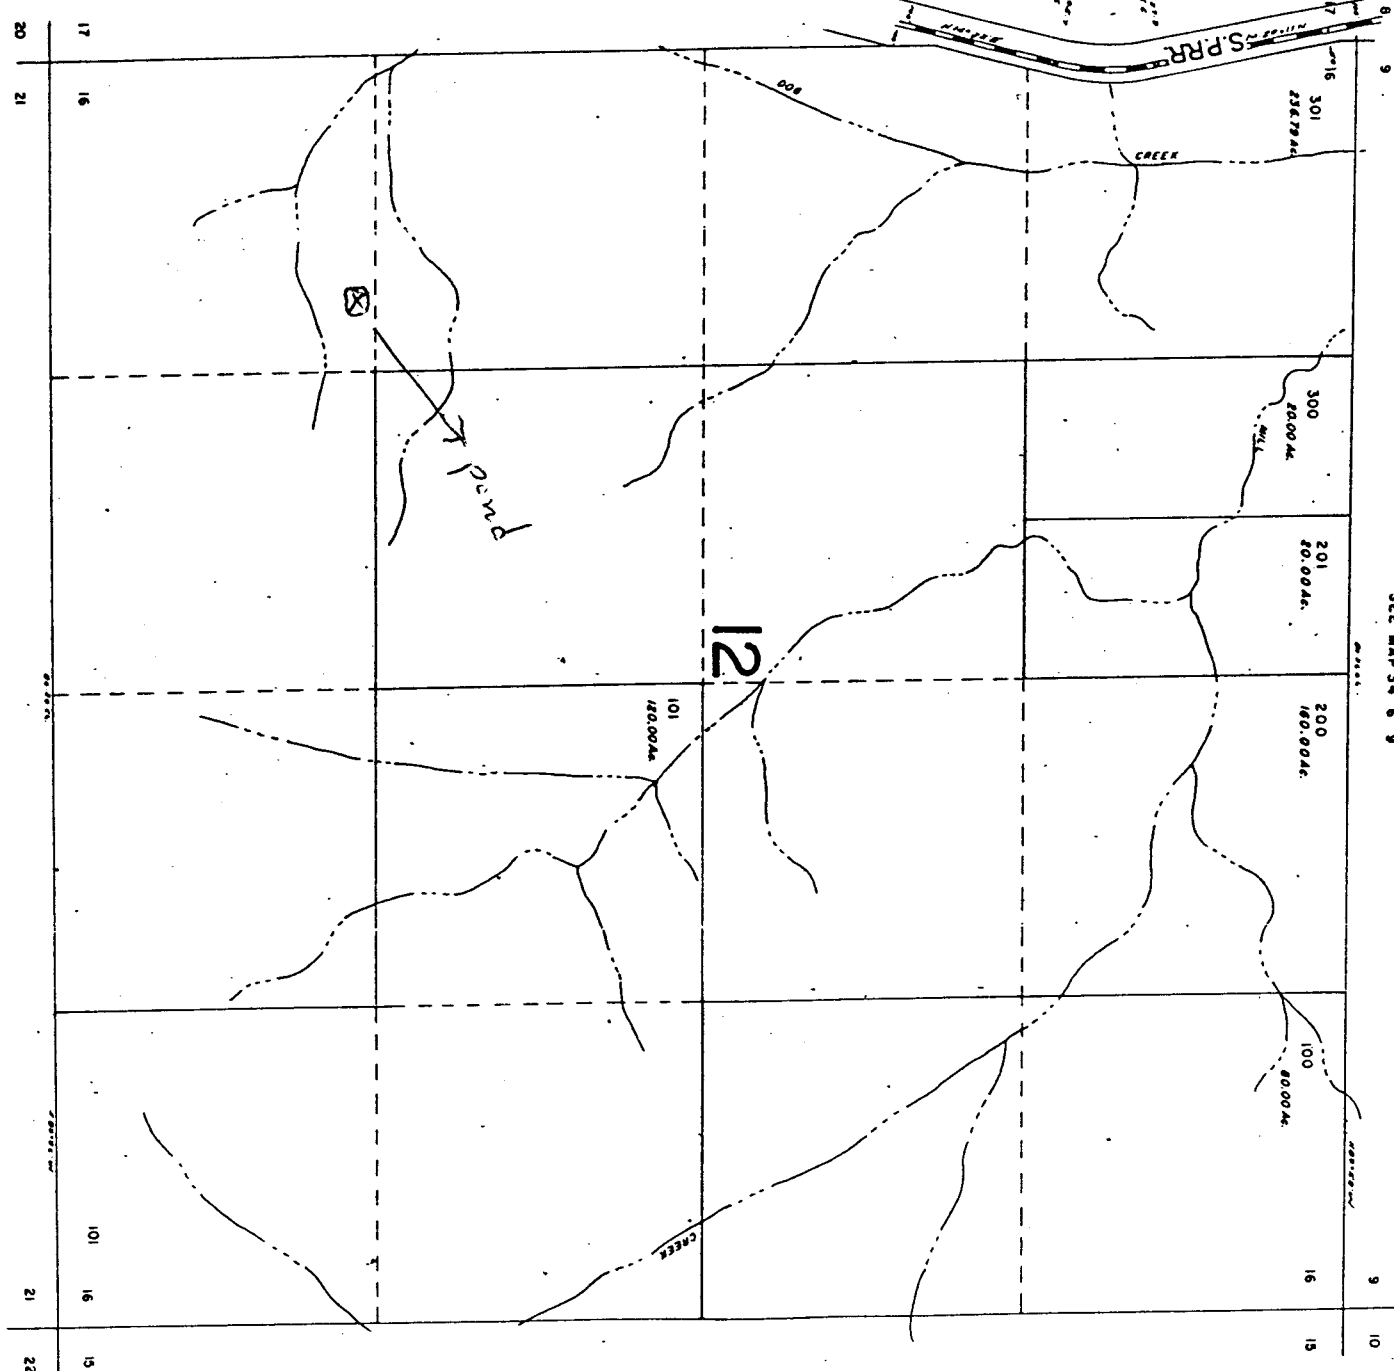

WATER RESOURCES DEPT
SALEM, OREGON

MAY 15 1995

RECEIVED

RECEIVED