

Application No. R-80313
Permit No.

17 07 27


RECEIVED

DEC 27 1994

WATER RESOURCES DEPT.
SALEM, OREGON

71886

See Map 17-07

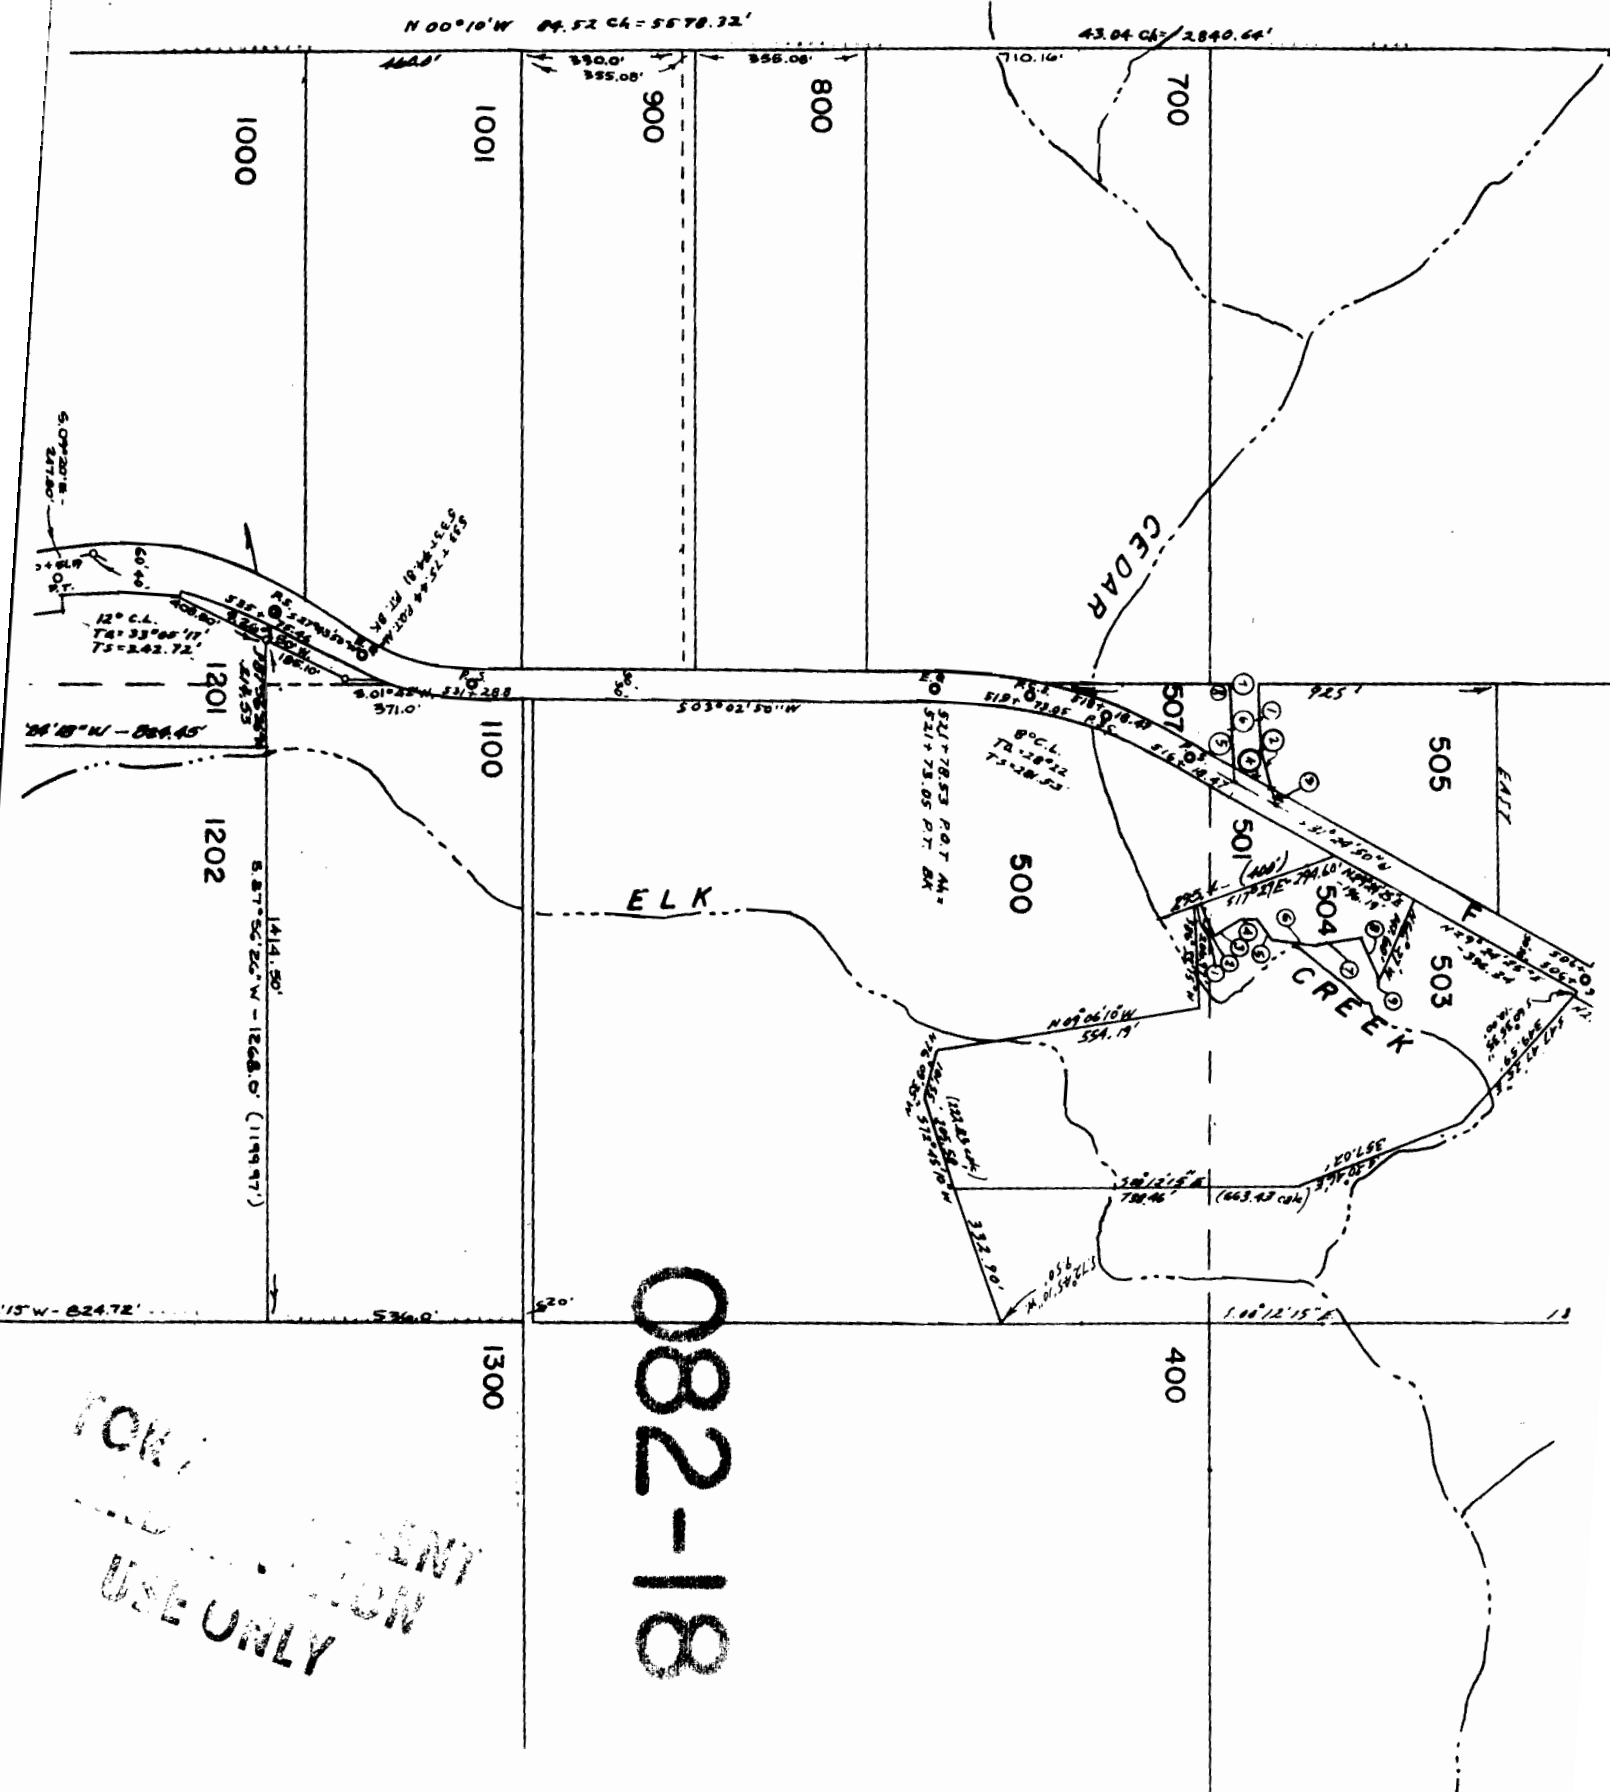


71886

T.17S. R.7W. W.M.

RECEIVED

DEC 27 1994

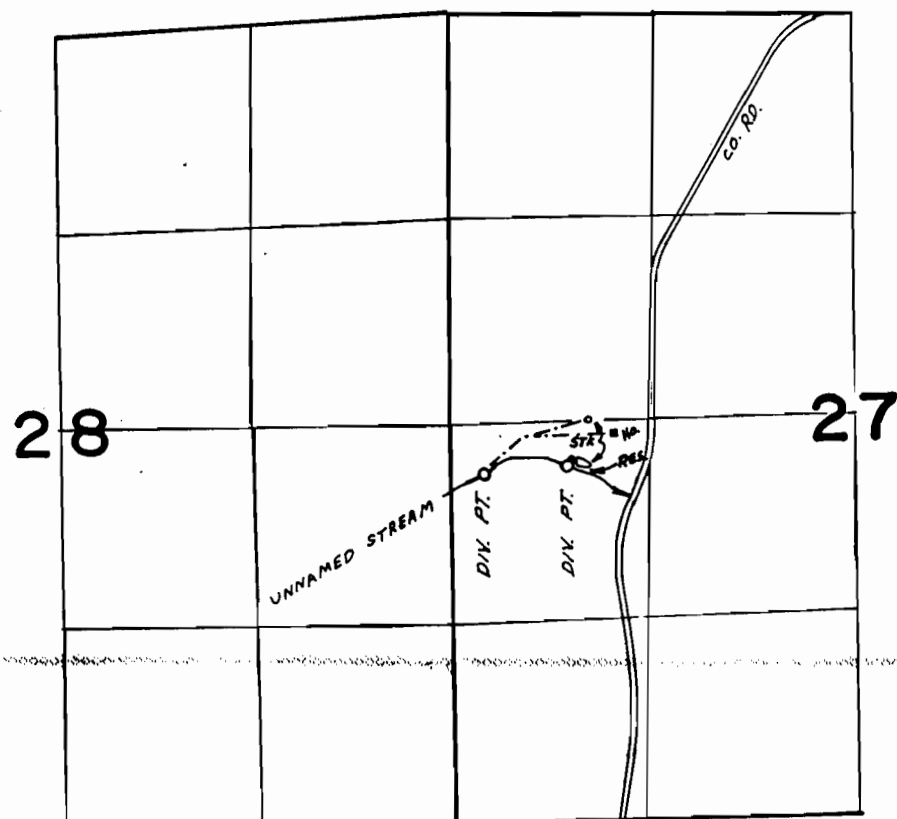WATER RESOURCES DEPT.
SALEM, OREGON

W. DIV. PT. LOC. 340'S. & 220'E.; E. DIV. PT. LOC. 280'S. &
800'E. FROM W 1/4 COR. SEC. 27.

Application No. R-80313

Permit No.

FINAL PROOF SURVEY
UNDER

Application No. 45713... Permit No. 34282...
IN NAME OF

ROBERT E. STRUNK

Surveyed MAY 4, 1976, by L.H. NUNN