


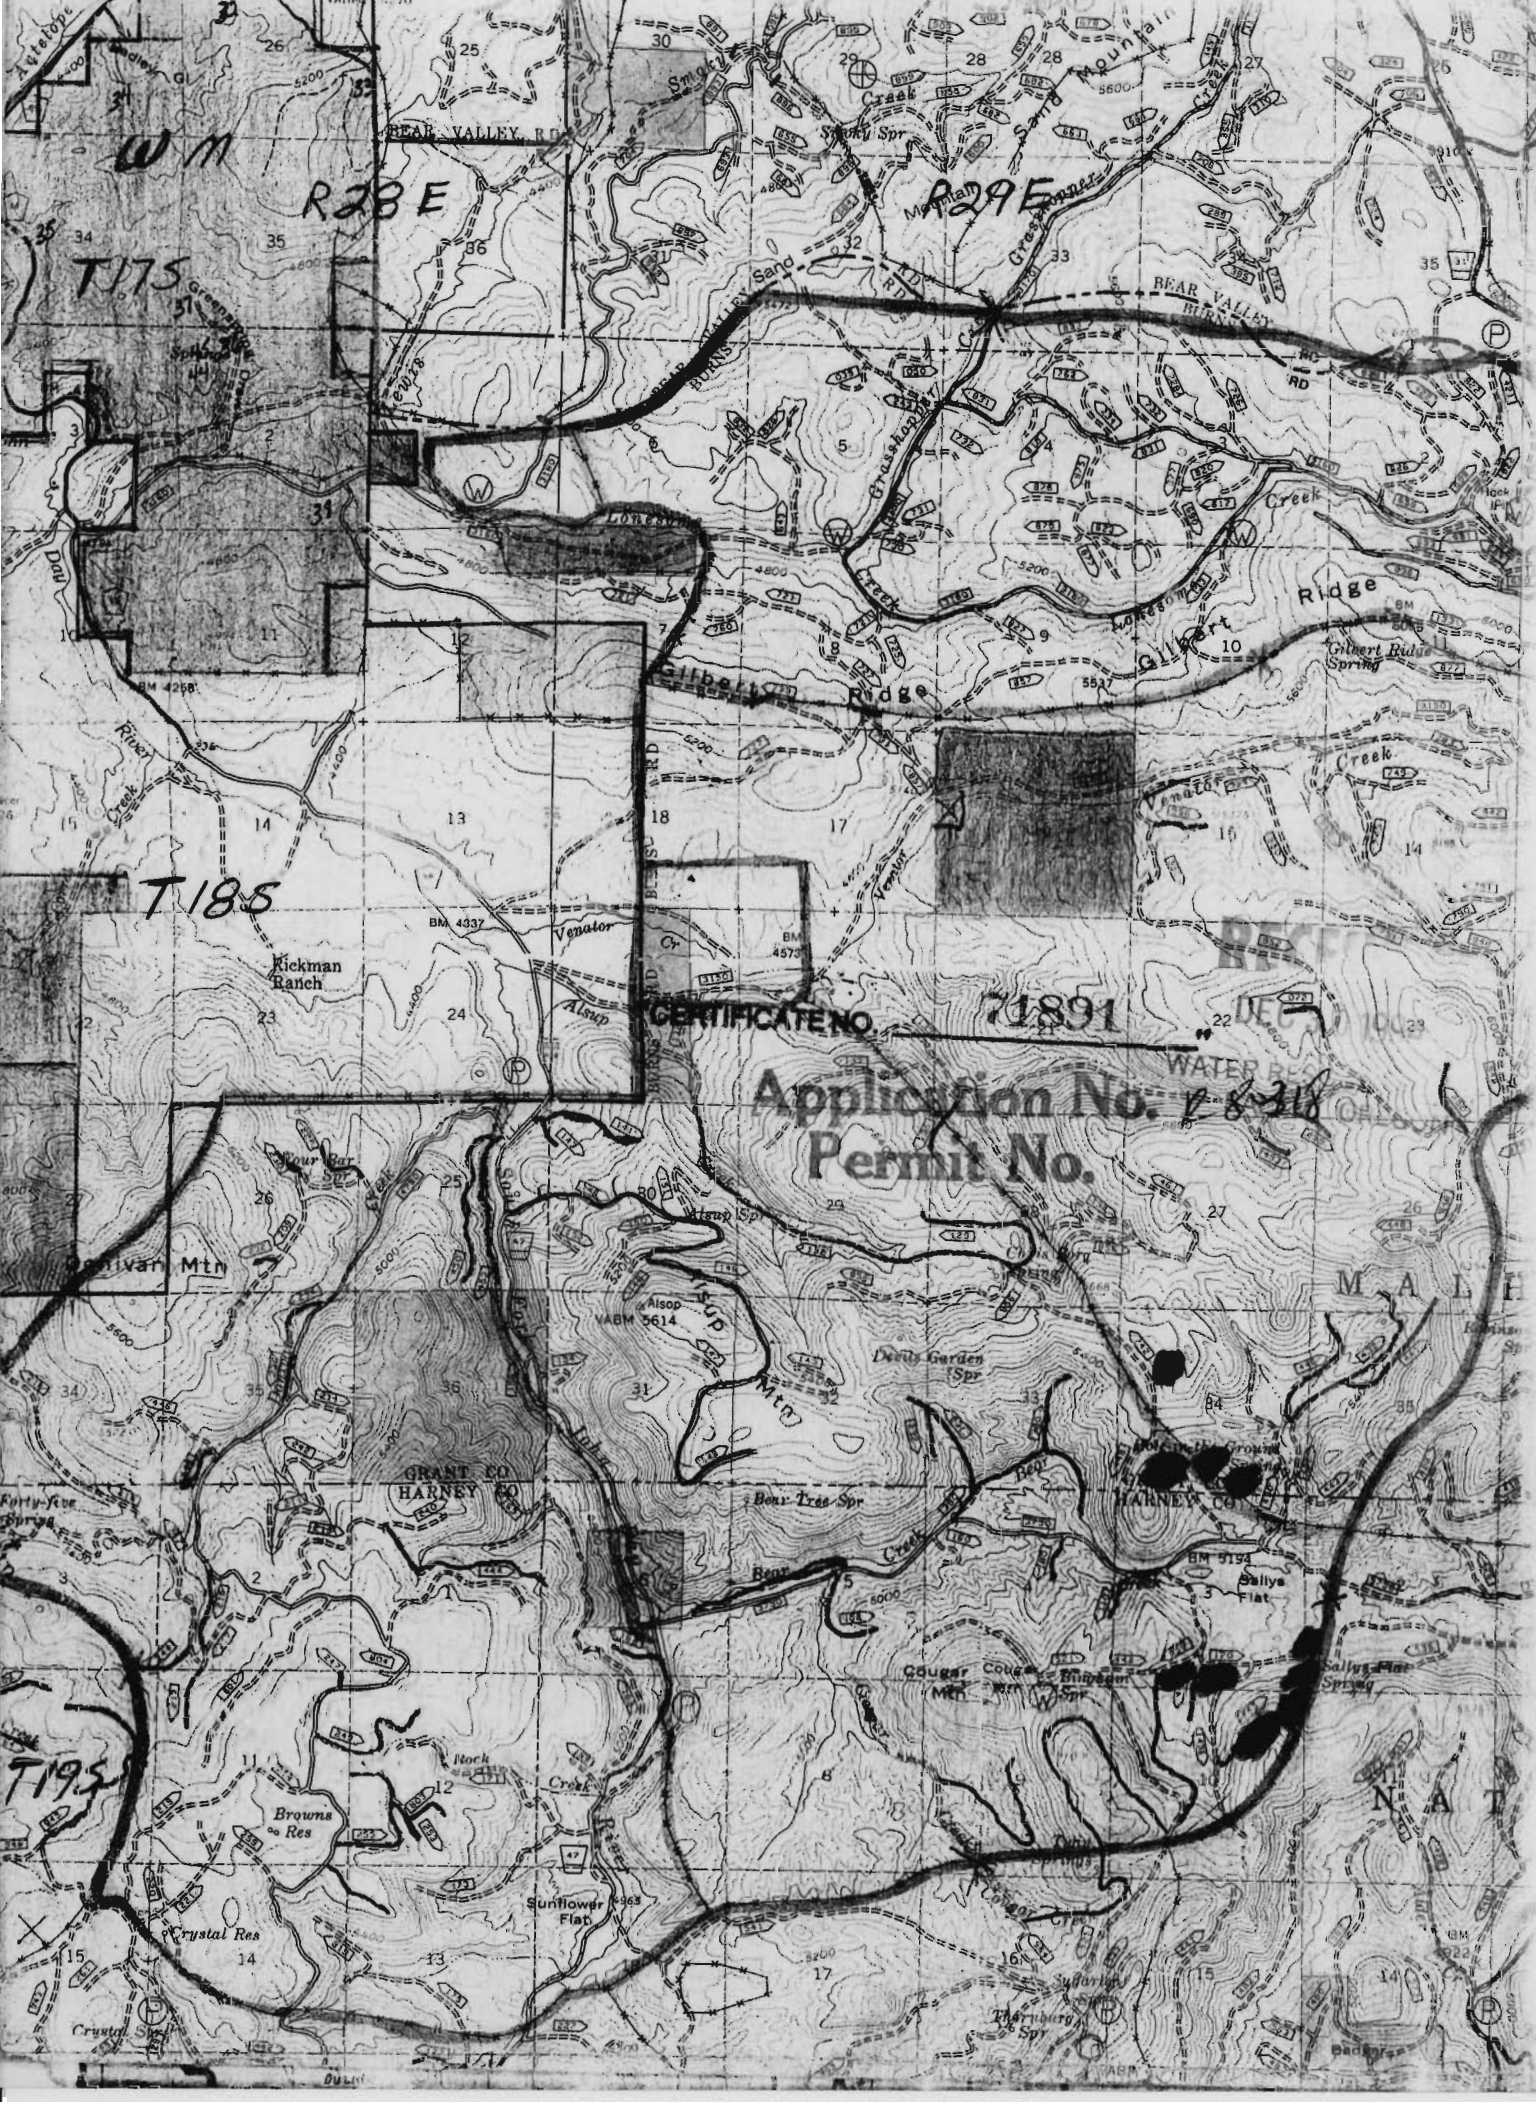

W M

R28E

R29E

T175

T185

T195

CERTIFICATE NO.

71891

Application No. 8-318

Permit No.

GRANT CO
HARNEY

HARNEY CO