


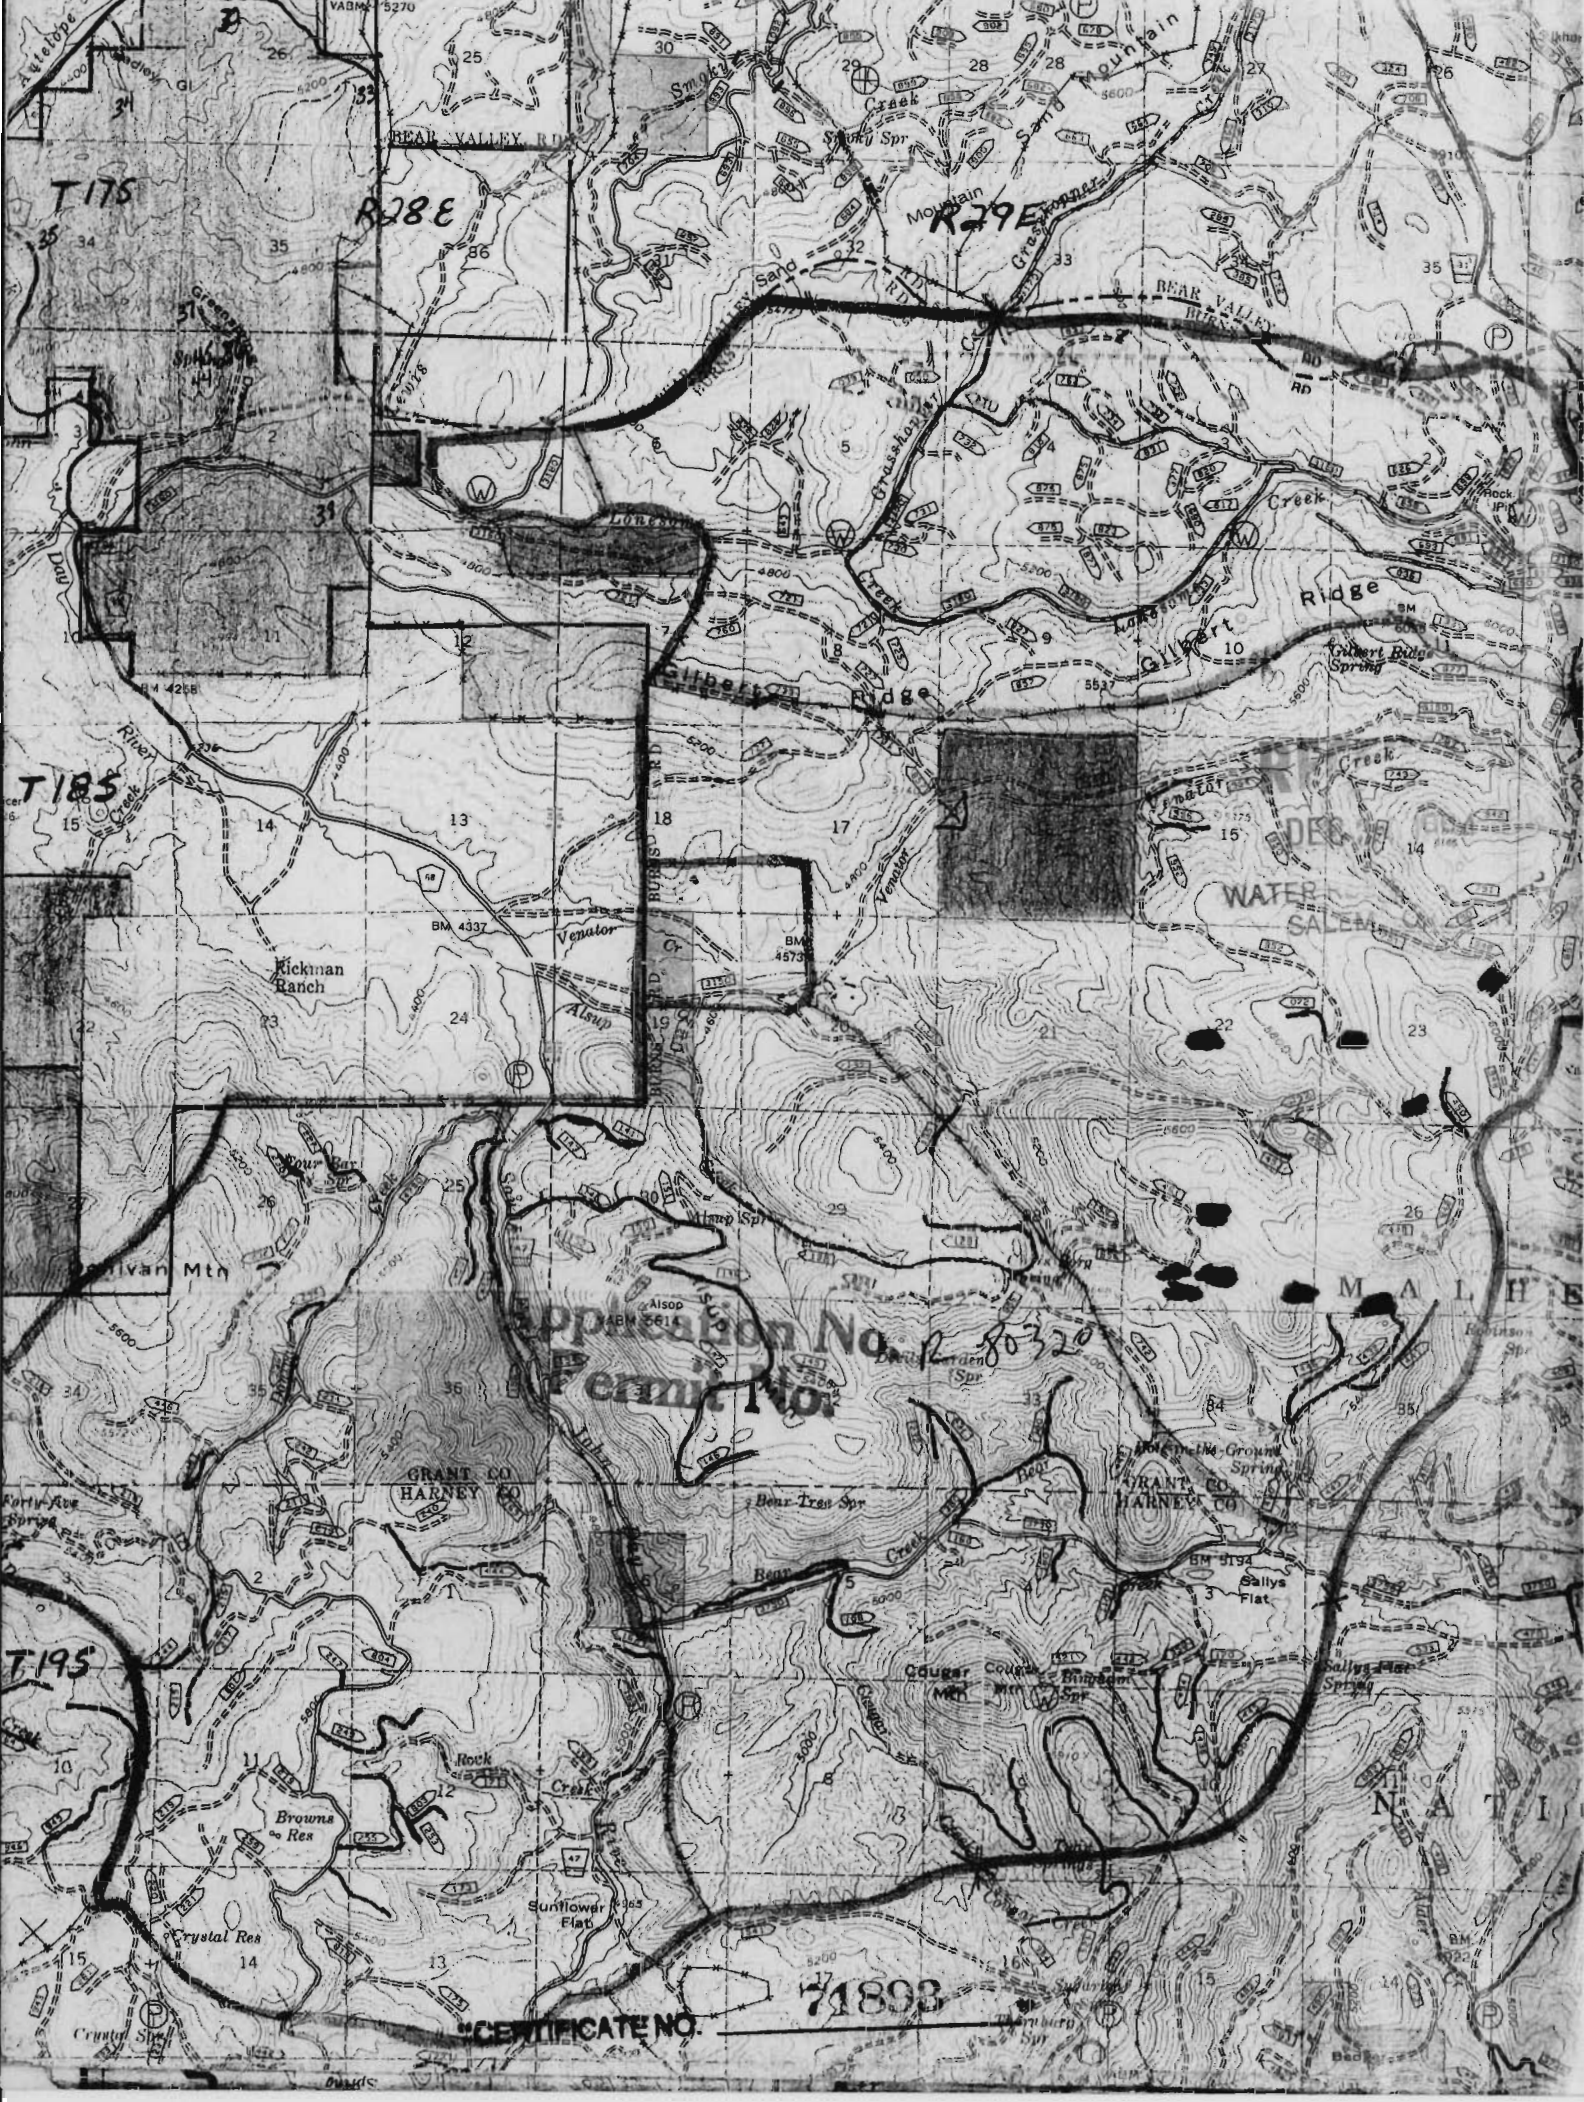

T175

R28E

R29E

T185

T195

Application No. 80320
Permit No.

71893

CERTIFICATE NO.