

RECEIVED


JAN - 3 1995

WATER RESOURCES DEP.
SALEM, OREGON

2-3

"CERTIFICATE NO. 71895"

100
Application No. R-80322
Permit No.

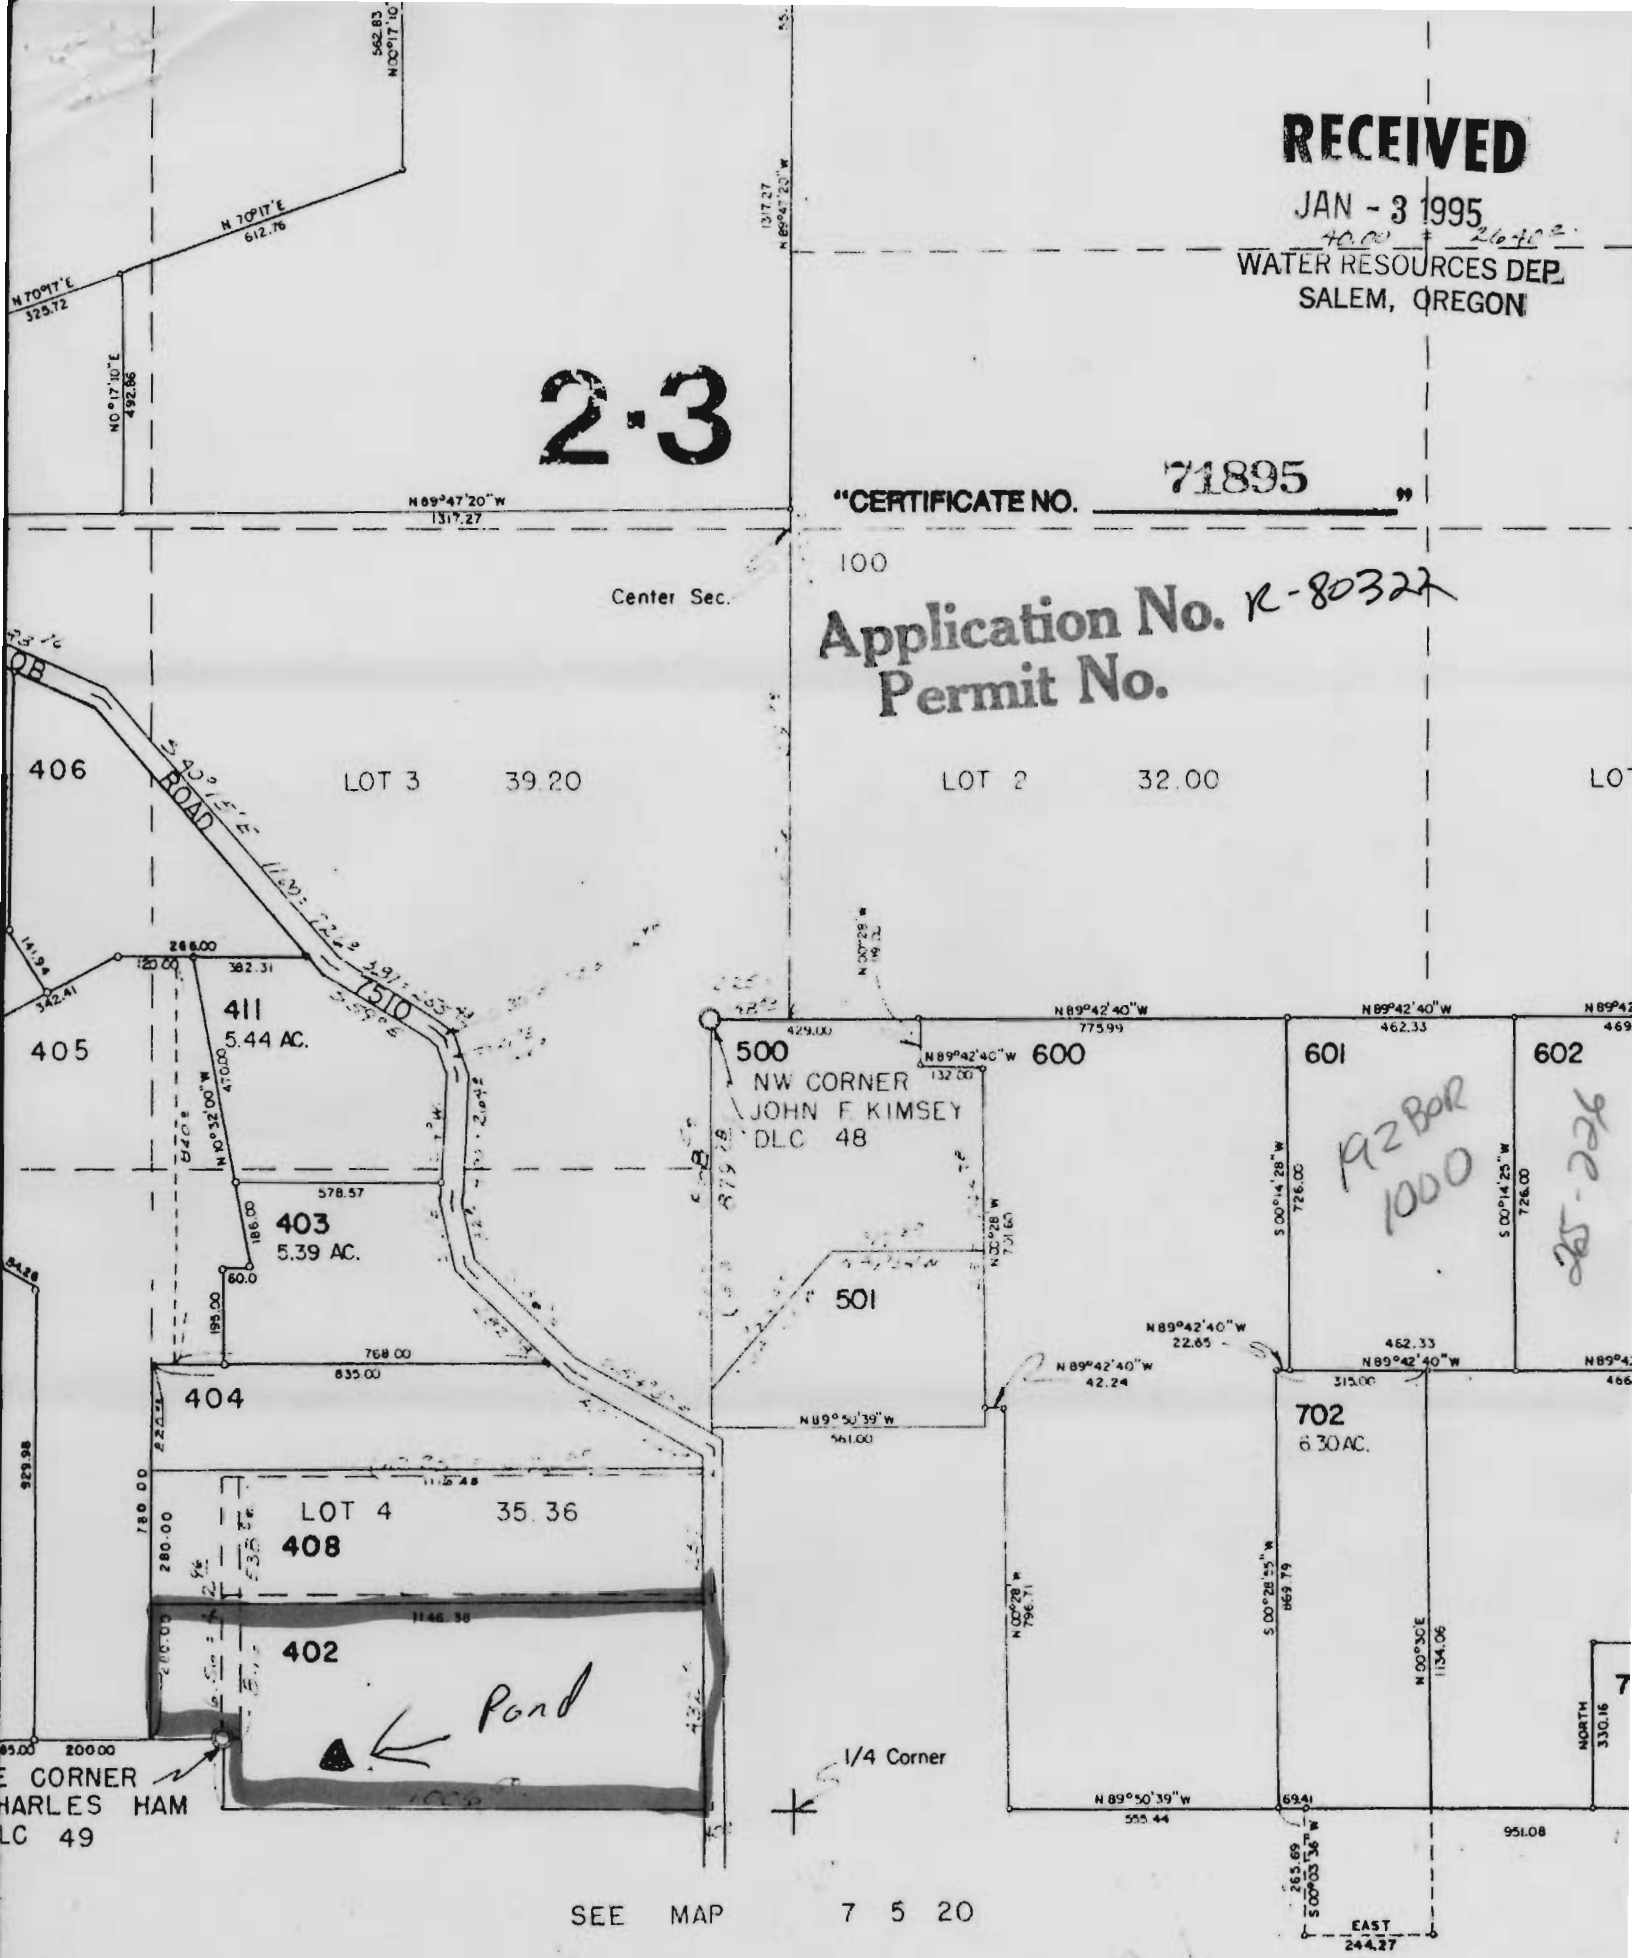

SEE MAP

7 5 20

EAST
244.27

NORTH
330.16

92 BOR
1000

92c-58

1/4 CORNER
CHARLES HAM
DLC 49

1/4 Corner

NW CORNER
JOHN F KIMSEY
DLC 48

Pond