

BENTON


SEE MAP 10 6 29

SCALE 1:9600.



Application No. R-80326
 71899
 "CERTIFICATE NO."

SEE MAP 10 6 31

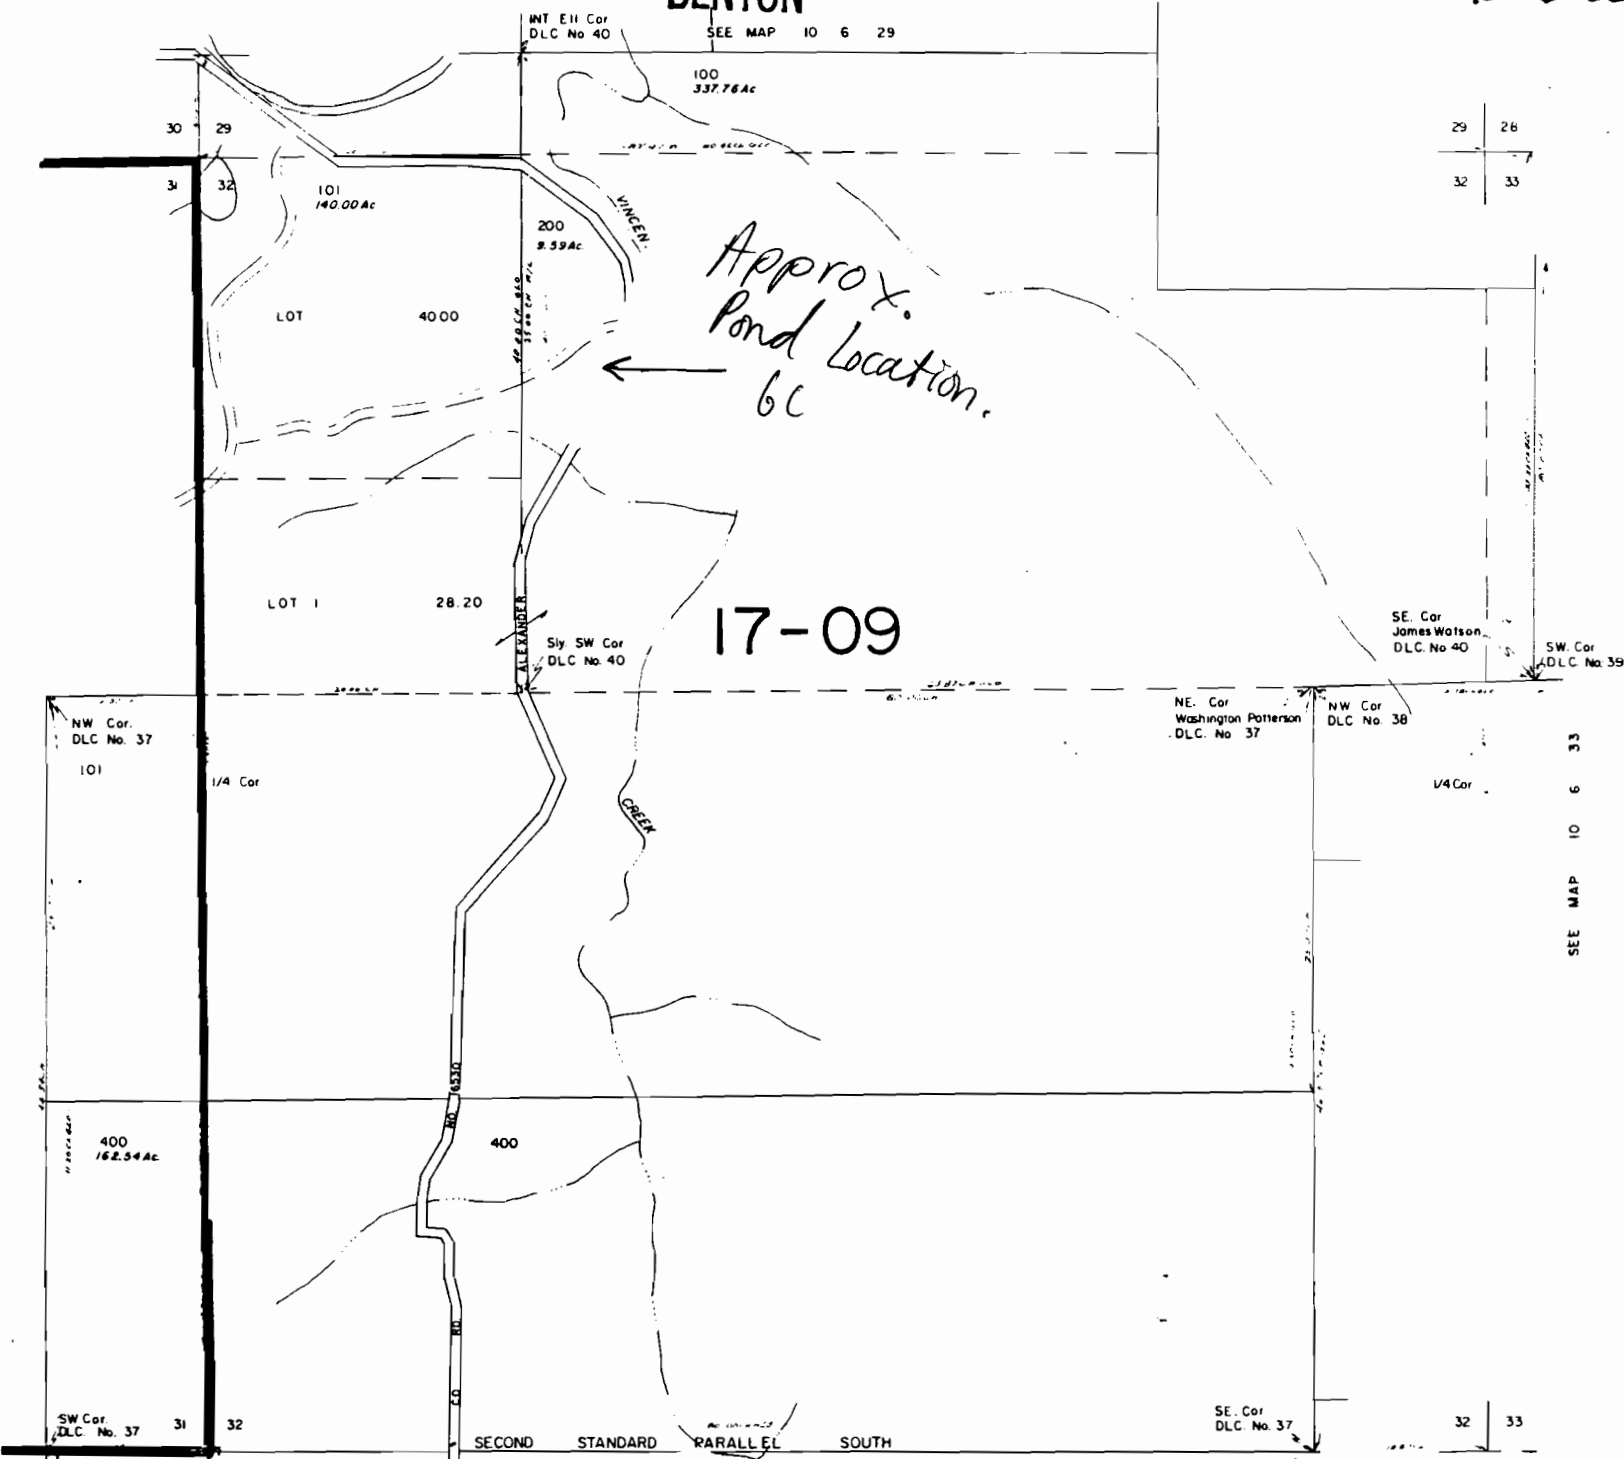

17-09



SEE MAP 11 6 6

SEE MAP 11 6 5

SEE MAP 10 6 33