


SW 1/4 of SE 1/4 of Sec. 6.

97

211 R 3 E

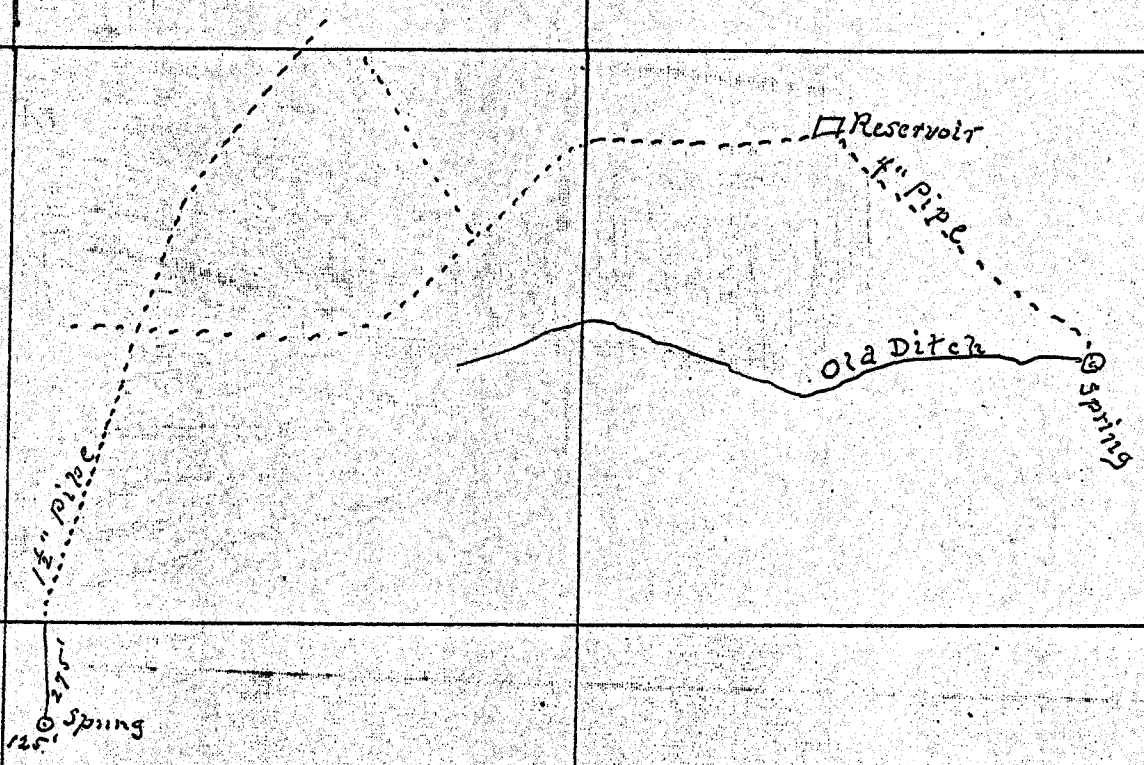

7
Center.

App 258
Per 97