


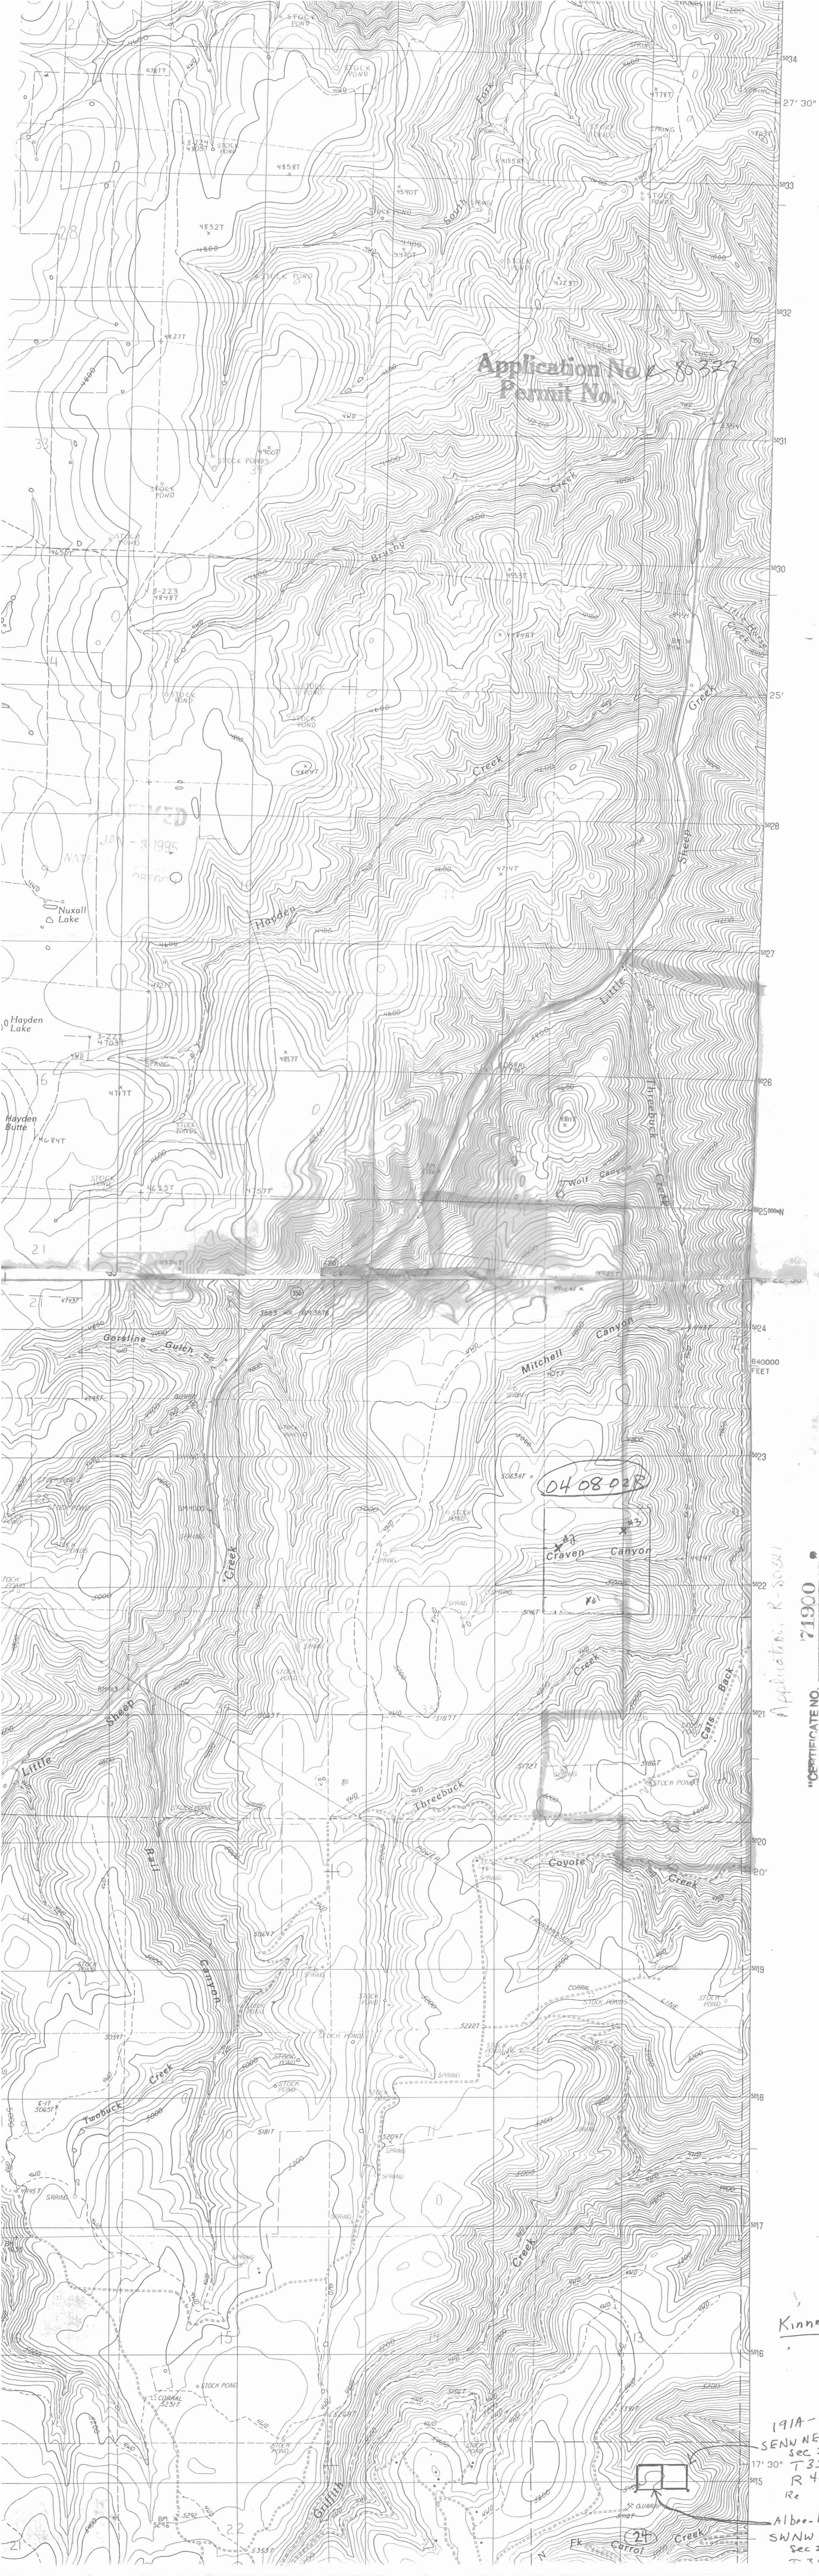

Application No. 80327
Permit No.

04 08 02 B

Application R-5021
71900
"CERTIFICATE NO."

191A-
SENNW
Sec. 3
T3
R4
Re
Albee-
SWNW
Sec. 2
T3
R4